

SITE PLAN

Consolidated for Lake County, Ohio

for: Dave Wedding
CLIENT OWNER

ADDRESS STREET CITY ZIP

SUBDIVISION LOT TRACT
Lanaster Ridge 2 25

VOLUME PAGE
2 25

PERMANENT PARCEL NO.

CERTIFICATION

THIS PLAT WAS PREPARED BY ME,
AND IS CORRECT TO THE BEST OF
MY KNOWLEDGE.

NAME
TERRELL GESSON
REGISTRATION NO. PS. 6662



LEGEND

- SANITARY MANHOLE
- STORM MANHOLE
- INLET OR CATCH BASIN
- HYDRANT
- EXISTING CONTOURS
- PROPOSED CONTOURS
- EXIST. ELEV. 100.00
- PROP. ELEV. 100.00
- WATER VALVE (GAS)
- WATER METER (GAS)
- AS BUILT ELEVATION
- INDICATES DIRECTION OF SURFACE DRAINAGE

"AS BUILT" CERTIFICATION

I, HEREBY CERTIFY THAT THE CIRCLED GRADES ARE
EXISTING FINISHED GRADES CHECKED IN THE FIELD ON
_____, 9, _____ AND ARE CORRECT TO THE
BEST OF MY KNOWLEDGE

NAME
REGISTRATION NO.

PLAN PREPARED BY



WM. R. GRAY, ASSOCIATES, INC.

REVISIONS	DRAWN BY T.G.C.	CHECKED BY	DATE 17 May 87
SCALE 1" = 30'	PHONE NO. 946-1616	DRAWING NO.	


PRINTED

MAY 19

WILLIAM R. GRAY
ASSOCIATES, INC.

Grading Plan Approved
as shown and/or noted
THOMAS P. GILLES, P.E.
Lake County Engineer

By *TPG* Date: 5-27-87

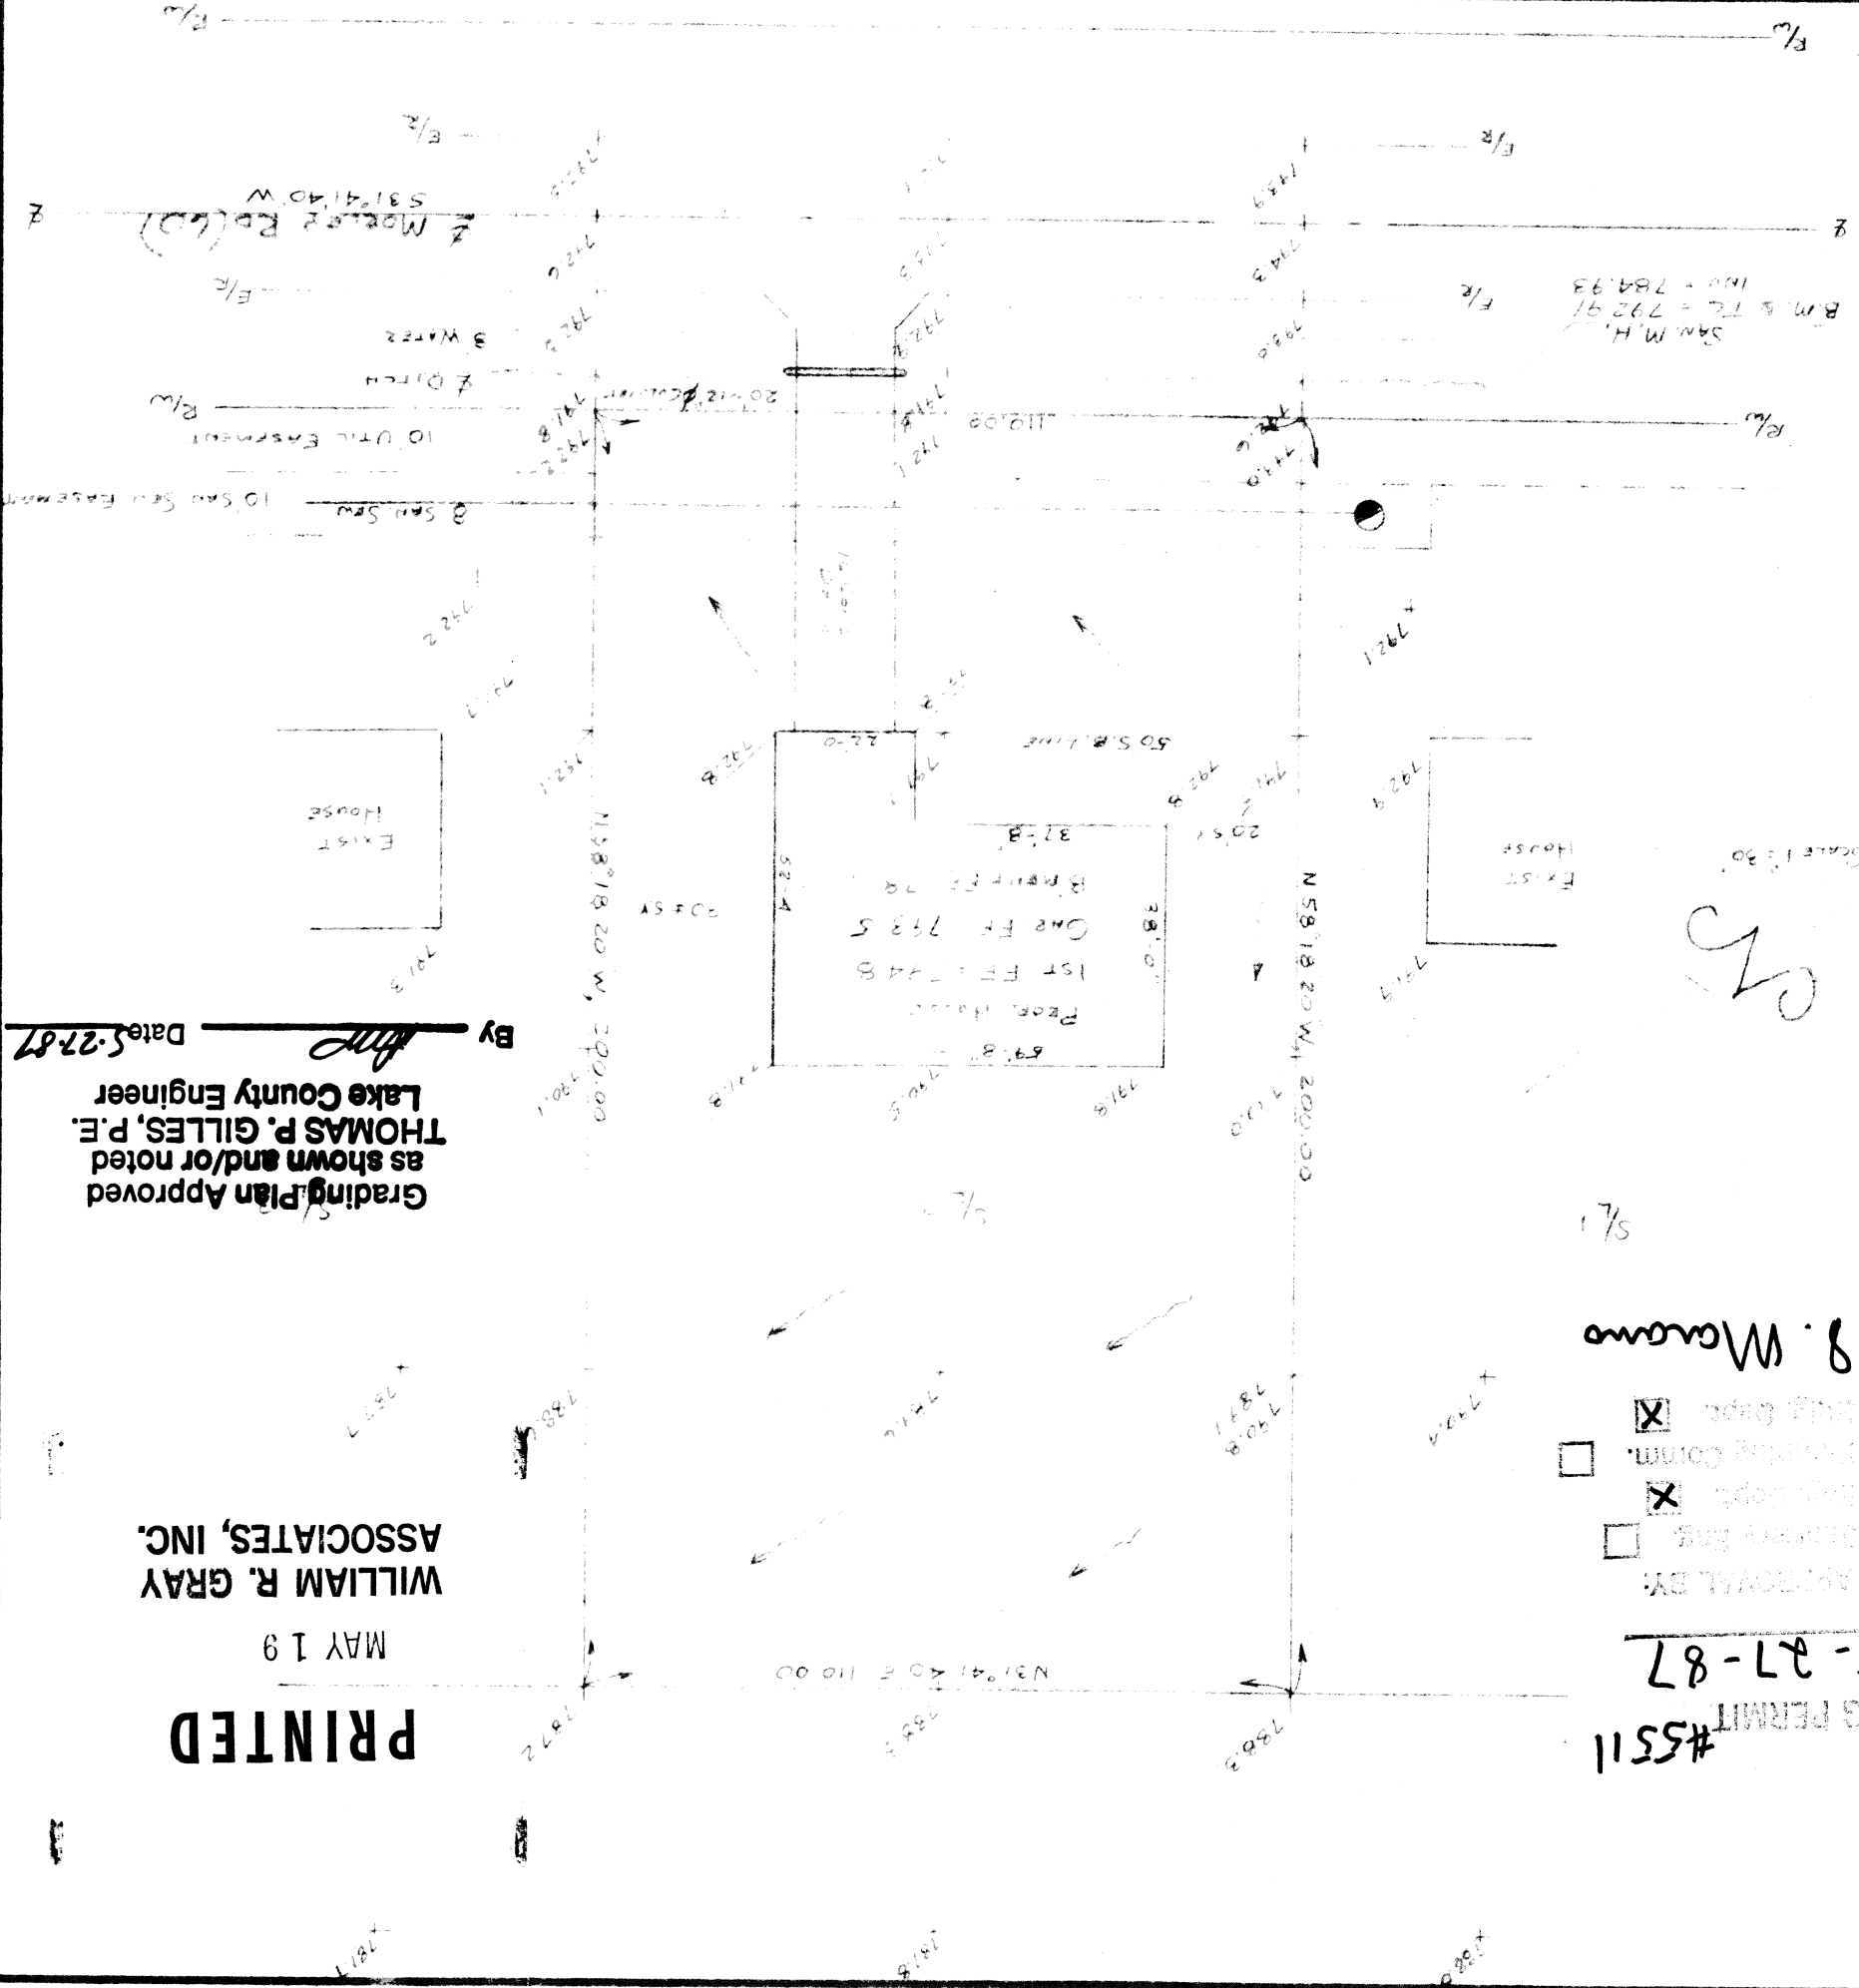

Terrell Gesson

- ☒ Lake County Building Dept.
- ☐ Lake County Planning Comm.
- ☒ Lake County Eng. Dept.
- ☐ Lake County Surveying Eng.

ISSUED 5-27-87

#5511 ZONING PERMIT