


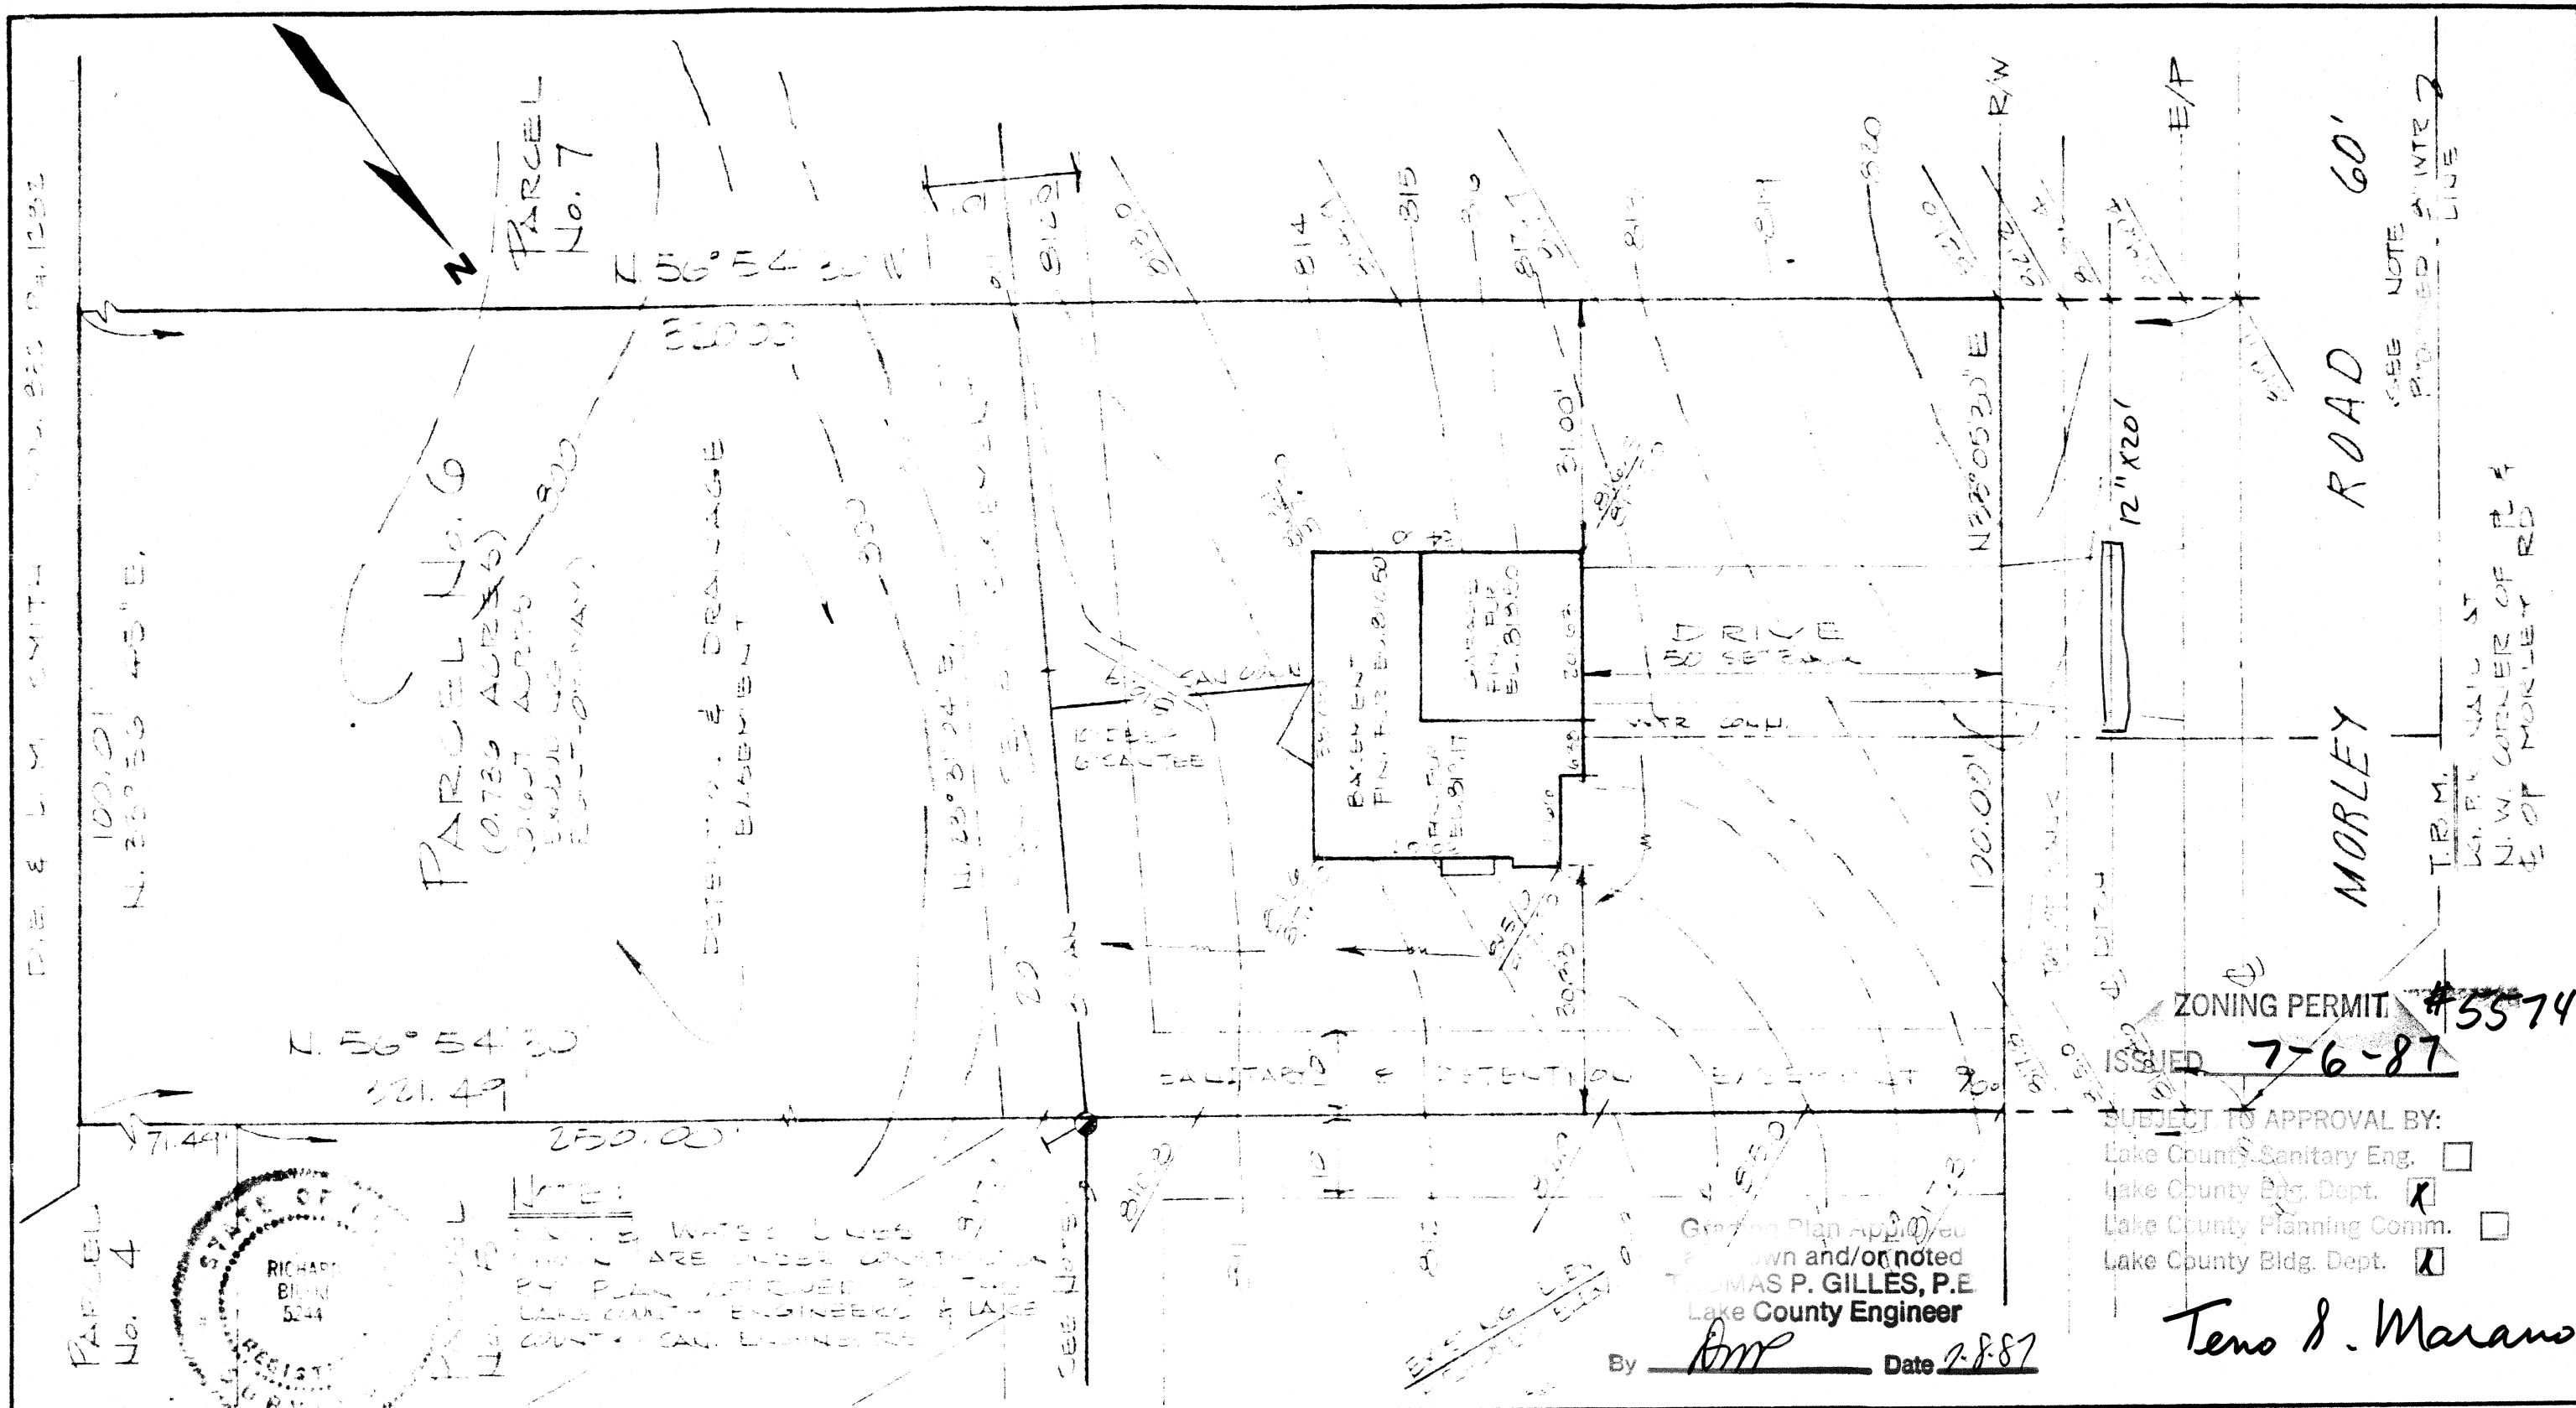

ZONING PERMIT #5574

ISSUED 7-6-87

SUBJECT TO APPROVAL BY:
Lake County Sanitary Eng. ☐
Lake County Eng. Dept. ☒
Lake County Planning Comm. ☐
Lake County Bldg. Dept. ☒

Teno S. Marano

DESIGN CERTIFICATION

THIS PLAT WAS PREPARED BY ME, AND IS CORRECT TO THE BEST OF MY KNOWLEDGE AND BELIEF.

[Signature]

REG. SURVEYOR NO. 5244

AS BUILT CERTIFICATION

I HEREBY CERTIFY THAT THE CIRCLED GRADES ARE EXISTING FINISH GRADES CHECKED IN THE FIELD ON _____ AND THAT SURVEY IS CORRECT TO THE BEST OF MY KNOWLEDGE AND BELIEF.

REG. SURVEYOR NO. _____



COLPETZER · WOODS
CONSULTANTS, INC.

9470 MENTOR AVENUE • MENTOR, OHIO 44060 • (216) 357-7569

DATE 5-18-87

SCALE 1" = 20'

DRWN BY LH

CHKD BY _____

JOB NO. 27-37

FB 604 PG 42

SITE PLAN

WHITAKER DEVELOPMENT
NORMANDY DEVELOPMENT PARCEL NO 6
CITY OF TOWNSHIP - COUNTY OF LAKE
STATE OF OHIO