


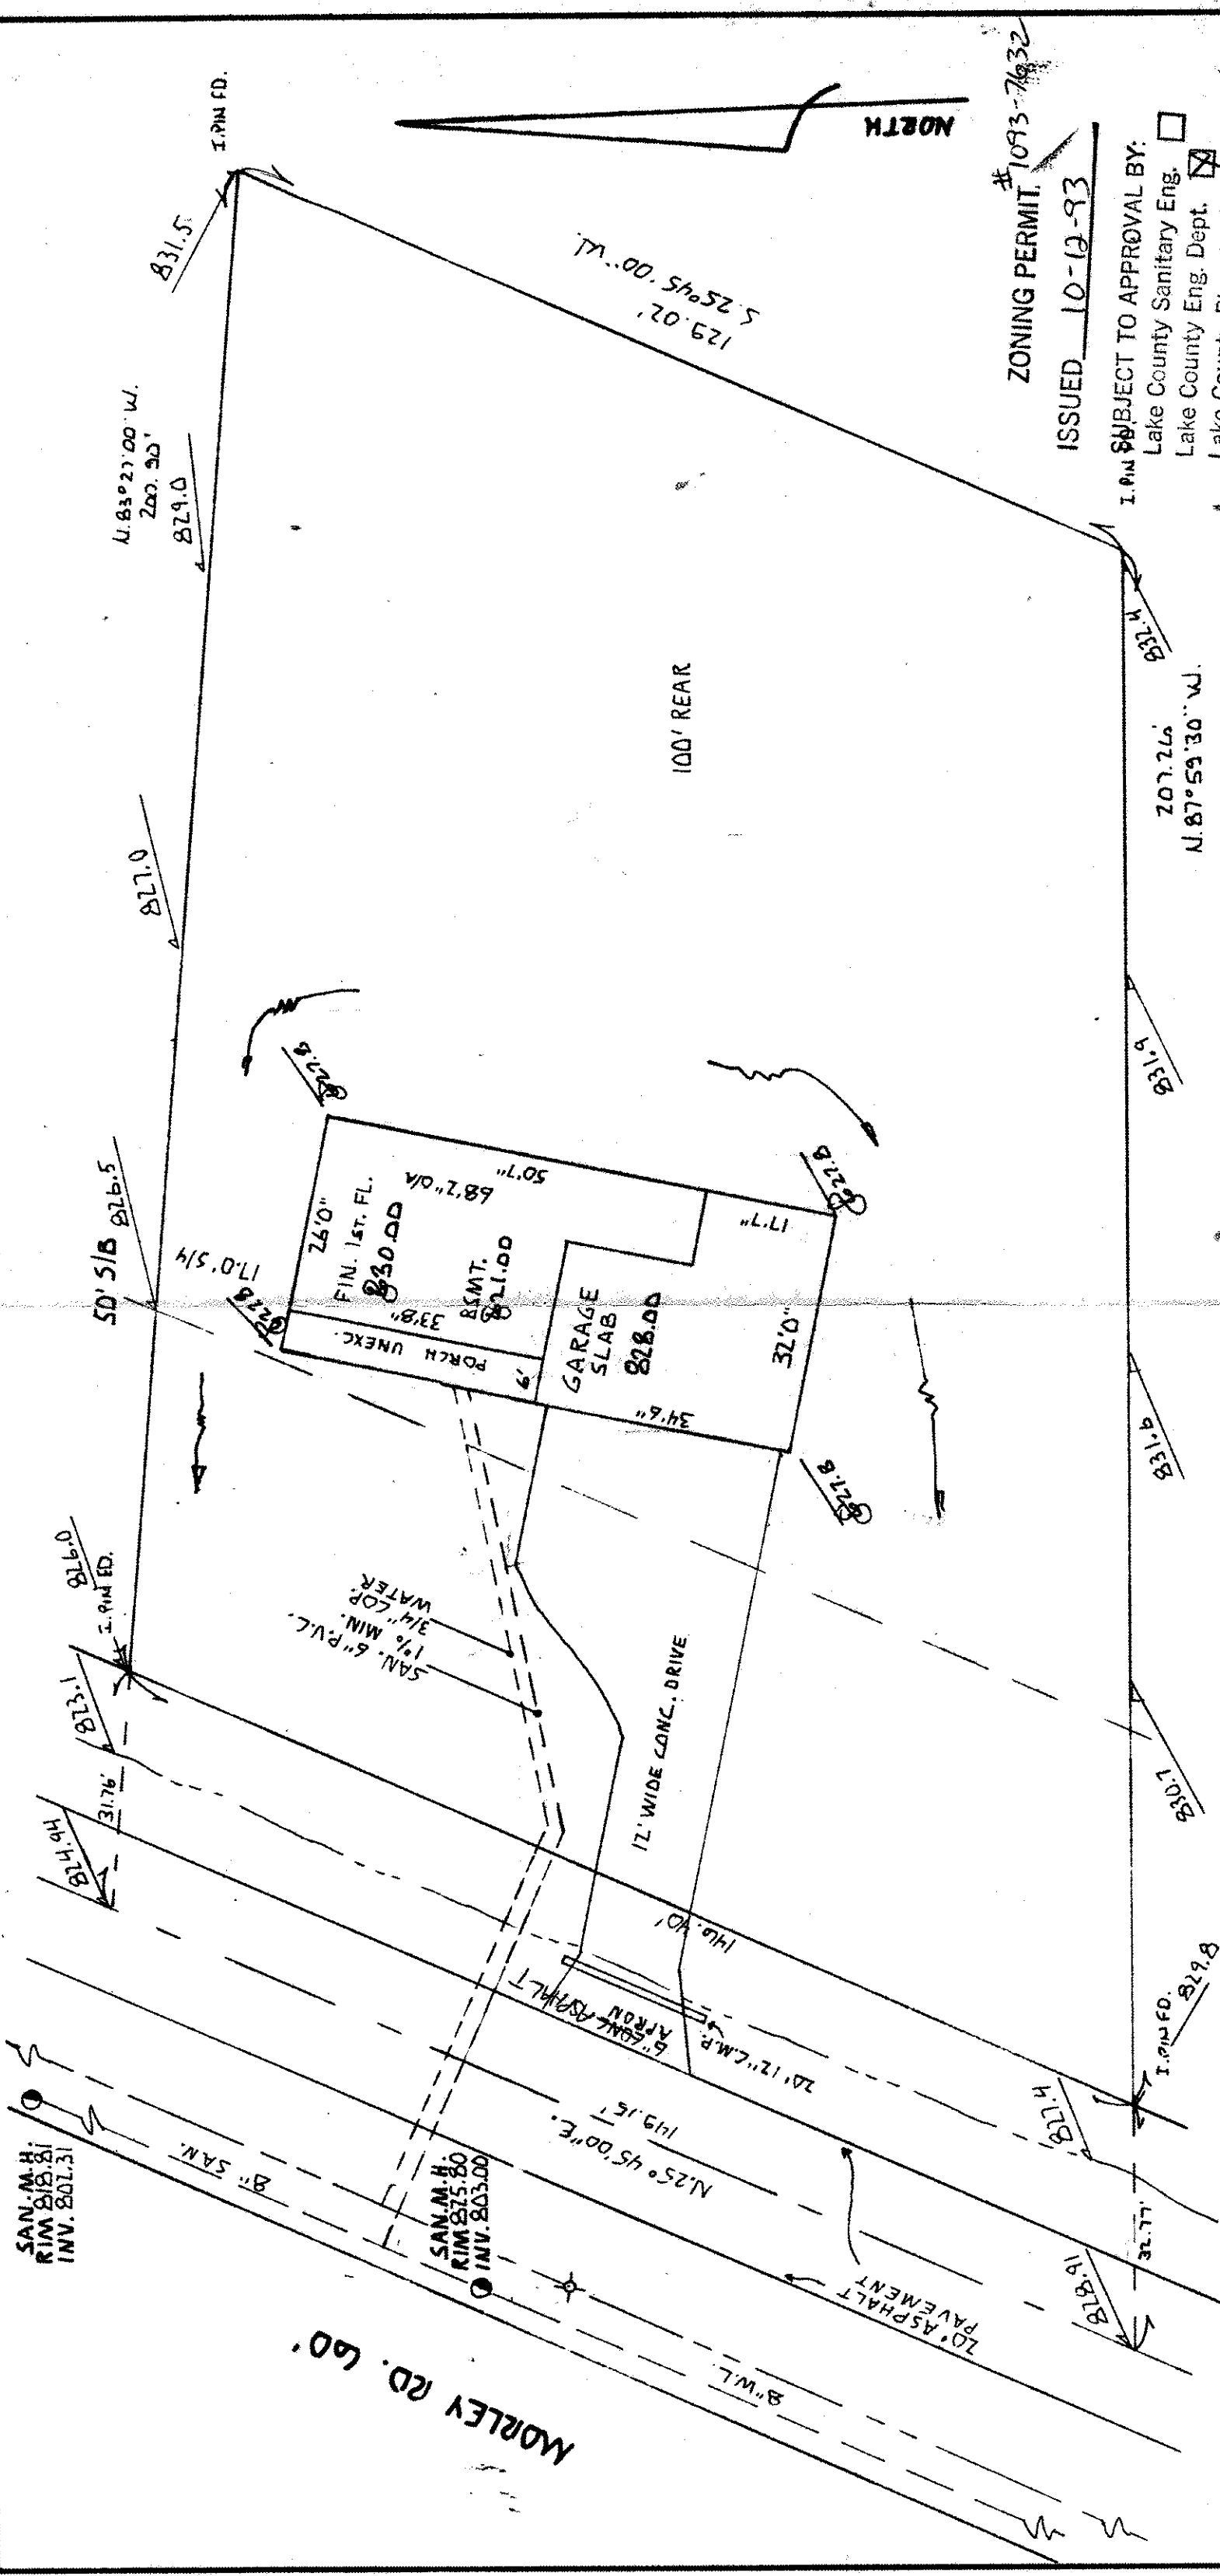

BENCHMARK:
TOP STEM OF HYD.
ELEV. 827.44

IDENTITY THAT THIS PLAN
WAS PREPARED BY ME AND
IS SUBJECT TO THE SIGNATURE
OF ME AND AN OFFICER

John C. Skonieczny
REG. SURVEYOR NO. 56

JOHN C. SKONIECZNY
7739 VIEWMOUNT DR.
PAINESVILLE, OHIO 44077
PH. 352-7742

Grading Plan Approved
as shown and/or noted
THOMAS P. GILLES, P.E.
Lake County Engineer
611# Date: 10-15-93

- ASPHALT APPROX
- ROAD PERMIT REQUIRE
- FUR UTILITY CONDUITS.

**SITE PLAN FOR:
NAGY SERVICE CO.**

SCALE: 1" = 20'	APPROVED BY	DRAWN BY FJH
DATE: SEPT. 93		
BEING PART OF LOT DESCRIBED IN VOL. 257- P 134 & L & R D. TOWNSHIP OF CONCORD COUNTY OF LAKE STATE OF OHIO		
MAP # 93-1735		DRAWING NUMBER 93-1200

#1093-7632
ZONING PERMIT.
ISSUED 10-12-93
SUBJECT TO APPROVAL BY:
Lake County Sanitary Eng. ☐
Lake County Eng. Dept. ☒
Lake County Planning Comm. ☐
Lake County Bldg. Dept. ☒

SUBJECT TO APPROVAL BY:
 Lake County Sanitary Eng. ☐
 Lake County Eng. Dept. ☒
 Lake County Planning Comm. ☐
 Lake County Bldg. Dept. ☒