

SITE PLAN

CONCORD TOWNSHIP, LAKE COUNTY, OHIO

for: WHITAKER

CLIENT		OWNER	
ADDRESS	STREET	CITY	ZIP
STONE HOLLOW		NAME	TRACT
SUBDIVISION	15-30	LOT	STREET
2	VOL-PG.	MORLEY RD.	LOT
SUBLOT NO.	STREET	VOL-PG.	PERM. PARCEL NO.

LEGEND

SANITARY MANHOLE	---○---	EXIST. ELEV. ---100.0---2--- PROP. ELEV.
STORM MANHOLE	---●---	AS BUILT ELEVATION
INLET OR CATCH BASIN	---■---	INDICATES DIRECTION OF SURFACE DRAINAGE
HYDRANT	---◇---	
EXISTING CONTOURS	---○---	
PROPOSED CONTOURS	---○---	

DESIGN CERTIFICATION

THIS PLAN WAS PREPARED BY ME, AND IS CORRECT TO THE BEST OF MY KNOWLEDGE AND BELIEF.

NAME: *[Signature]* SURVEYOR REGISTRATION NO. 6343

REVISIONS			PLAN PREPARED BY:	
NO.	DATE	BY	BABCOCK JONES & ASSOCIATES, INC.	
1			PAINESVILLE, OHIO	
2				
3			DRAWN BY T.R.	SCALE 1"=20'
4			CHK'D. H.J.	DATE 8/16/01
5			CREW CHIEF R.B.	APP'D H.J.
			PHONE NO. 440-357-1811	DRAWING NO. 91-074-02

"AS BUILT" CERTIFICATION
I, HEREBY CERTIFY THAT THE CIRCLED GRADES ARE EXISTING FINISH GRADES CHECKED IN THE FIELD ON 8/16/01, 2001 AND ARE CORRECT TO THE BEST OF MY KNOWLEDGE AND BELIEF.

REGISTERED SURVEYOR

REG. NO.

BM-SANITARY MANHOLE
RIM-958.87

NOTE: TEMPORARY SEEDING REQUIRED IN DISTURBED AREAS.

Grading Plan Approved
as shown and/or noted
JAMES R. GILLS, P.E.
Lake County Engineer

By *[Signature]* Date 8/23/01
1. A permit will be required for utility work within 20' of the road.
ROOF DRAINS SHALL DISCHARGE TO SPLASH BLOCKS.

SAN. MH.
RIM 947.84
INV. 938.80


CONCORD TOWNSHIP ZONING OFFICE

ZONING PERMIT # 001-10314

ISSUED 8-21-01

SUBJECT TO APPROVAL BY:

- ☒ Lake Co. Zoning Officer
- ☐ Lake Co. Planning Comm.
- ☐ Lake Co. Building Dept.
- ☐ Lake Co. Soil & Water Cons. Dist.

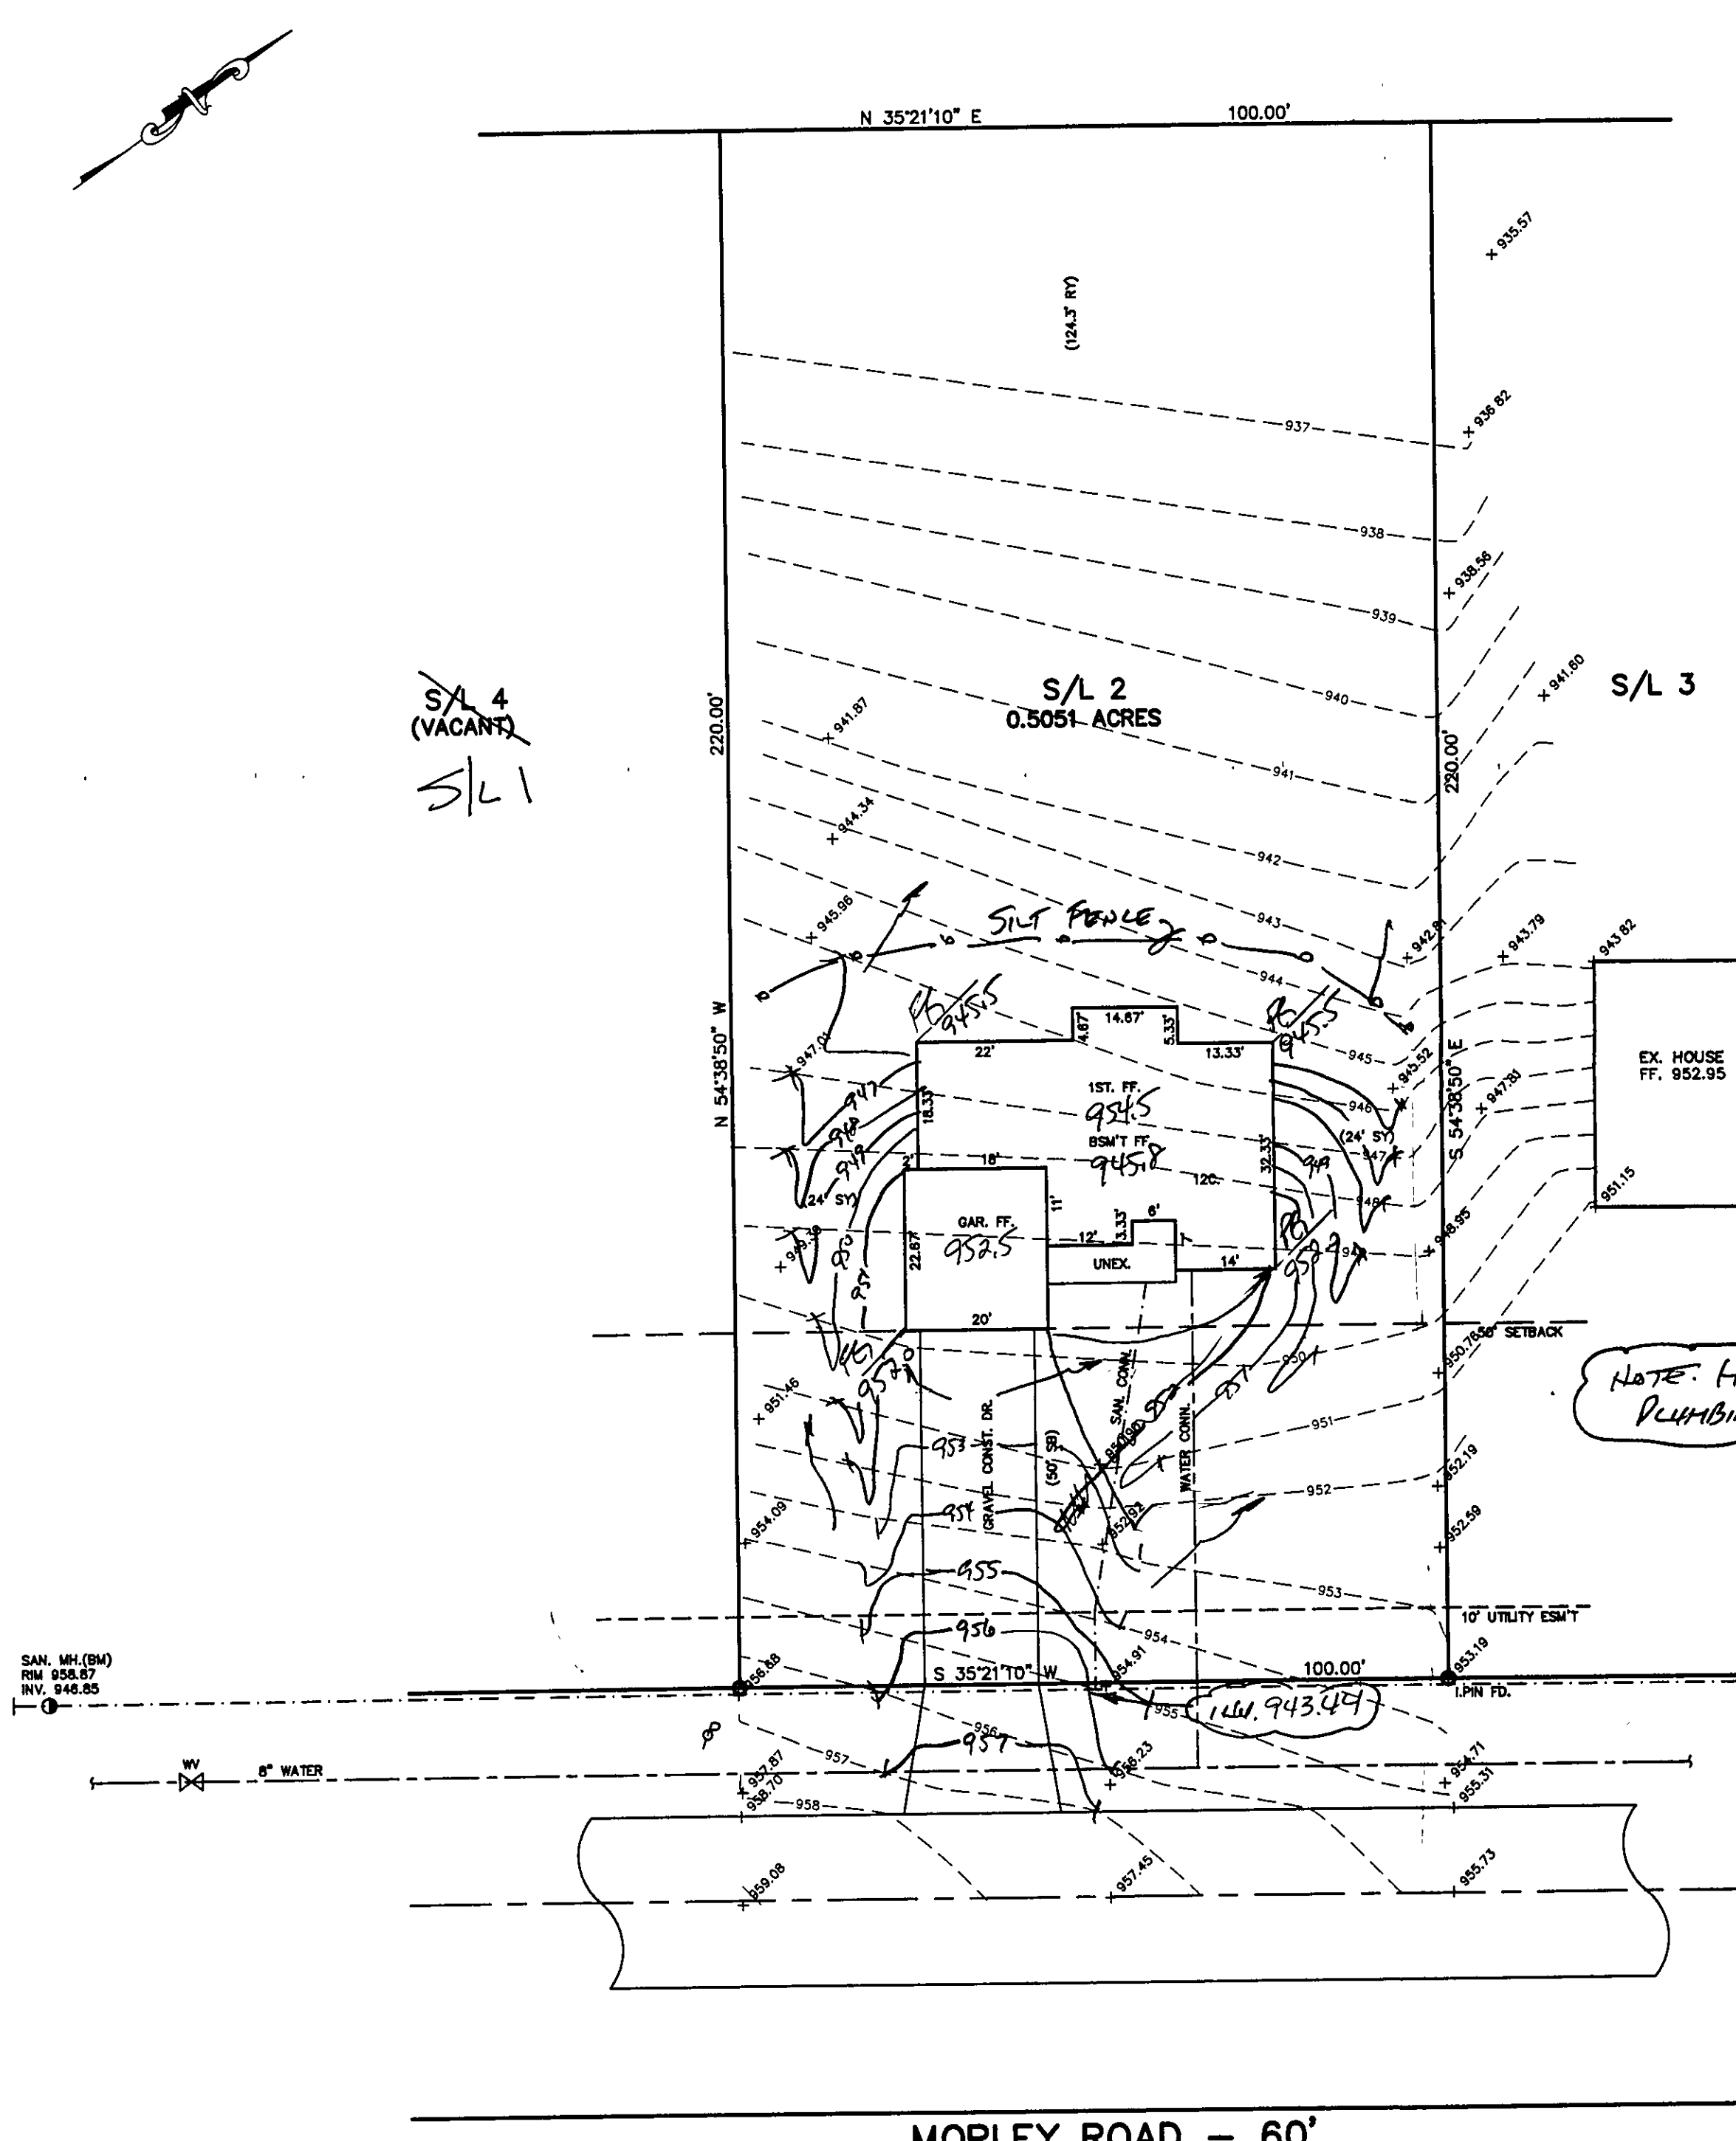

MORLEY ROAD - 60'