


ZONING PERMIT #0877-9338
 ISSUED 8/30/71
 SUBJECT TO APPROVAL BY:
 Lake County Sanitary Eng. ☐
 Lake County Eng. Dept. ☒
 Lake County Planning Comm. ☐
 Lake County Bldg. Dept. ☒

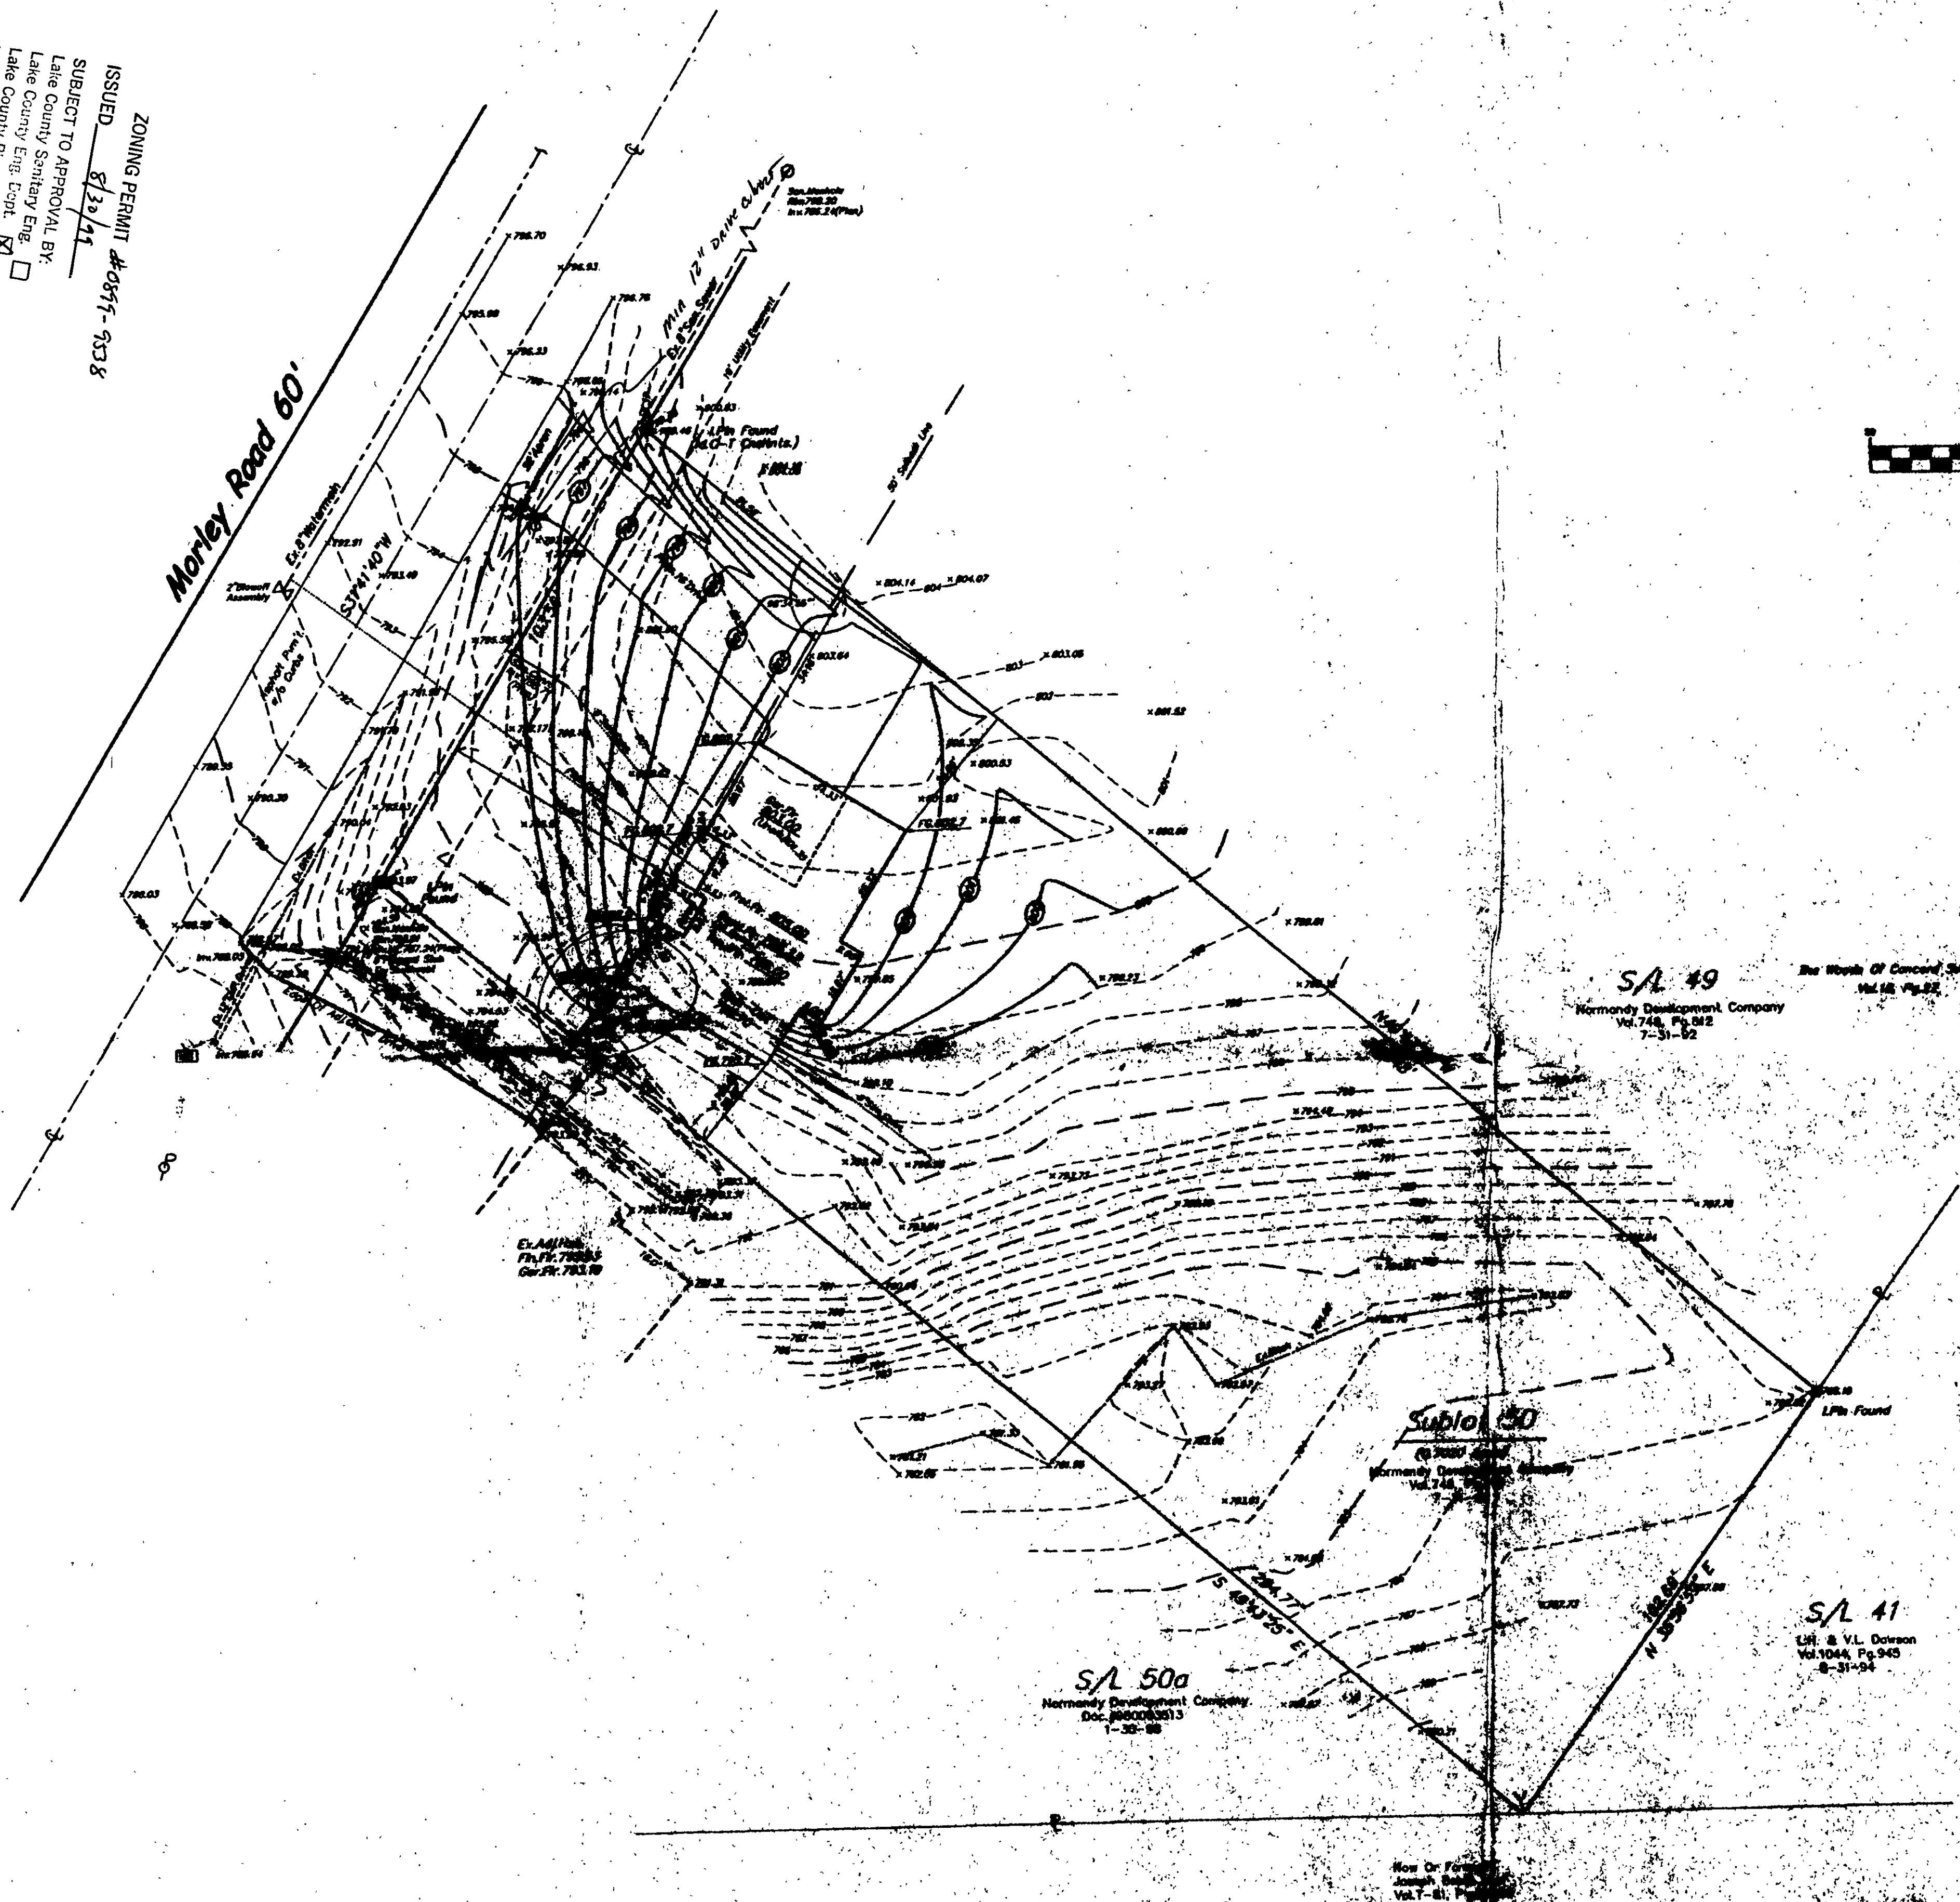

I, THE UNDERSIGNED, HEREBY CERTIFY THAT THE
 TOPOGRAPHY, INCLUDING THE CONTOUR
 AND ELEVATIONS THEREON, AND THE
 ACTUAL FIELD SURVEY OF THE
 DAY OF 8/30/71, AND THAT THE
 ELEVATIONS WERE TAKEN AT APPROPRIATE INTERVALS
 AND THAT AS OF THIS DATE THE SURVEY IS
 CORRECT AND ACCURATE.
Robert A. Johnson
 Robert A. Johnson, S.E.

2 WORKING DAYS
 BEFORE YOU DIG
 CALL TOLL FREE 800-362-2764
 OHIO UTILITIES PROTECTION SERVICE