



NOTE:
ALL WOUNDED EXCAVATION SHALL BE
IMPOUNDED WITH SILT FENCE.
ALL DOWNSPOUTS TO CONNECT
TO FOOTER DRAIN OUTLET.
ALL C.B. AND YARD DRAINS SHALL
HAVE STRAW BALES PLACED ON EACH
SIDE FOR SEDIMENT CONTROL.

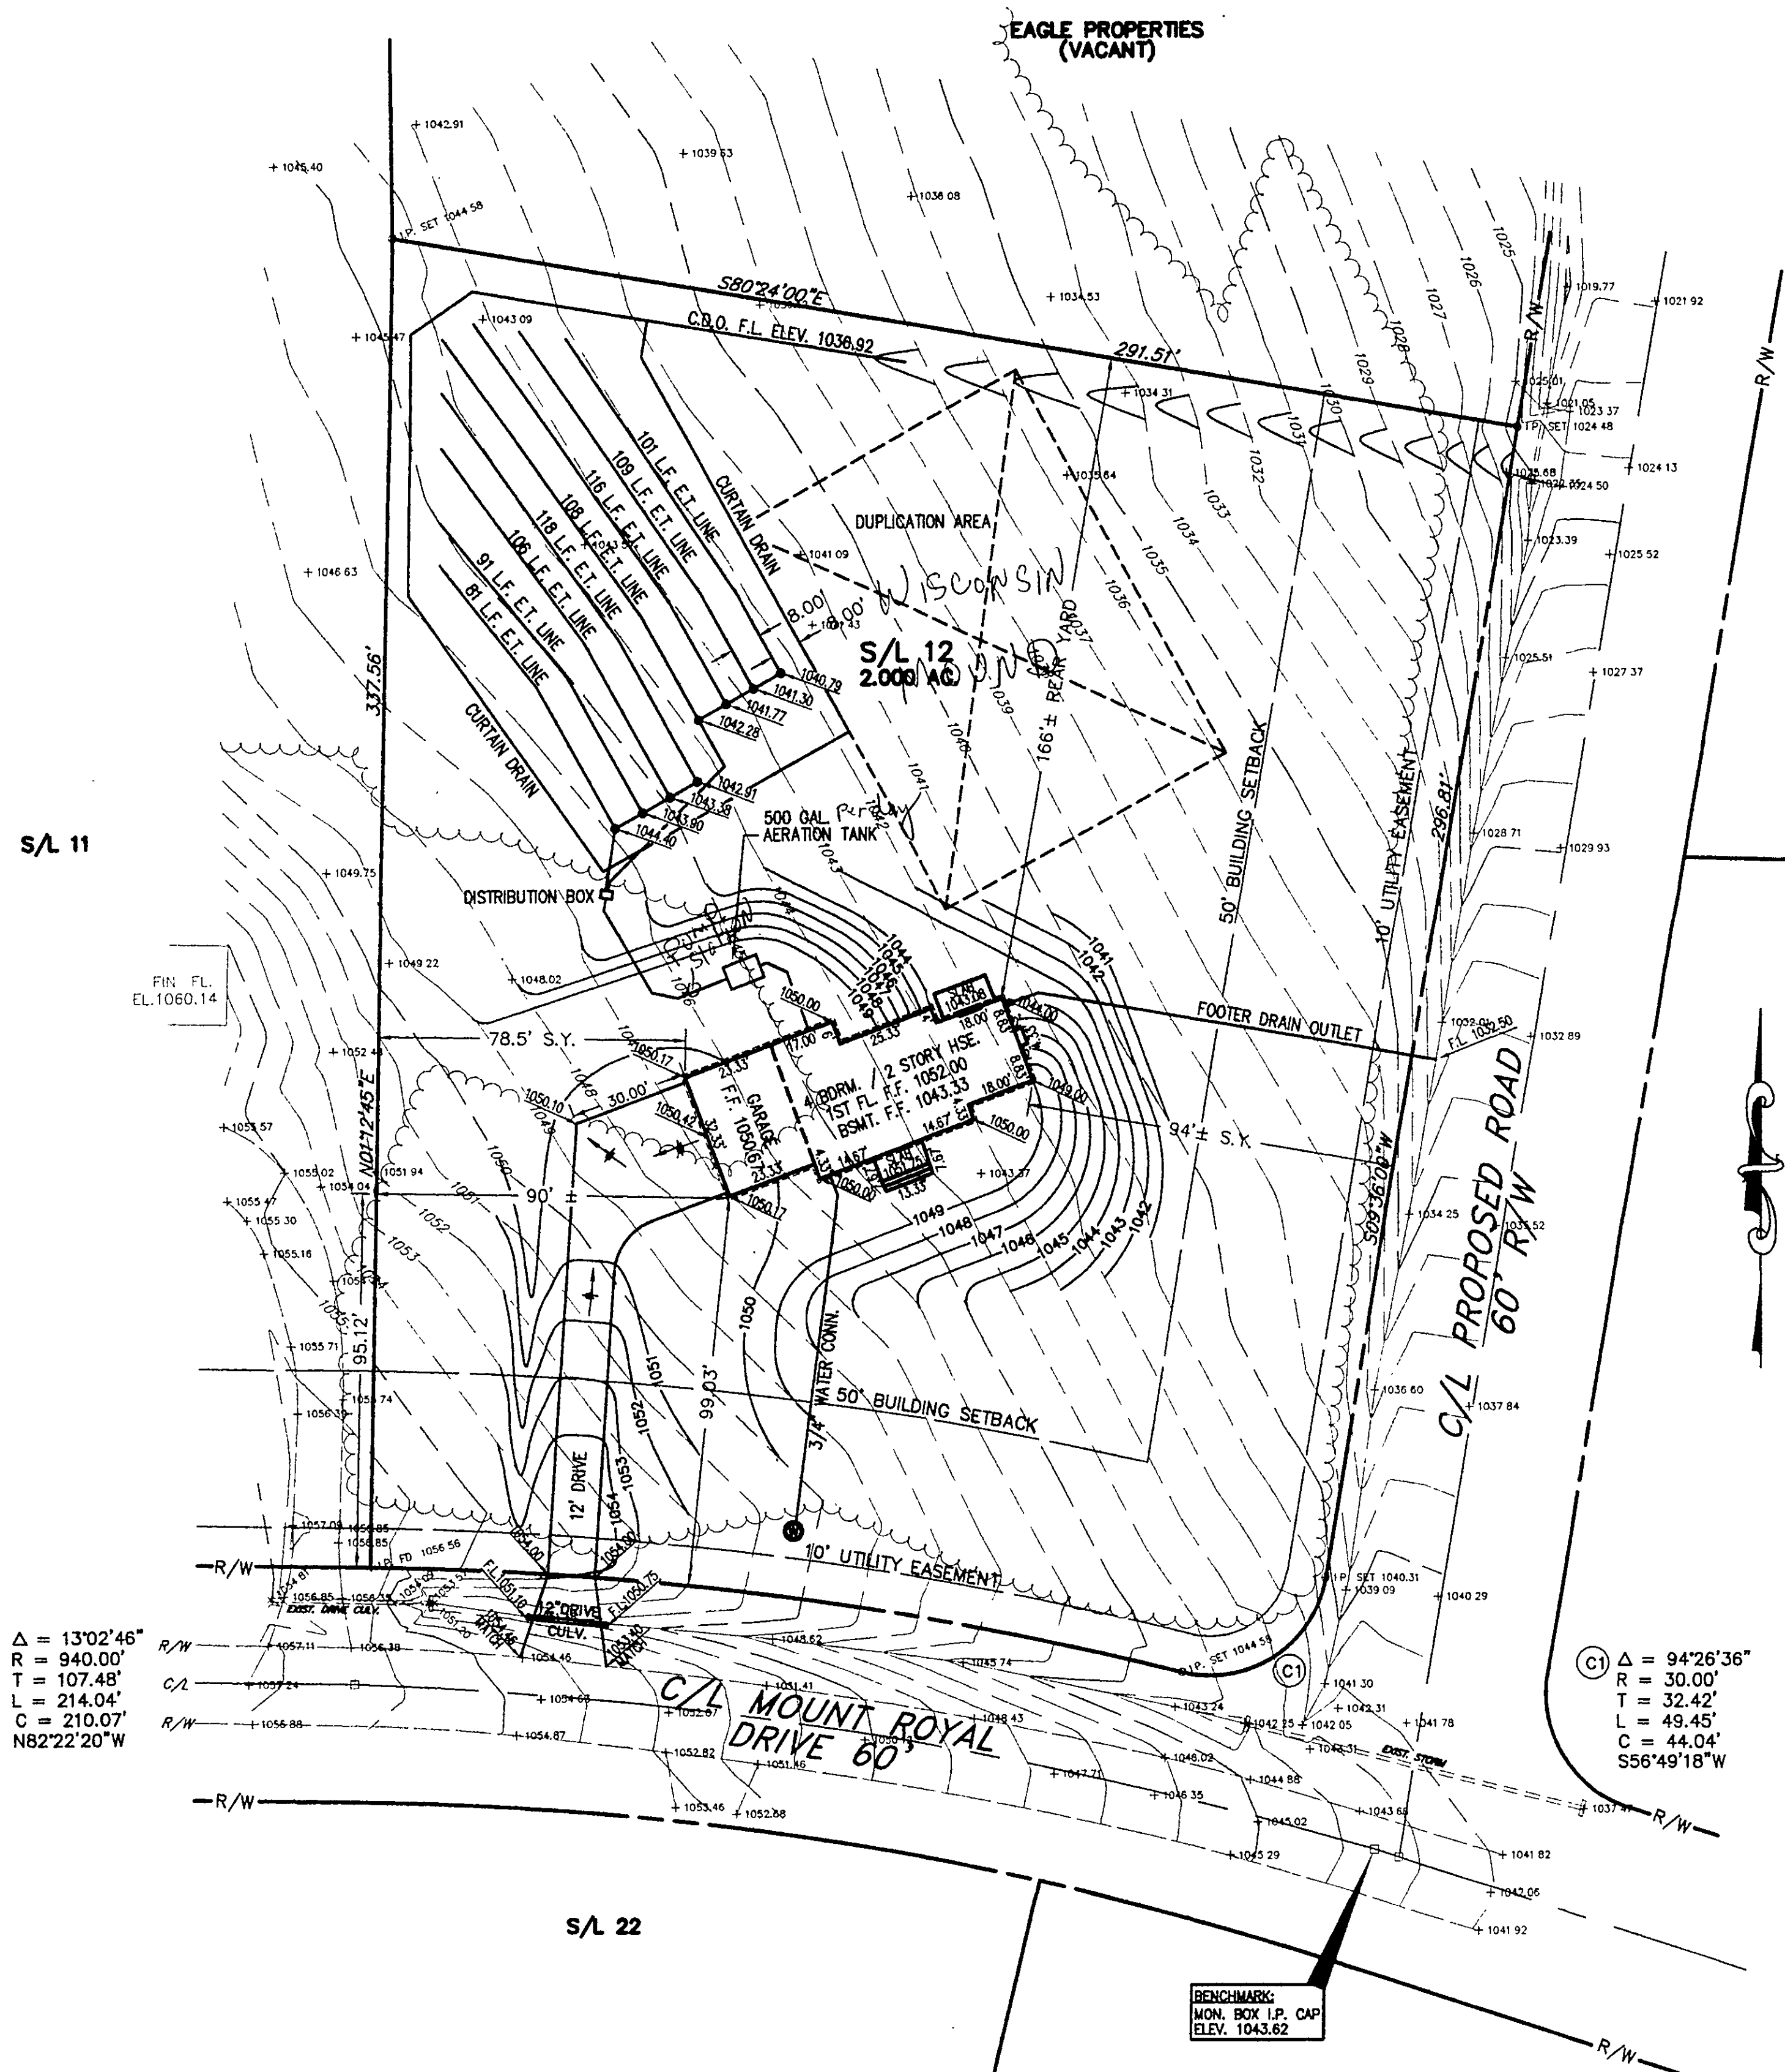

REVIEWED AND ACCEPTED
LAKE COUNTY GENERAL
HEALTH DISTRICT

Date 9-25-97
By David B. Rapp

SEWAGE DISPOSAL PERMIT MUST BE
OBTAINED BY A LAKE COUNTY LICENSED
INSTALLER BEFORE INSTALLATION IS
STARTED.

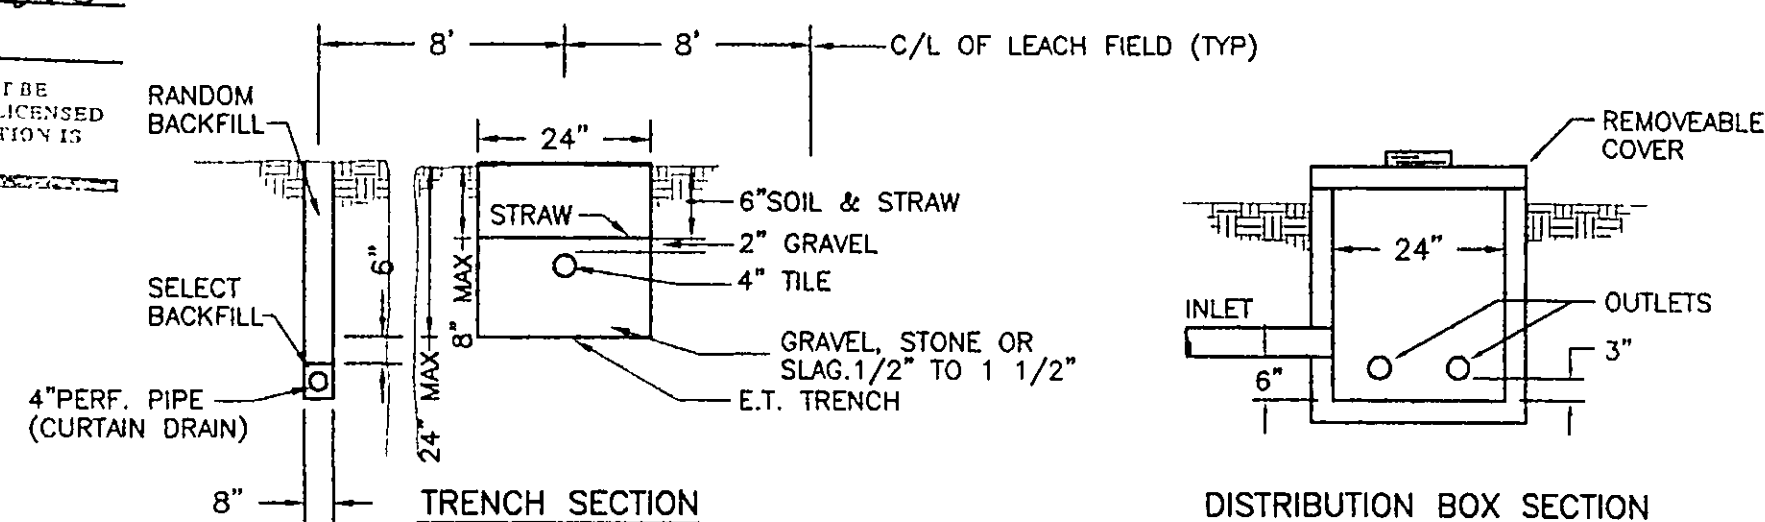


EVAPO-TRANSPIRATION TILE FIELD

Grading Plan Approved
as shown and/or noted
THOMAS P. GILLES, P.E.
Lake County Engineer


By 6/14 Date 9-29-97

ZONING PERMIT 0997885
ISSUED 9-25-97

SUBJECT TO APPROVAL BY:
Lake County Sanitary Eng. ☐
Lake County Eng. Dept. ☒
Lake County Planning Comm. ☐
Lake County Bldg. Dept. ☒

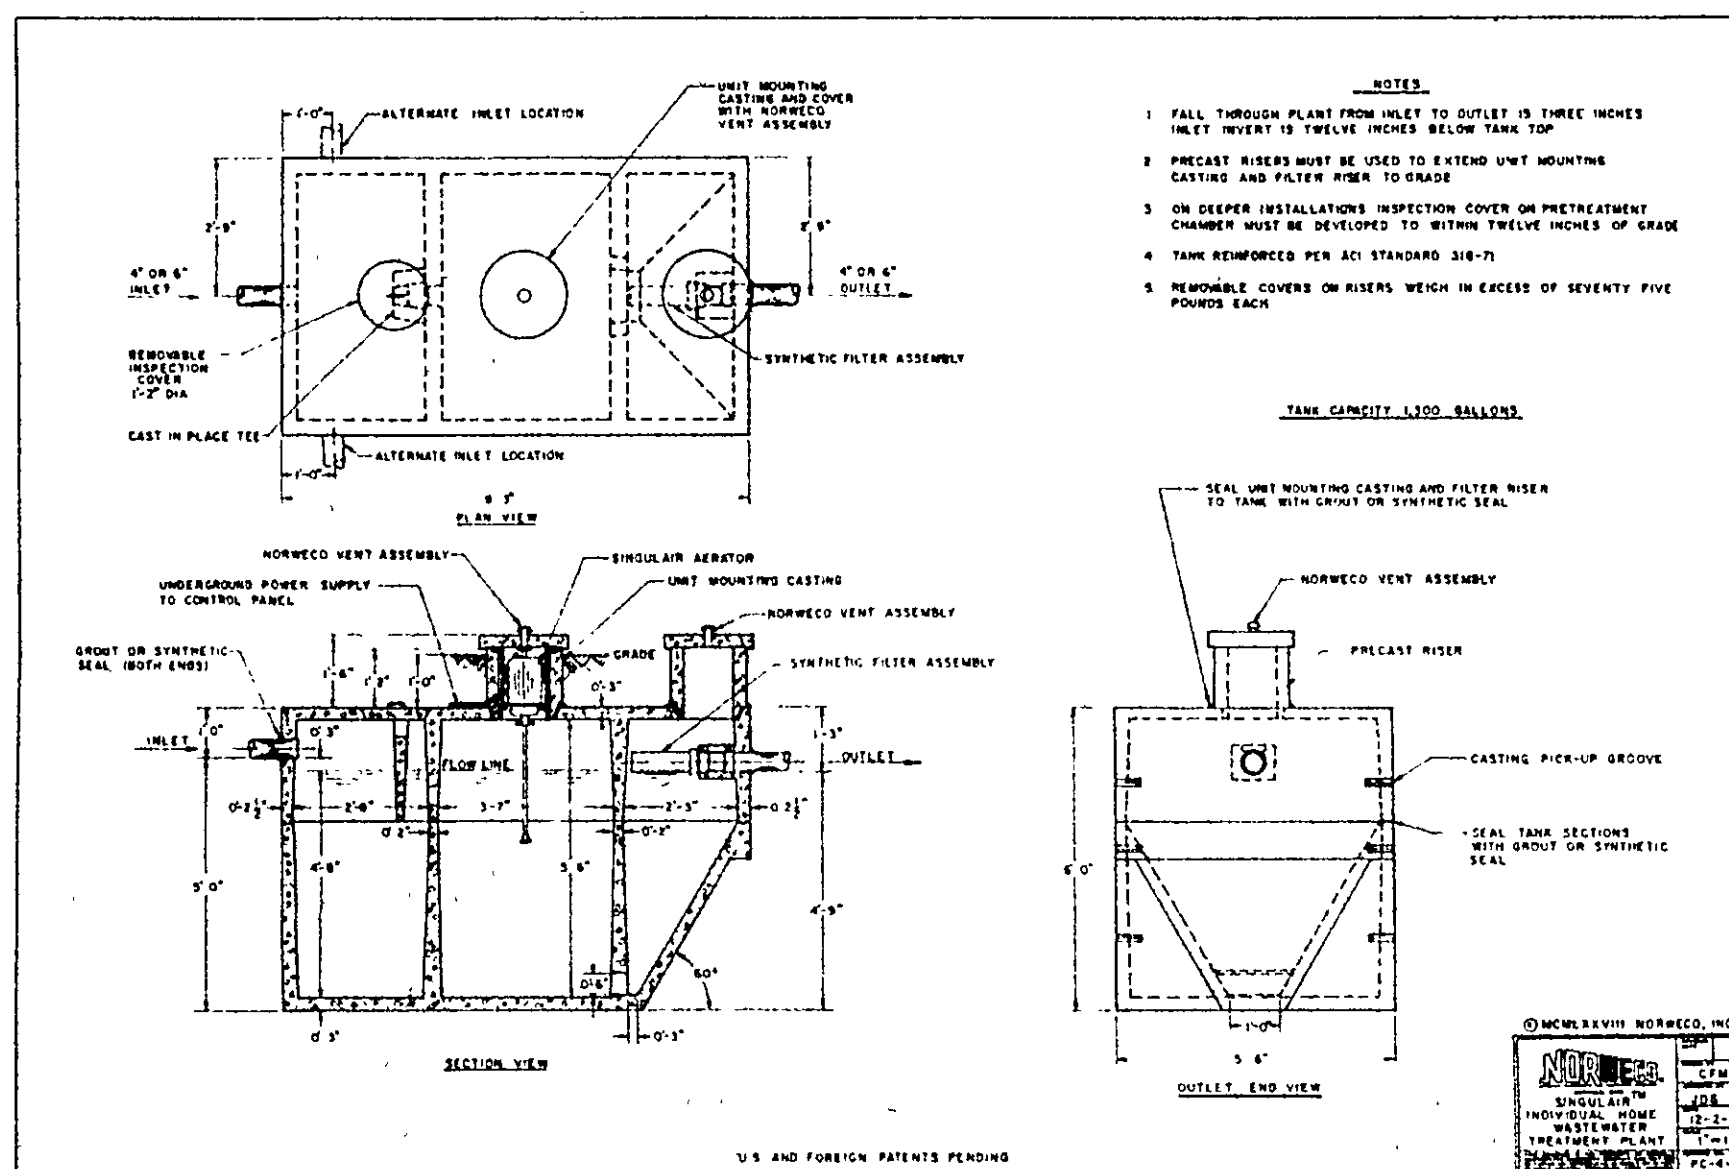

HYDRAULIC PROFILE

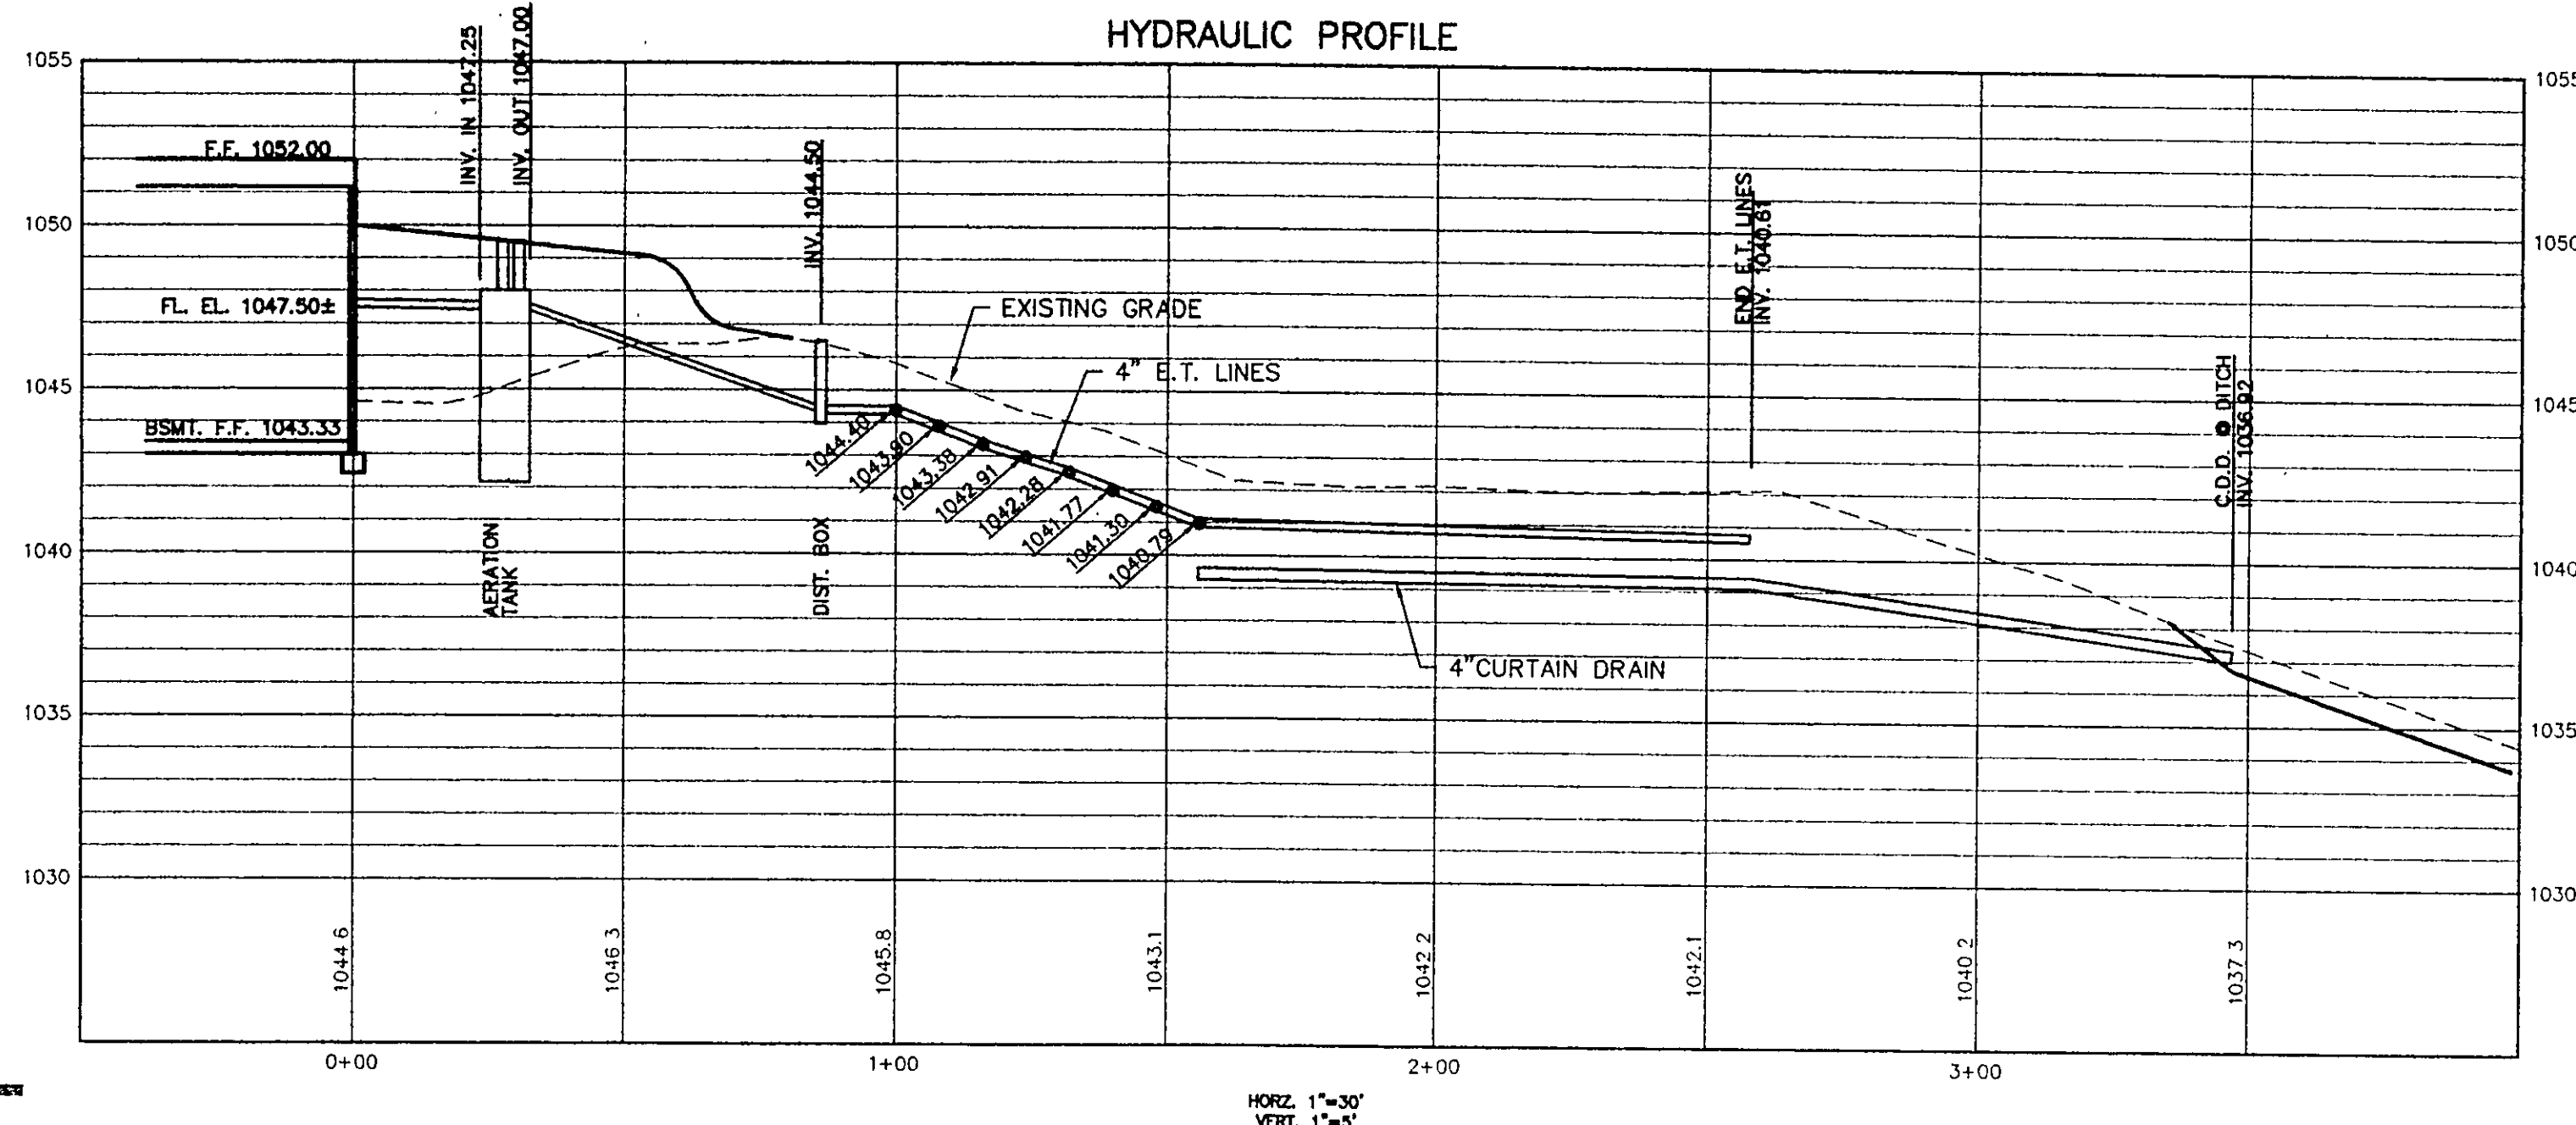

I HEREBY CERTIFY THAT THIS PLAT WAS PREPARED FROM A
FIELD SURVEY PERFORMED ON 8-15-97 MADE UNDER MY
SUPERVISION. MONUMENTS WERE FOUND OR SET AS INDICATED.
DIMENSIONS ARE EXPRESSED IN FEET AND DECIMAL PARTS
THEREOF. BEARINGS USED HEREON REFER TO AN ASSUMED
MERIDIAN AND ARE INTENDED TO INDICATE ANGLES ONLY, ALL
OF WHICH ARE CORRECT TO THE BEST OF MY KNOWLEDGE
AND BELIEF.

"I, THE UNDERSIGNED HEREBY CERTIFY THAT THE TOPOGRAPHY
SHOWN HEREON, INDICATED BY ONE FOOT CONTOURS AND
ELEVATIONS, REPRESENTS AN ACTUAL FIELD TOPOGRAPHIC
SURVEY MADE UNDER MY SUPERVISION ON THE 8th DAY
OF AUGUST, 1997 AND THAT THE ELEVATIONS WERE TAKEN AT
APPROPRIATE INTERVALS AND THAT AS OF THAT DATE THEY
EXISTED AS INDICATED HEREON."

David A. Rapp
DAVID A. RAPP
REGISTERED SURVEYOR NO. 7597

SITE PLAN

LAKE COUNTY, OHIO

for: HANNA HOMES - DENIS PECJAK
client owner
6909 WEATHERBY DRIVE MENTOR, OHIO 44060
address street city zip

MOUNT ROYAL

subdivision name	lot	tract
12 MOUNT ROYAL DRIVE		
sublot no.	street	pp no. street

LEGEND

SYMBOL	DESCRIPTION	REFERENCE
●	EXIST. ELEVATIONS	545.8
○	PROP. ELEVATIONS	545.8
—	INDICATES DIRECTION OF SURFACE DRAINAGE	

REMARKS

ALL BOUNDARY DATA SHOWN WAS OBTAINED FROM DEEDS,
RECORDED SUBDIVISION PLATS OR OTHER PUBLIC RECORDS.

DESIGN CERTIFICATION

THIS PLAN WAS PREPARED UNDER MY SUPERVISION, AND IS
CORRECT TO THE BEST OF MY KNOWLEDGE.

DAVID A. RAPP REG. SURVEYOR No. 7597 SEP 16 1997

REVISION

NO.	DESCRIPTION	DATE	BY

DRAWN BY	MPJ	SCALE	1"=30'	PHONE NO.	953-1567
CHECKED BY	DAR	DATE	9/15/97	JOB NO.	97-129
CREW CHIEF	CAP	APPROVED		DRAWING NO.	1/1