
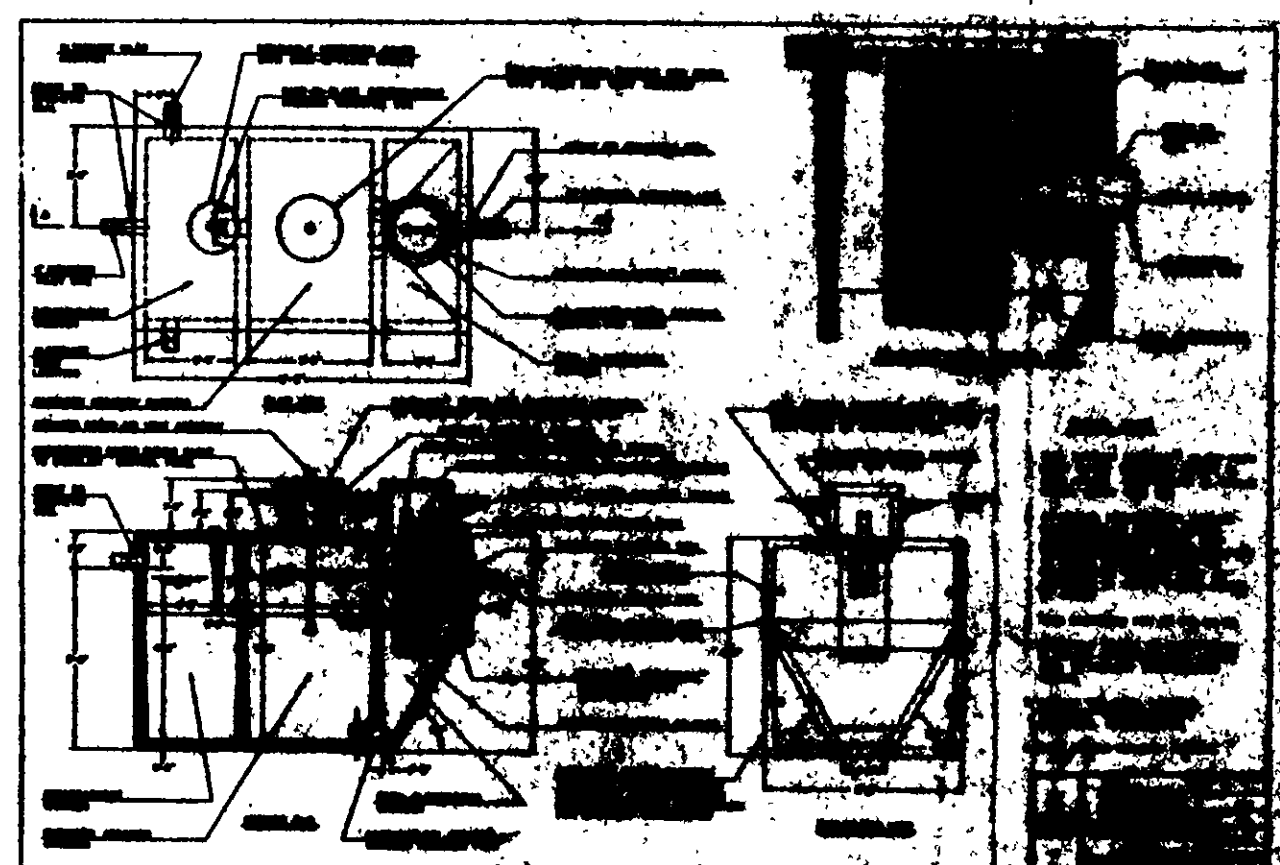
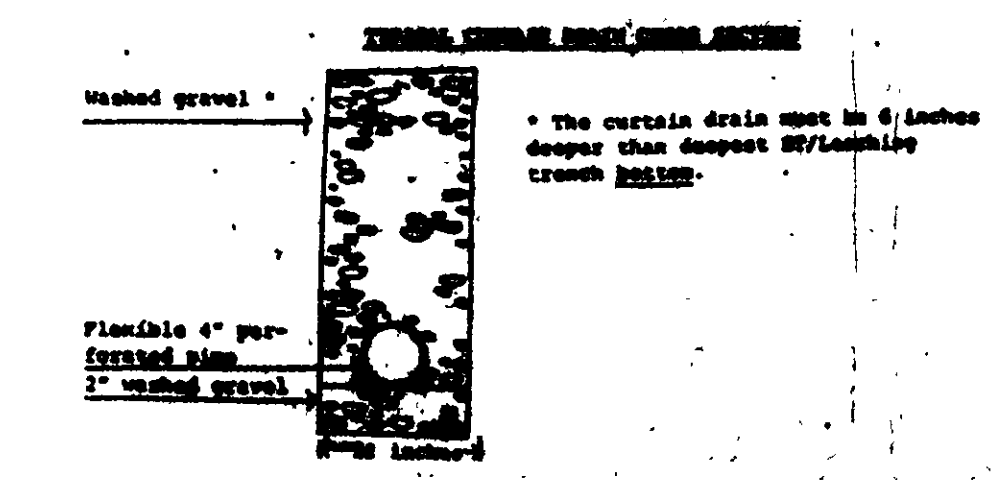


REVIEWED AND ACCEPTED
 LAKE COUNTY GENERAL
 HEALTH DISTRICT
 Date: 2-17-98
 David B. Morris P.E.
 SEWAGE DISPOSAL PERMIT MUST BE OBTAINED BY A LAKE COUNTY LICENSED INSTALLER BEFORE INSTALLATION IS STARTED.

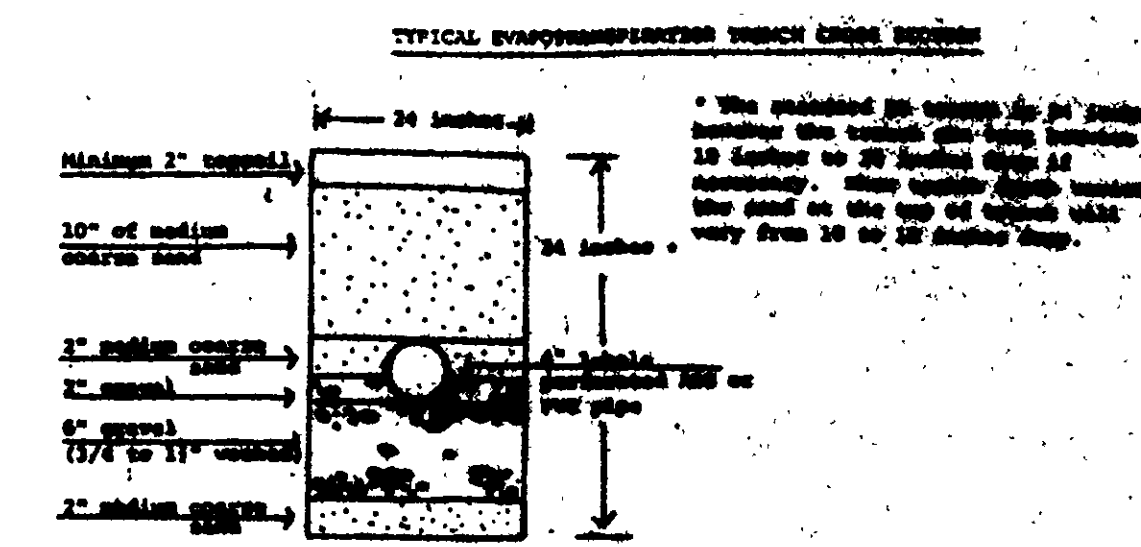

SL-22


SL-24

(A) R=2070.00'
 Δ=7°-29'-41"
 A=270.77'
 C=270.58'
 N 02°-50'-14\"/>

(B) R=80.00'
 Δ=90°05'-13"
 A=125.79'
 C=113.22'
 N 45°-57'-13\"/>

SITE PLAN		
for: DEMORE CONSTRUCTION		
6173	PEBBLEBROOK LANE	NORTH CLUSTER
ADDRESS		STREET CITY
23	MT. ROYAL	18-1B
SUBLOT No.	SUBDIVISION NAME	VOL. PAGE
6&12, 4	CONCORD	080
LOT, TRACT		TOWNSHIP

GUTOSKY & ASSOCIATES INC.
 Civil Engineers and Surveyors
 2227 S. Washington St.
 Chagrin Falls, Ohio 44022
 Tel: (419) 548-8888 Fax: (419) 548-7770

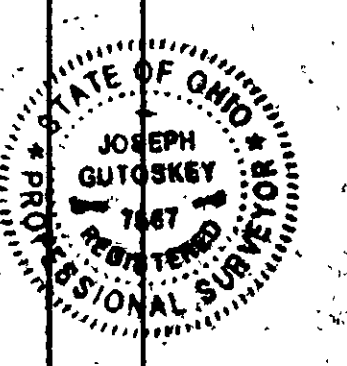

CHECK LIST
 LOT DIMENSIONS & BEARINGS
 TO NEAREST STREET
 SUBLOT No. (PAGE No.)
 SURROUNDING OWNERS
 BUILDING DIMENSIONS
 SETBACK, SEAWARD, REARYARD
 FENCED GRADE, DRIVEWAY
 DRIVE & ASPHALT TYPE, WIDTH, THICKNESS
 SIDEWALK TYPE, WIDTH, THICKNESS
 CONCRETE, CURB, WITH
 WATER MAIN SIZE, LOCATION
 SAN. SEWER SIZE, LOCATION
 SAN. SEWER 15' MIN. LOCATION
 STORM DRAIN SIZE, LOCATION
 PAY LAYER, GRADE, ELEV.
 SLOPE, SLOPE, CLINCH
 SPIN SYSTEM & DUPLICATION
 WELL LOCATION & ISOLATION RADIUS

DESIGN CERTIFICATION
 THIS PLAN WAS PREPARED BY ME, AND IS CORRECT TO THE BEST OF MY KNOWLEDGE.
 NAME: Joseph Gutosky

"AS-BUILT" CERTIFICATION
 I HEREBY CERTIFY THAT THE CIRCLED INFORMATION IS CORRECT AS OBTAINED ON THE SITE.
 CORRECT TO THE BEST OF MY KNOWLEDGE AND BELIEF.


LEGEND

STORM MANHOLE	○
SANITARY MANHOLE	⊙
EXISTING CONTOURS	--- 10'
PROPOSED CONTOURS	--- 10'
EXIST. ELEV.	100.0
100.0 PROP. ELEV.	
DIRECTION OF SURFACE DRAINAGE	→

BENCHMARK: Rm Sta INLET @ 344
 CORNER; ELEV. 1077.02

2 WORKING DAYS BEFORE YOU DIG
 CALL TOLL FREE 800-362-2744
 OHIO UTILITIES PROTECTION SERVICE

Grading Plan Approved
 as shown and/or noted
 THOMAS P. GILLES, P.E.
 Lake County Engineer
 By: [Signature] Date: 3-2-98
 Construct driveway
 shown

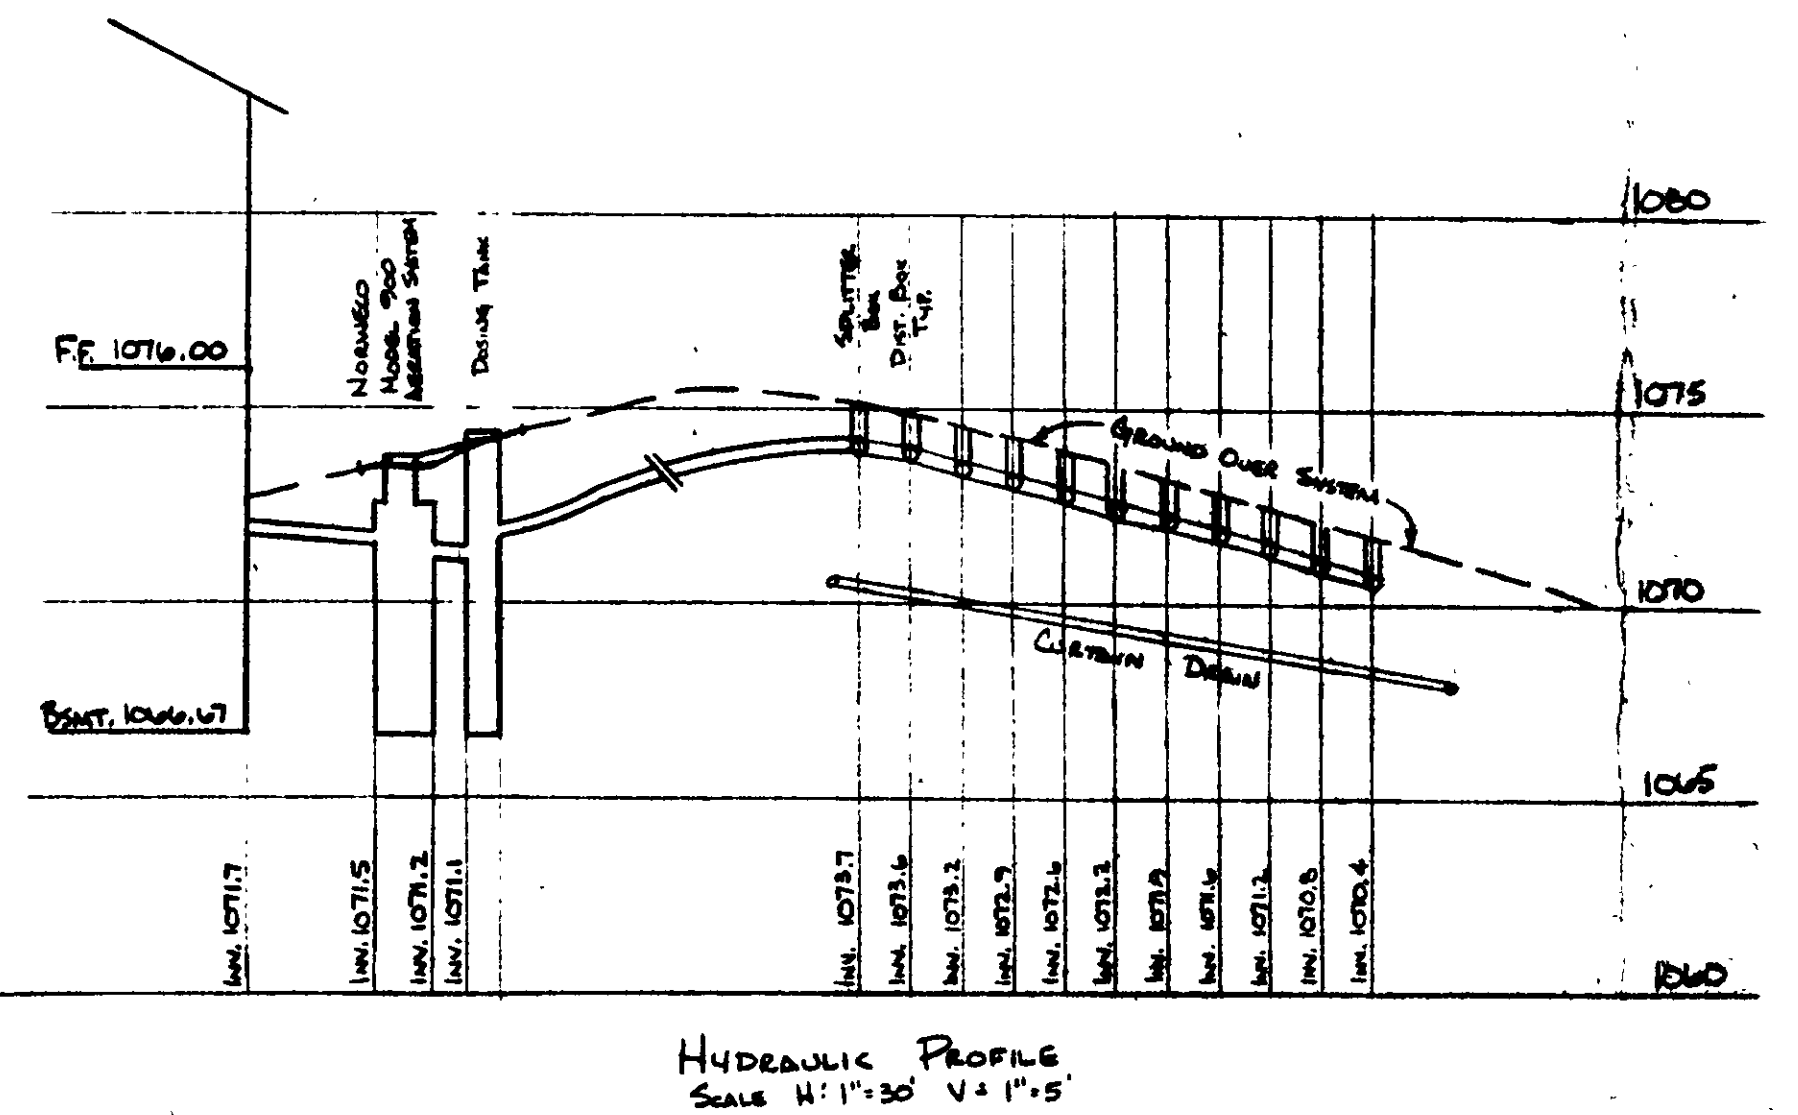

HYDRAULIC PROFILE
 SCALE H:V=1:30 V=1:5

