

120.04
SEPTIC
EXISTING SEPTIC SYSTEM


SUBLOT # 13

R/W CURVE DATA
 $\Delta = 06^{\circ}54'13''$
 $R = 2345.00'$
 $T = 141.45'$
 $L = 282.55'$
 $C = 282.38'$
N. $81^{\circ}36'34''$ W.


MOUNT ROYAL DRIVE 60'

N $88^{\circ}30'12''$ W

244.49'

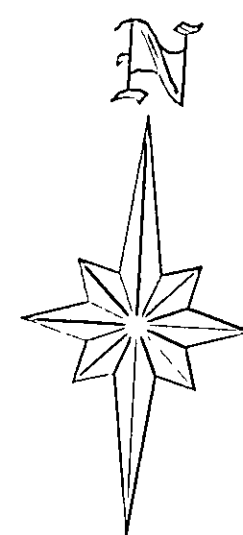

GRAPHIC SCALE

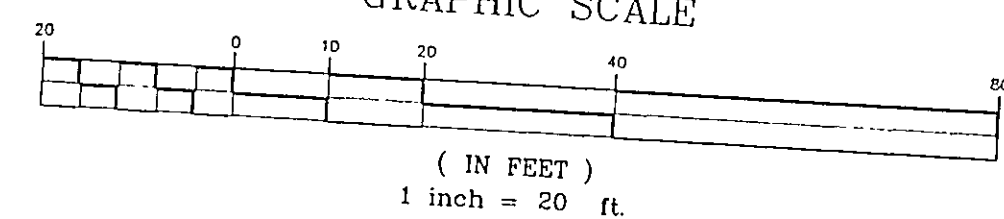

REVIEWED AND ACCEPTED
LAKE COUNTY GENERAL
HEALTH DISTRICT

Date: 2-11-97
Daniel B. Morris

SEWAGE DISPOSAL PERMIT MUST BE
OBTAINED BY A LAKE COUNTY LICENSED
INSTALLER BEFORE INSTALLATION IS
STARTED

SUBLOT # 15

Engineering Plan Approved
for record
GILES, P.E.
Survey Engineer

Date: 2-11-97

EXISTING PERMIT #0297-8632

ISSUED 2/10/97

FOR SET TO RECORD BY
Lake County Public Health ☐
Lake County Health Dept. ☒
Lake County Planning Dept. ☒

PRINTED
DEC 10 1996

REVISED E.T. FIELD TO 1200 LIN. FT.
PER LAKE COUNTY HEALTH DEPT.

Lake, Inc.
ENGINEERS & SURVEYORS
30601 EUGLID AVENUE NICKLIFFE, OHIO 44092
PHONE (216) 585-2100 FAX: (216) 585-5122

Rev. No.	Description	Date	By	CHK'D
	REVISED EVAPORATION TRANS. SYSTEM PER HEALTH DEPT.	12/01/96	D.Abbott	

SITE PLAN for
GNATURE HOMES Inc.
MOUNT ROYAL SUBDIVISION, CONCORD

Drawn By: D.Abbott
Filename: 96-124/96-124
Checked By:
Approved By:
Date: DEC. 2, 1996

SUBLOT # 14

Scale:	
Horiz. 1" = 20'	
Vert. 1" = 20'	
Sheet No.	Of
1	2