


HERMITAGE ROAD - 60'

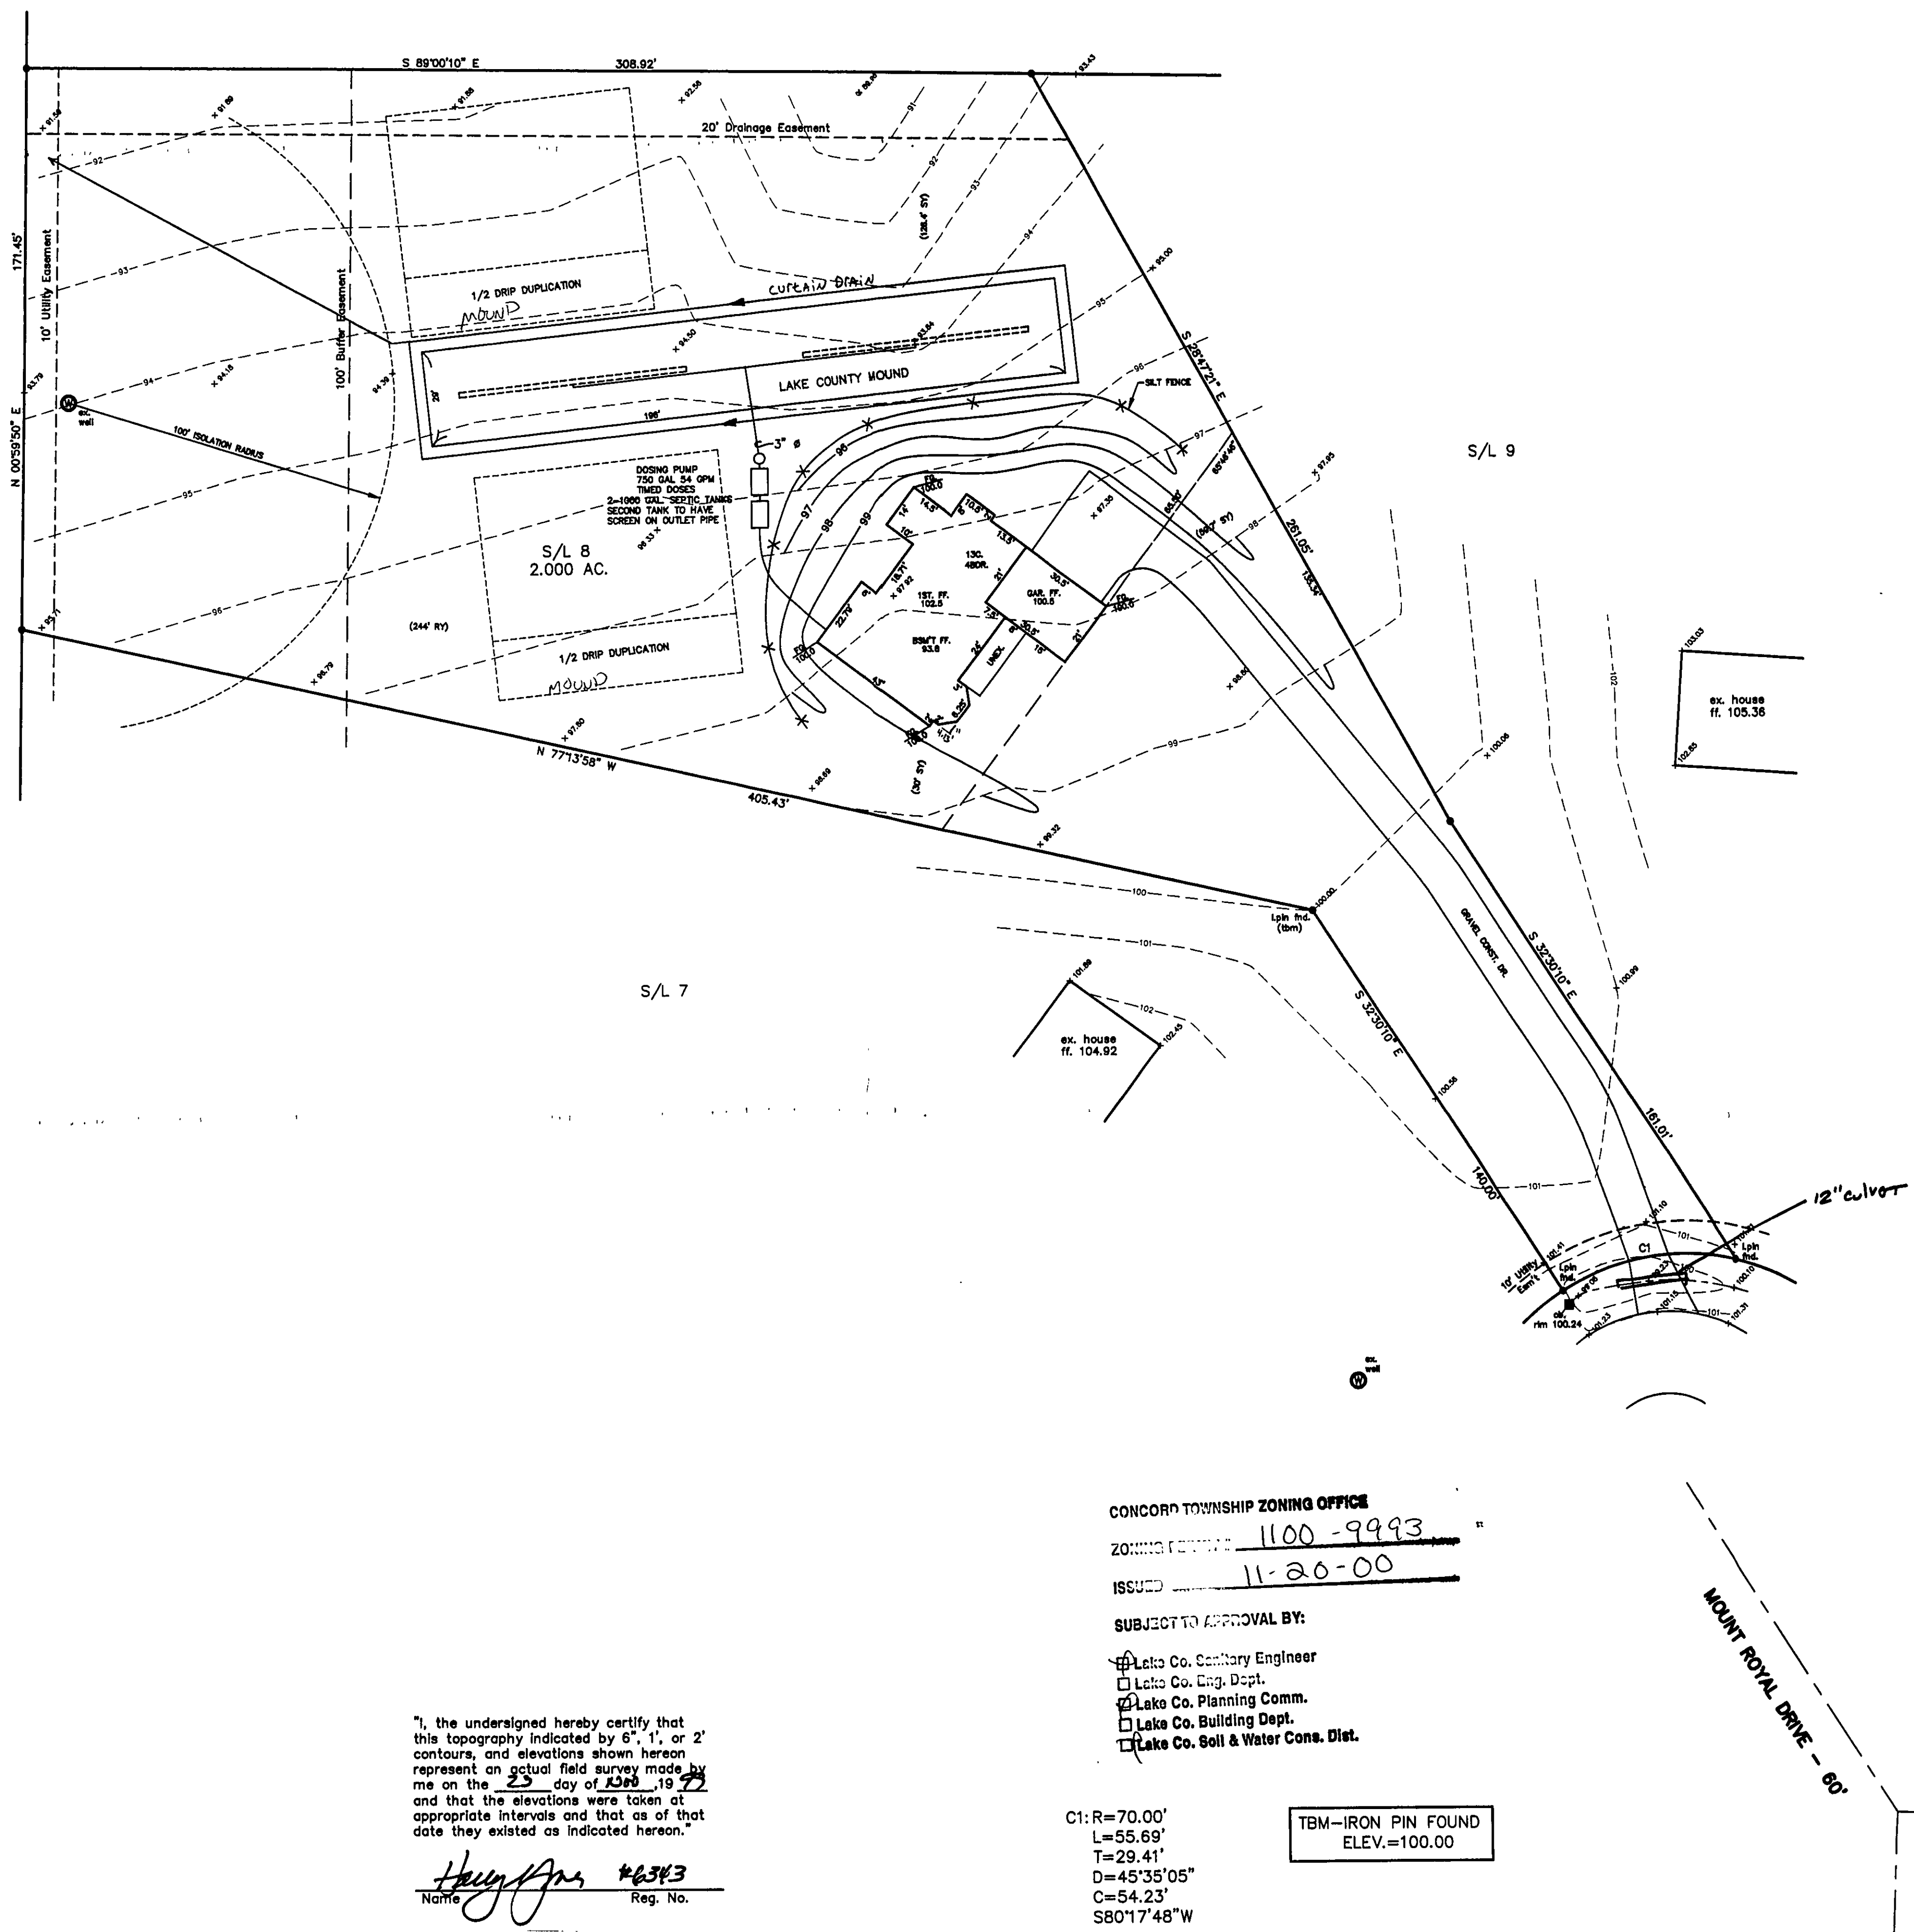

REVIEWED AND ACCEPTED
LAKE COUNTY GENERAL
HEALTH DISTRICT
Date 11-17-00 BY Daniel Land
Sewage system area must be roped off before house construction starts
SEWAGE DISPOSAL PERMIT MUST BE OBTAINED BY A LAKE COUNTY LICENSED INSTALLER BEFORE INSTALLATION IS STARTED

NOTE: TEMPORARY SEEDING REQUIRED IN DISTURBED AREAS.

CONCORD TOWNSHIP ZONING OFFICE
ZONING PERMIT 1100-9993
ISSUED 11-20-00
SUBJECT TO APPROVAL BY:
☒ Lake Co. Sanitary Engineer
☐ Lake Co. Eng. Dept.
☒ Lake Co. Planning Comm.
☐ Lake Co. Building Dept.
☐ Lake Co. Soil & Water Cons. Dist.

Grading Plan Approved as shown and/or noted
THOMAS P. GILLES, P.E.
Lake County Engineer
By TAM Date 11/21/00
12" ϕ DRIVE CULVERT ROOF DRAINS SHALL DISCHARGE TO SPLASH BLOCKS.

"I, the undersigned hereby certify that this topography indicated by 6", 1", or 2" contours, and elevations shown hereon represent an actual field survey made by me on the 25 day of June, 1999 and that the elevations were taken at appropriate intervals and that as of that date they existed as indicated hereon."
Harry Jones #6343
Name Reg. No.

C1: R=70.00'
L=55.69'
T=29.41'
D=45°35'05"
C=54.23'
S80°17'48"W
TBM-IRON PIN FOUND
ELEV.=100.00

REV NO.	DESCRIPTION	DATE	BY	CHK'D
1	REVISED SITE PLAN	11/3/00	TR	HJ
1	REVISED SITE PLAN	11/17/00	TR	HJ

bj BABCOCK, JONES AND ASSOCIATES, INC
CIVIL ENGINEERS - SURVEYORS - LAND PLANNERS
PAINESVILLE OHIO 44077

DATE 11/24/99
DESIGN BY H.J.
DRAWN BY T.R.
APPROVED BY H.J.

SITE PLAN
FOR
SHANDLE
S/L 8 MOUNT ROYAL SUBDIVISION
CONCORD TOWNSHIP LAKE COUNTY

