
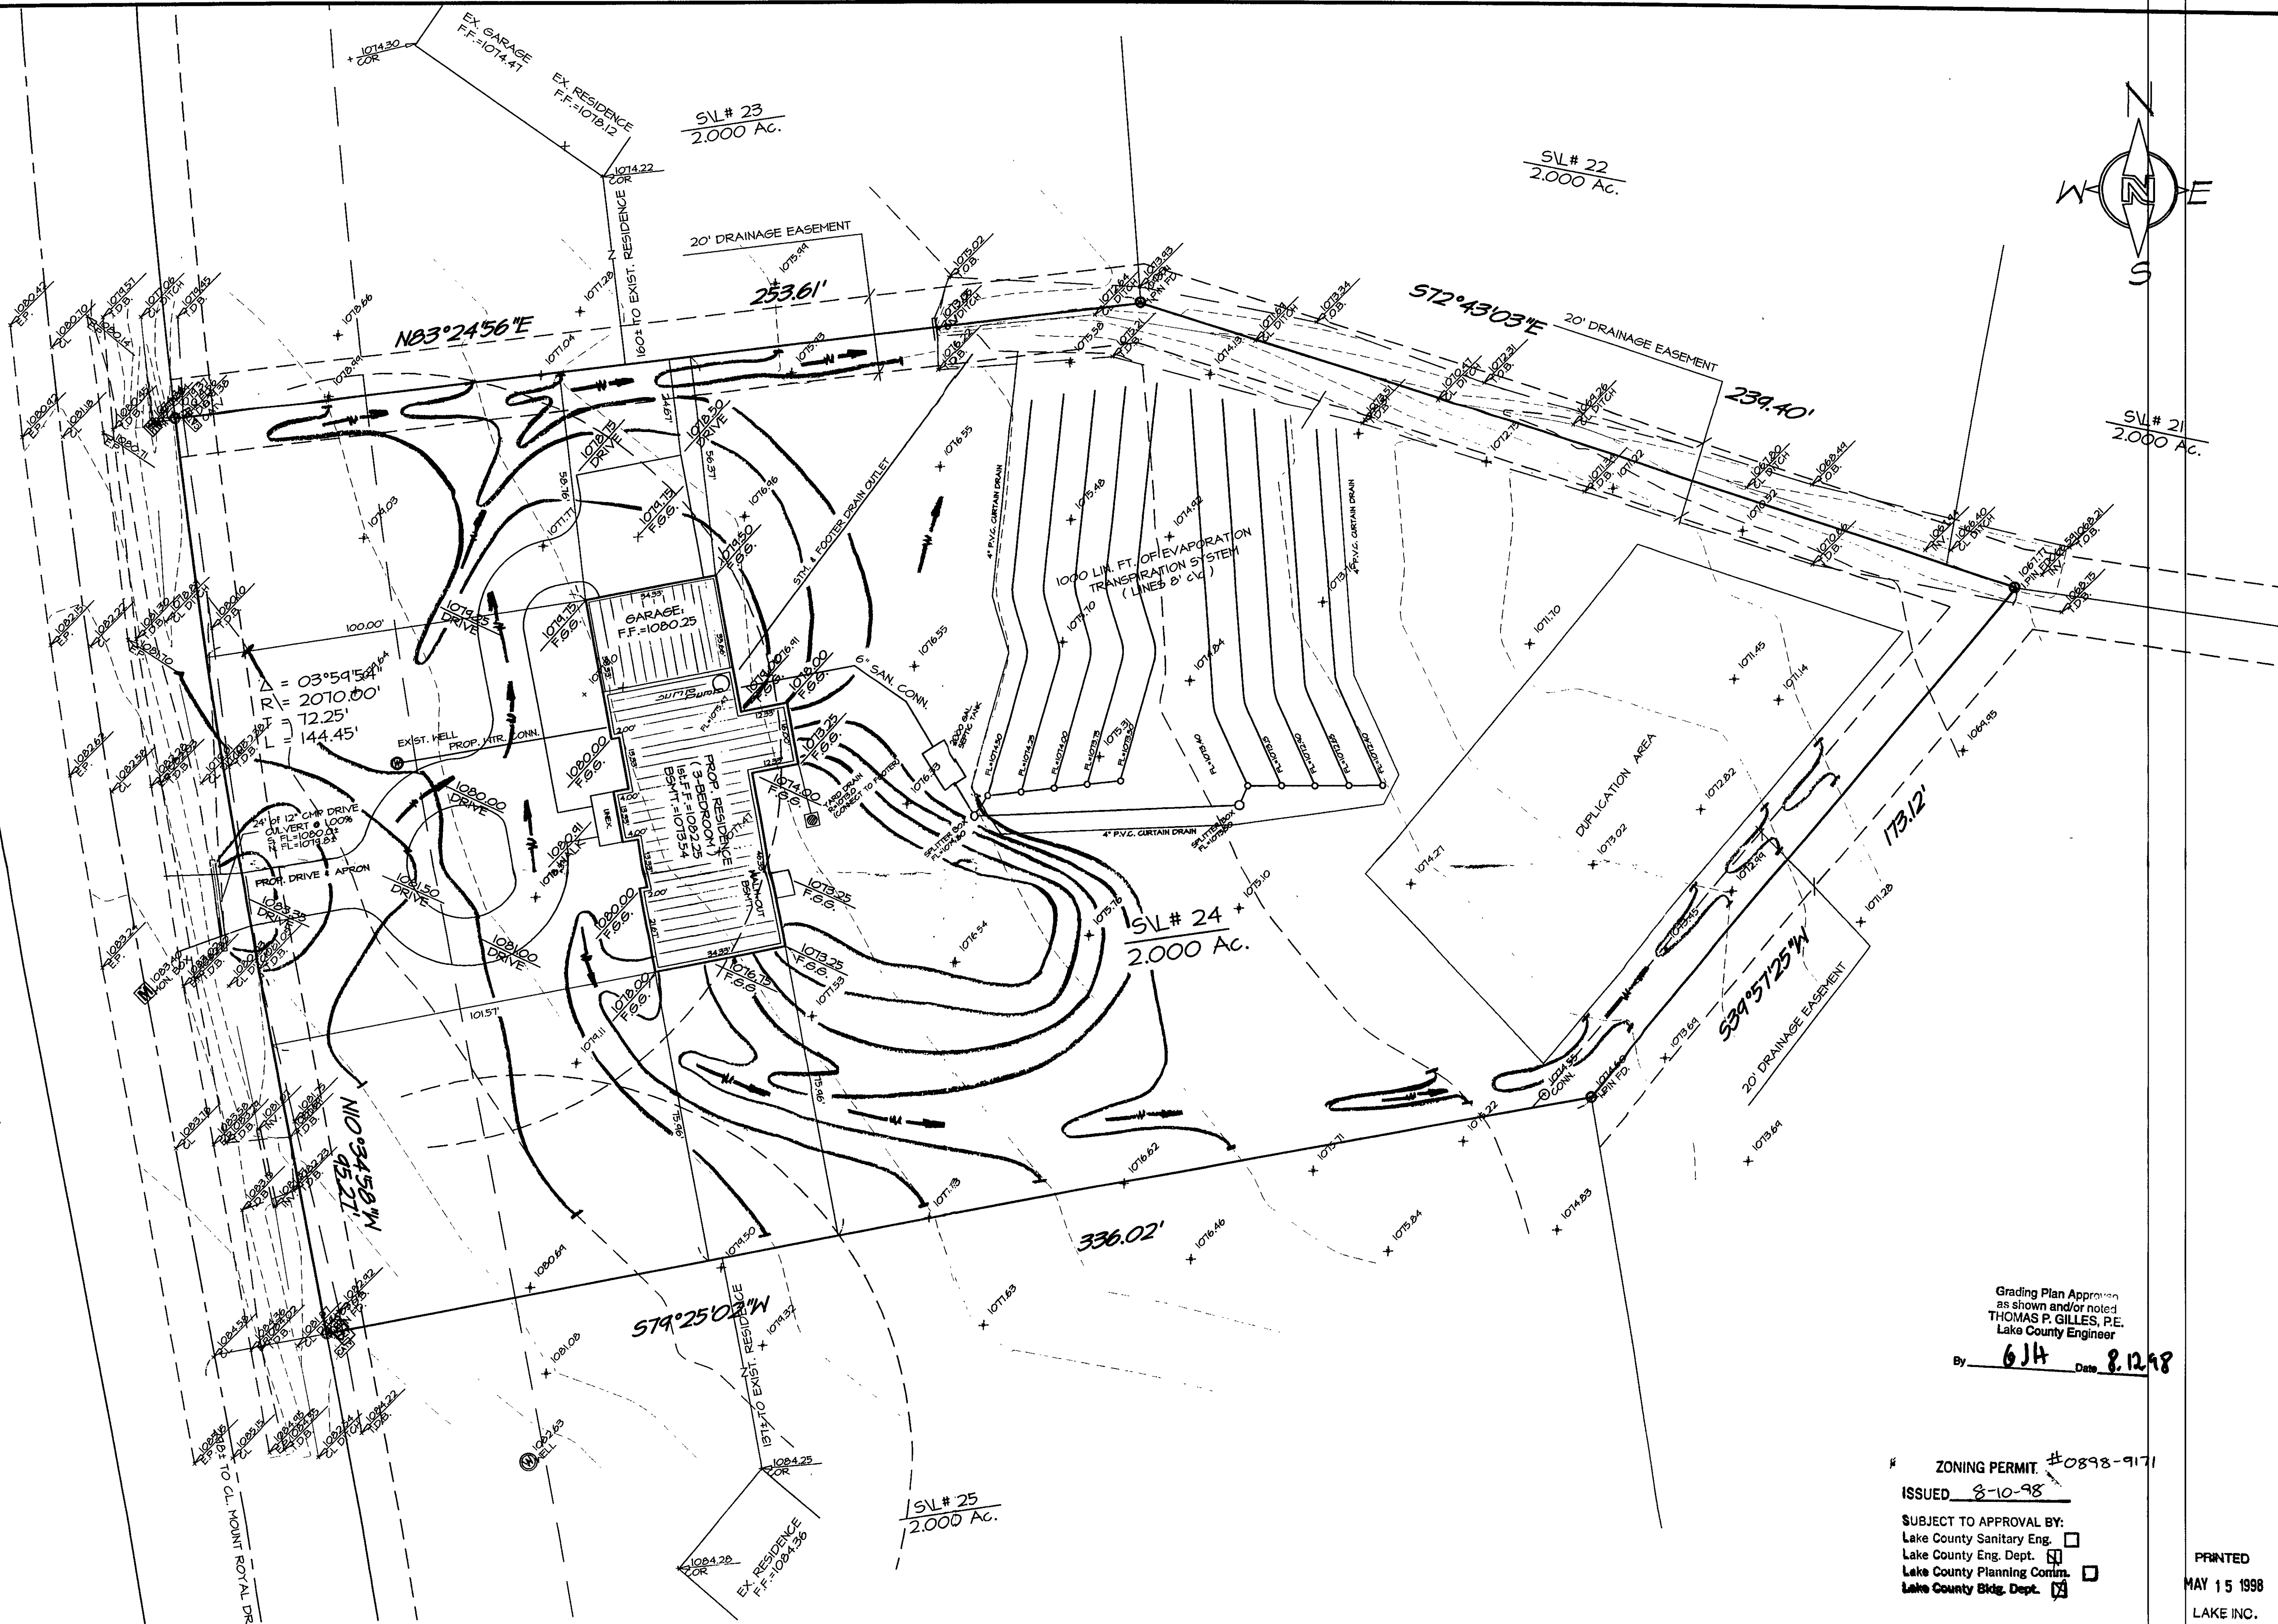


MOUNT ROYAL DRIVE 60'

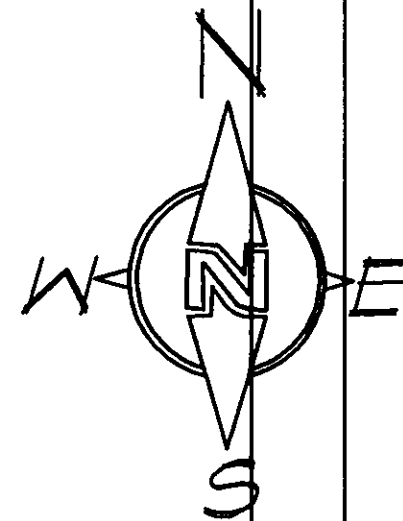

Grading Plan Approved
as shown and/or noted
THOMAS P. GILLES, P.E.
Lake County Engineer
By **6JH** Date **8.12.98**

ZONING PERMIT #0898-9171
ISSUED **8-10-98**
SUBJECT TO APPROVAL BY:
Lake County Sanitary Eng. ☐
Lake County Eng. Dept. ☒
Lake County Planning Comm. ☐
Lake County Bldg. Dept. ☒

PRINTED
MAY 15 1998
LAKE INC.



Rev. No.	Description	Date	By	CHK'D

PREPARED for
SIGNATURE HOMES Inc.
MOUNT ROYAL SUBD., CONCORD

Drawn By **D.Abbott**
Filename: **98-082**
Checked By:
Approved By:
Date: **MAY 7th, 1998**

SITE PLAN - S/L#24

Scale:	
1" = 20'	
1" = 5'	
Sheet No.	Of
1	2