

SITE PLAN

Calvin Township, Lake County, Ohio

For: Kay Jones

ADDRESS: _____ CITY: _____ ZIP: _____

Subdivision: 10-25-90 NAME: 10-25-90 LOT: _____ TRACT: _____
 SUBLOT NO.: 29 VOLUME: _____ PAGE: _____
 PERM. PARCEL NO.: _____ STREET: _____

LEGEND

SANITARY MANHOLE: WATER VALVE (GAS):
 STORM MANHOLE: WATER METER (GAS):
 INLET OR CATCH BASIN: AS BUILT ELEVATION:
 HYDRANT: EXISTING CONTOURS:
 PROPOSED CONTOURS:
 EXIST. ELEV.: 100.0 PROP. ELEV.:
 INDICATES DIRECTION OF SURFACE DRAINAGE:

REMARKS

ALL BOUNDARY DATA SHOWN WAS OBTAINED FROM IDEEDS, RECORDED SUBDIVISION PLAT OR OTHER PUBLIC RECORDS.
 LOCATIONS AS SHOWN OF ADJACENT WELLS AND SEPTIC TANKS OBTAINED FROM LAKE COUNTY HEALTH DEPARTMENT

DESIGN CERTIFICATION

THIS PLAT WAS PREPARED BY ME, AND IS CORRECT TO THE BEST OF MY KNOWLEDGE AND BELIEF

NAME: HARRY S. JONES, JR. SURVEYOR REGISTRATION NO.: 5-6343

CHECK LIST

NO. OF ROOMS: _____ WATER MAIN SIZE, LOCATION: _____
 DRAINAGE: _____ SAN. SEWER SIZE & GR. LOC.: _____
 THE TO NEAREST STREET: _____ SAN. IN. CATCH. ELEV. INV. ELEV.: _____
 SUBLOT NO. PARCEL NO.: _____ SAN. CORR. SIZE, LOC. DEPTH: _____
 SURROUNDING OWNERS: _____ BLDG. STORM SEWER SIZE & GR. LOC.: _____
 BLDG. TIES PLY. GRAD: _____ STORM IN. CATCH ELEV. INV. ELEV.: _____
 ABOVE TYPE GRADES: _____ PAVT TYPE GRADE CLIMB: _____
 SEPTIC TANK LOCATION & DUPPLICATION AREA: _____
 CULVERT TYPE DIA. LENGTH: _____ WELL LOCATION: _____
 ROCK OUTCROPPING: _____ ISOLATION RADII FROM WELL: _____

PLAN PREPARED BY: BABCOCK • JONES & ASSOCIATES, INC.

PAINEVILLE, OHIO

NO.	DATE	BY	SCALE	DATE	PHONE NO.
1			1" = 3'	10/26/90	357-1811
2					
3					
4					
5					

"AS BUILT" CERTIFICATION

I, HEREBY CERTIFY THAT THE CIRCLED GRADES ARE EXISTING FINISH GRADES CHECKED IN THE FIELD ON 19 AND ARE CORRECT TO THE BEST OF MY KNOWLEDGE AND BELIEF.

REGISTERED SURVEYOR

REG. NO.

THAT - L.M. SMITH
 EVER - 88808



ZONING PERMIT

ISSUED 10-25-90 #6647

SUBJECT TO APPROVAL BY:

Lake County Sanitary Eng. ☐
 Lake County Eng. Dept. ☒
 Lake County Planning Comm. ☐
 Lake County Bldg. Dept. ☒

Done & M. Moreno

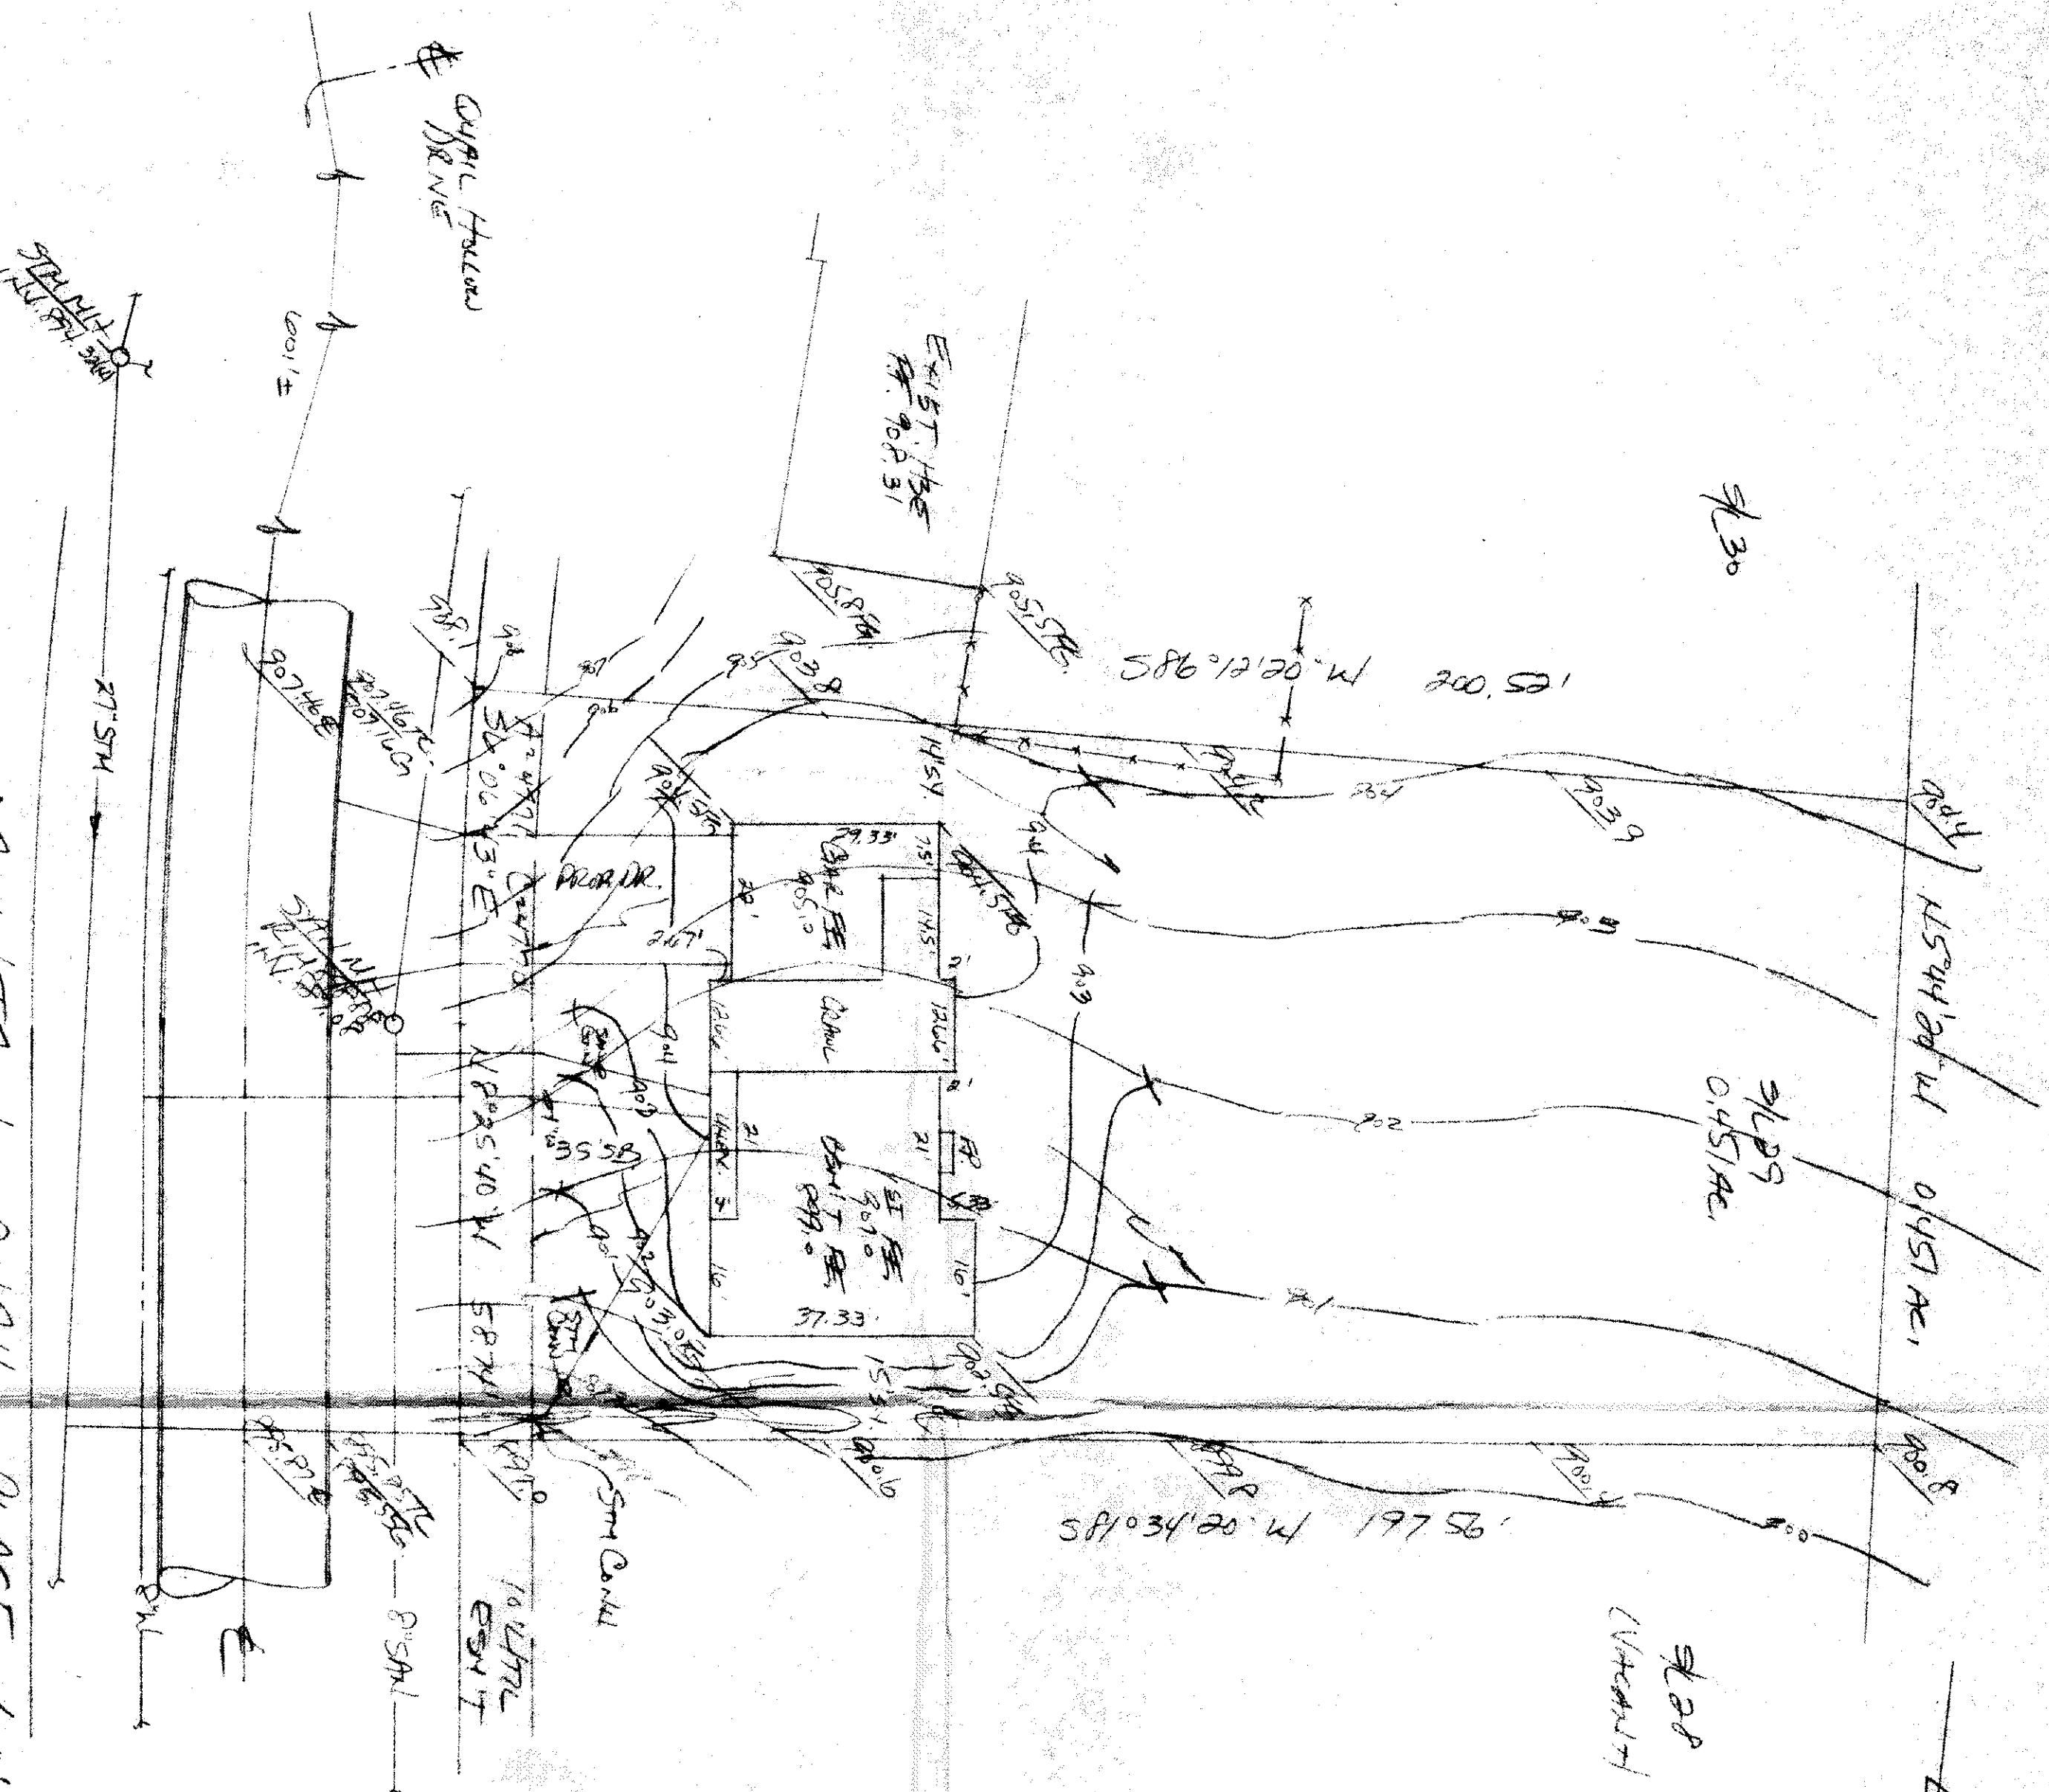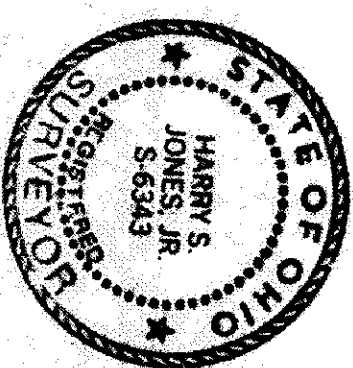

By: G.H. Jones Date: 10/26/90

MOULTON QUAIL PLACE - 60'