

SITE PLAN

Collected Township, Lake County, Ohio

for: WATERS CUSTOM HOMES

OWNER	ADDRESS	STREET	CITY	ZIP
DATE	SUBDIVISION			
LOT	TRACT			
VOLUME	PAGE			
PERMIT NO.	STREET			

LEGEND	WATER VALVE (GAS)	WATER METER (GAS)	AS BUILT ELEVATION
INDICATES DIRECTION OF SURFACE DRAINAGE			

REMARKS

ALL BOUNDARY DATA SHOWN WAS OBTAINED FROM (DEEDS, RECORDED SUBDIVISION PLAT OR OTHER PUBLIC RECORD)

LOCATIONS AS SHOWN OF ADJACENT WELLS AND SEPTIC TANKS OBTAINED FROM LAKE COUNTY HEALTH DEPARTMENT

DESIGN CERTIFICATION

THIS PLAT WAS PREPARED BY ME, AND IS CORRECT TO THE BEST OF MY KNOWLEDGE AND BELIEF

NAME: Harry S. Jones, Jr. SUPERVISOR REGISTRATION NO. 6313

CHECK LIST

NO. OF BEDROOMS	WATER MAIN SIZE, LOCATION
NO. OF BATHS	SEWER MAIN SIZE, LOCATION
NO. OF GARAGES	STORM MAIN SIZE, LOCATION
NO. OF DRIVEWAYS	STORM MAIN SIZE, LOCATION
NO. OF PORCHES	STORM MAIN SIZE, LOCATION
NO. OF PATIOS	STORM MAIN SIZE, LOCATION
NO. OF TERRACES	STORM MAIN SIZE, LOCATION
NO. OF STAIRS	STORM MAIN SIZE, LOCATION
NO. OF ROADS	STORM MAIN SIZE, LOCATION
NO. OF RAILROADS	STORM MAIN SIZE, LOCATION
NO. OF AIRPORTS	STORM MAIN SIZE, LOCATION
NO. OF CANALS	STORM MAIN SIZE, LOCATION
NO. OF DITCHES	STORM MAIN SIZE, LOCATION
NO. OF FLOOD PLAINS	STORM MAIN SIZE, LOCATION
NO. OF SWAMP LANDS	STORM MAIN SIZE, LOCATION
NO. OF OTHER FEATURES	STORM MAIN SIZE, LOCATION

PLAN PREPARED BY:

BABCOCK & JONES & ASSOCIATES, INC.

PAINEVILLE, OHIO

NO.	DATE	BY
1		
2		
3		
4		
5		

"AS BUILT" CERTIFICATION


I, HEREBY CERTIFY THAT THE CIRCLED GRADES ARE EXISTING FINISH GRADES CHECKED IN THE FIELD ON 19

AND ARE CORRECT TO THE BEST OF MY KNOWLEDGE AND BELIEF.

REGISTERED SURVEYOR REG. NO.

764 - Rm 504 MH


ETED - 917.99

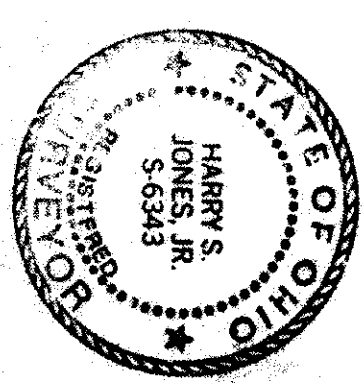

Grading Plan Approved

By GUH Date 12/12/90

1. Connect Sump Pump to Storm Sewer Connection.

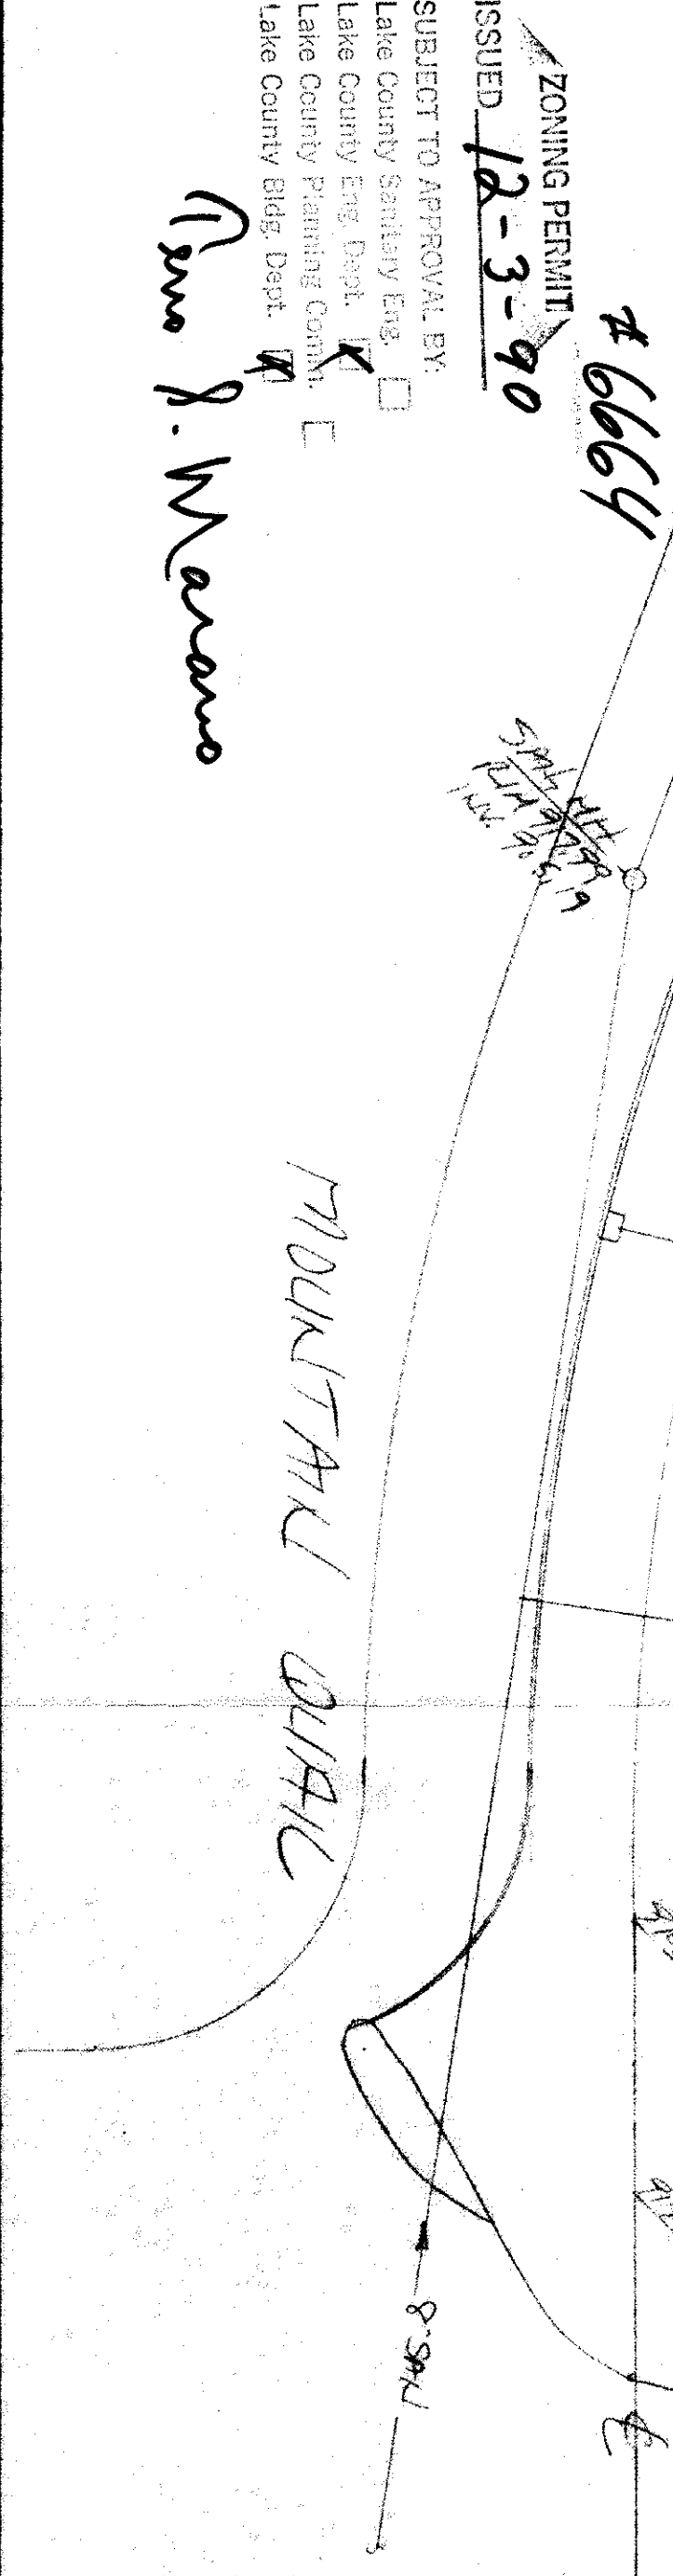

ZONING PERMIT

ISSUED 12-3-90

46664

SUBJECT TO APPROVAL BY:

☐ Lake County Sanitary Eng.

☐ Lake County Eng. Dept.

☐ Lake County Planning Comm.

☐ Lake County Bldg. Dept.

James J. McNamee