

SITE PLAN

LOCATED TOWNSHIP, LAKE COUNTY, OHIO

for: E.L. MOORE HOMES INC.

7435 Mt. Pleasant

LAKE COUNTY, OHIO

OWNER: E.L. MOORE HOMES INC. #2
SUBDIVISION: 111
VOLUME: 111
PAGE: 1
SHEET NO.: 1
SHEET PLACE: STREET PLACE

LEGEND

SANITARY MANHOLE
STORM MANHOLE
INLET ON CATCH BASIN
HYDRANT
EXISTING CONTOURS
PROPOSED CONTOURS
EXIST. ELEV.
PROPOSED ELEV.
WATER VALVE (GAS)
WATER METER (GAS)
AS BUILT ELEVATION
INDICATES DIRECTION OF SURFACE DRAINAGE

REMARKS

ALL BOUNDARY DATA SHOWN WAS OBTAINED FROM IDEOS, RECORDED SUBDIVISION PLAT ON OTHER PUBLIC RECORDS
LOCATIONS AS SHOWN OF ADJACENT WELLS AND SEPTIC TANKS OBTAINED FROM LAKE COUNTY HEALTH DEPARTMENT

DESIGN CERTIFICATION

THIS PLAT WAS PREPARED BY ME, AND IS CORRECT TO THE BEST OF MY KNOWLEDGE AND BELIEF.

DATE: 9-12-90 SURVEYOR REGISTRATION NO. 88-158-64

CHECK LIST

NO. OF BEDROOMS
BATHROOMS
TIE TO NEAREST STREET
SUBJECT OF NO. PARCEL NO.
SURROUNDING OWNERS
BLDG. CHANGING F.M. 90.
BLDG. TYPE, GRADES
ADJACENT TYPE, THICKNESS
SEPTIC TANK LOCATION & DUPPLICATION AREA
WELL LOCATION
ISOLATION RADIUS FROM WELL

PLAN PREPARED BY:

BABCOCK • JONES & ASSOCIATES, INC.

PAINEVILLE, OHIO

NO.	DATE	BY
1		
2		
3		
4		
5		

NO. OF BEDROOMS	WATER MAIN SIZE, LOCATION
BATHROOMS	SAN. SEWER SIZE, % GR. LOC.
TIE TO NEAREST STREET	SAN. IN. CAST. ELEV. INV. ELEV.
SUBJECT OF NO. PARCEL NO.	SAN. CONN. SIZE, LOC. DEPTH
SURROUNDING OWNERS	STORM IN. CAST ELEV. INV. ELEV.
BLDG. CHANGING F.M. 90.	PAV'T TYPE GRADE CURBS
BLDG. TYPE, GRADES	4" LINE LOC. SIZE PRESSURE
ADJACENT TYPE, THICKNESS	SEPTIC TANK LOCATION & DUPPLICATION AREA
SEPTIC TANK LOCATION & DUPPLICATION AREA	WELL LOCATION
WELL LOCATION	ISOLATION RADIUS FROM WELL

"AS BUILT" CERTIFICATION

I, HEREBY CERTIFY THAT THE CIRCLED GRADES ARE EXISTING FINISH GRADES CHECKED IN THE FIELD ON 19 19 AND ARE CORRECT TO THE BEST OF MY KNOWLEDGE AND BELIEF.

REGISTERED SURVEYOR

REG. NO.

T.B.M. E.L. MOORE HOMES, ELEV. = 920.08


ZONING PERMIT #6603

ISSUED 9-14-90

SUBJECT TO APPROVAL BY:

Lake County Sanitary Eng. ☐
Lake County Eng. Dept. ☒
Lake County Planning Comm. ☐
Lake County Bldg. Dept. ☒

Grading Plan Approved as shown and/or noted
THOMAS P. GILLES, P.E.
Lake County Engineer
By: G.H. Date: 9-14-90
1. DISCHARGE Sump pump TO ST.M. SEWER.
Temo J. Marano

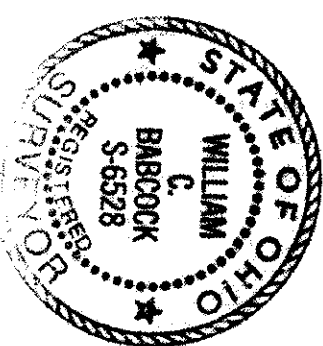

WHITE TAIL RUNT PLACE

MOUNTAIN QUAIL PLACE - 60'

