

SITE PLAN

CONCORD TOWNSHIP, LAKE COUNTY, OHIO

FOR: KAY HOMES

ADDRESS: STREET CITY ZIP

SWALE HOLLOW SUBDIVISION

LOT 13

LOT 13

LEGEND

WATER VALVE (GAS)	WATER METER (GAS)	AS BUILT ELEVATION	INDICATES DIRECTION OF SURFACE DRAINAGE
STORM MANHOLE	INLET OR CATCH BASIN	HYDRANT	EXISTING CONTOURS
PROPOSED CONTOURS	EXIST. ELEV.	PROPOSED ELEV.	

REMARKS

ALL BOUNDARY DATA SHOWN WAS OBTAINED FROM DEEDS, RECORDED SUBDIVISION PLAT OR OTHER PUBLIC RECORDS.
LOCATIONS AS SHOWN OF ADJACENT WELLS AND SEPTIC TANKS OBTAINED FROM LAKE COUNTY HEALTH DEPARTMENT

DESIGN CERTIFICATION

THIS PLAT WAS PREPARED BY ME, AND I DO CERTIFY TO THE BEST OF MY KNOWLEDGE AND BELIEF

NAME: HARRY S. JONES, JR. S-6343

CHECKLIST

NO. OF BEDROOMS	NO. OF BATHS	NO. OF GARAGES	NO. OF POOLS	NO. OF DECKS	NO. OF PATIOS	NO. OF PORCHES	NO. OF STAIRS	NO. OF ELEVATORS	NO. OF OTHER FEATURES
1	1	1	0	0	0	0	0	0	0

PLAN PREPARED BY:

BABCOCK • JONES & ASSOCIATES, INC.

PAINESVILLE, OHIO

NO.	DATE	BY	SCALE	DATE	BY	PROJECT NO.	DRAWING NO.
1	8-8-90	BY	1" = 20'	8-8-90	BY	357-1811	
2	8-8-90	BY	1" = 20'	8-8-90	BY	357-1811	
3	8-8-90	BY	1" = 20'	8-8-90	BY	357-1811	
4	8-8-90	BY	1" = 20'	8-8-90	BY	357-1811	
5	8-8-90	BY	1" = 20'	8-8-90	BY	357-1811	

"AS BUILT" CERTIFICATION

I, HEREBY CERTIFY THAT THE CIRCLED GRADES ARE EXISTING FINISH GRADES CHECKED IN THE FIELD ON 19 19

REGISTERED SURVEYOR

REG. NO.

T.B.M.: 21M SAN M.H. & MOUNTAIN QUAIL + WHITE TAIL RUN, ELEV. = 920.08

ZONING PERMIT

6566

ISSUED 8-8-90

SUBJECT TO APPROVAL BY:


- ☐ Lake County Sanitary Eng.
- ☐ Lake County Eng. Dept.
- ☐ Lake County Planning Comm.
- ☐ Lake County Bldg. Dept.

1. Convert sump pump to storm sewer lateral.

By: G.H.

Date: 8/10/90

Creating Plan Approved
JAS P. GILLES, P.E.
Lake County Engineer

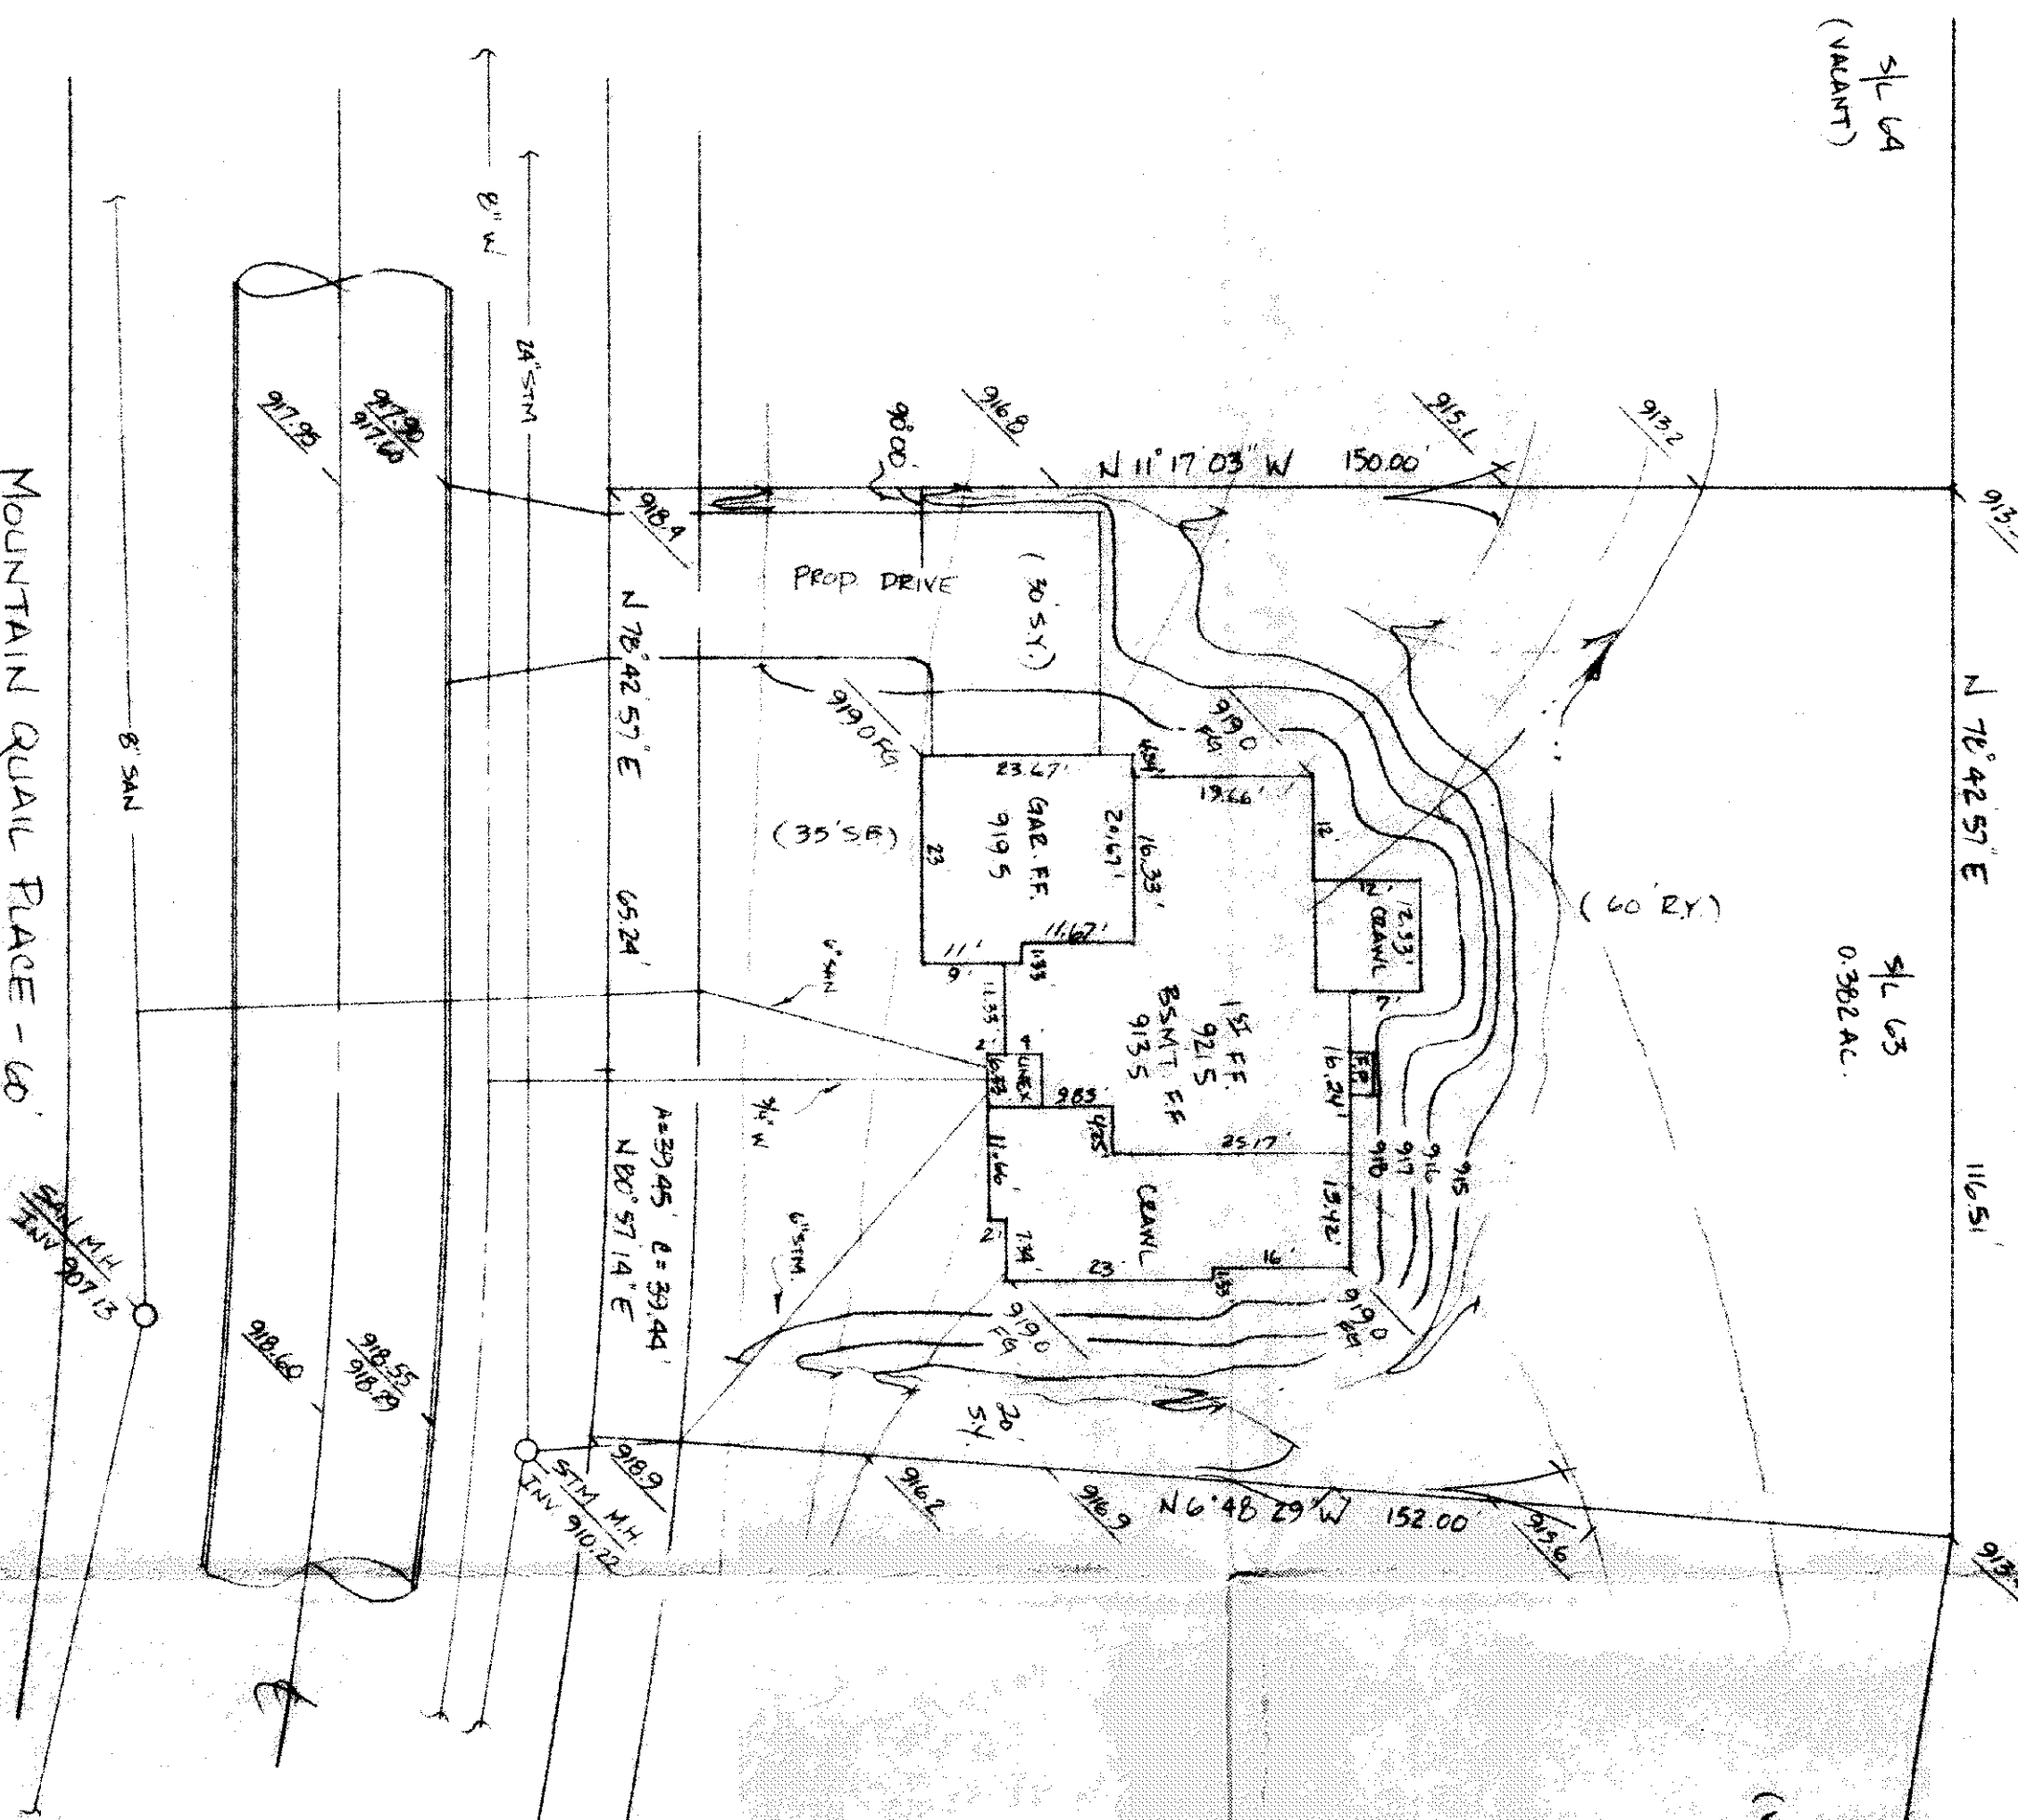

MOUNTAIN QUAIL PLACE - 60'