


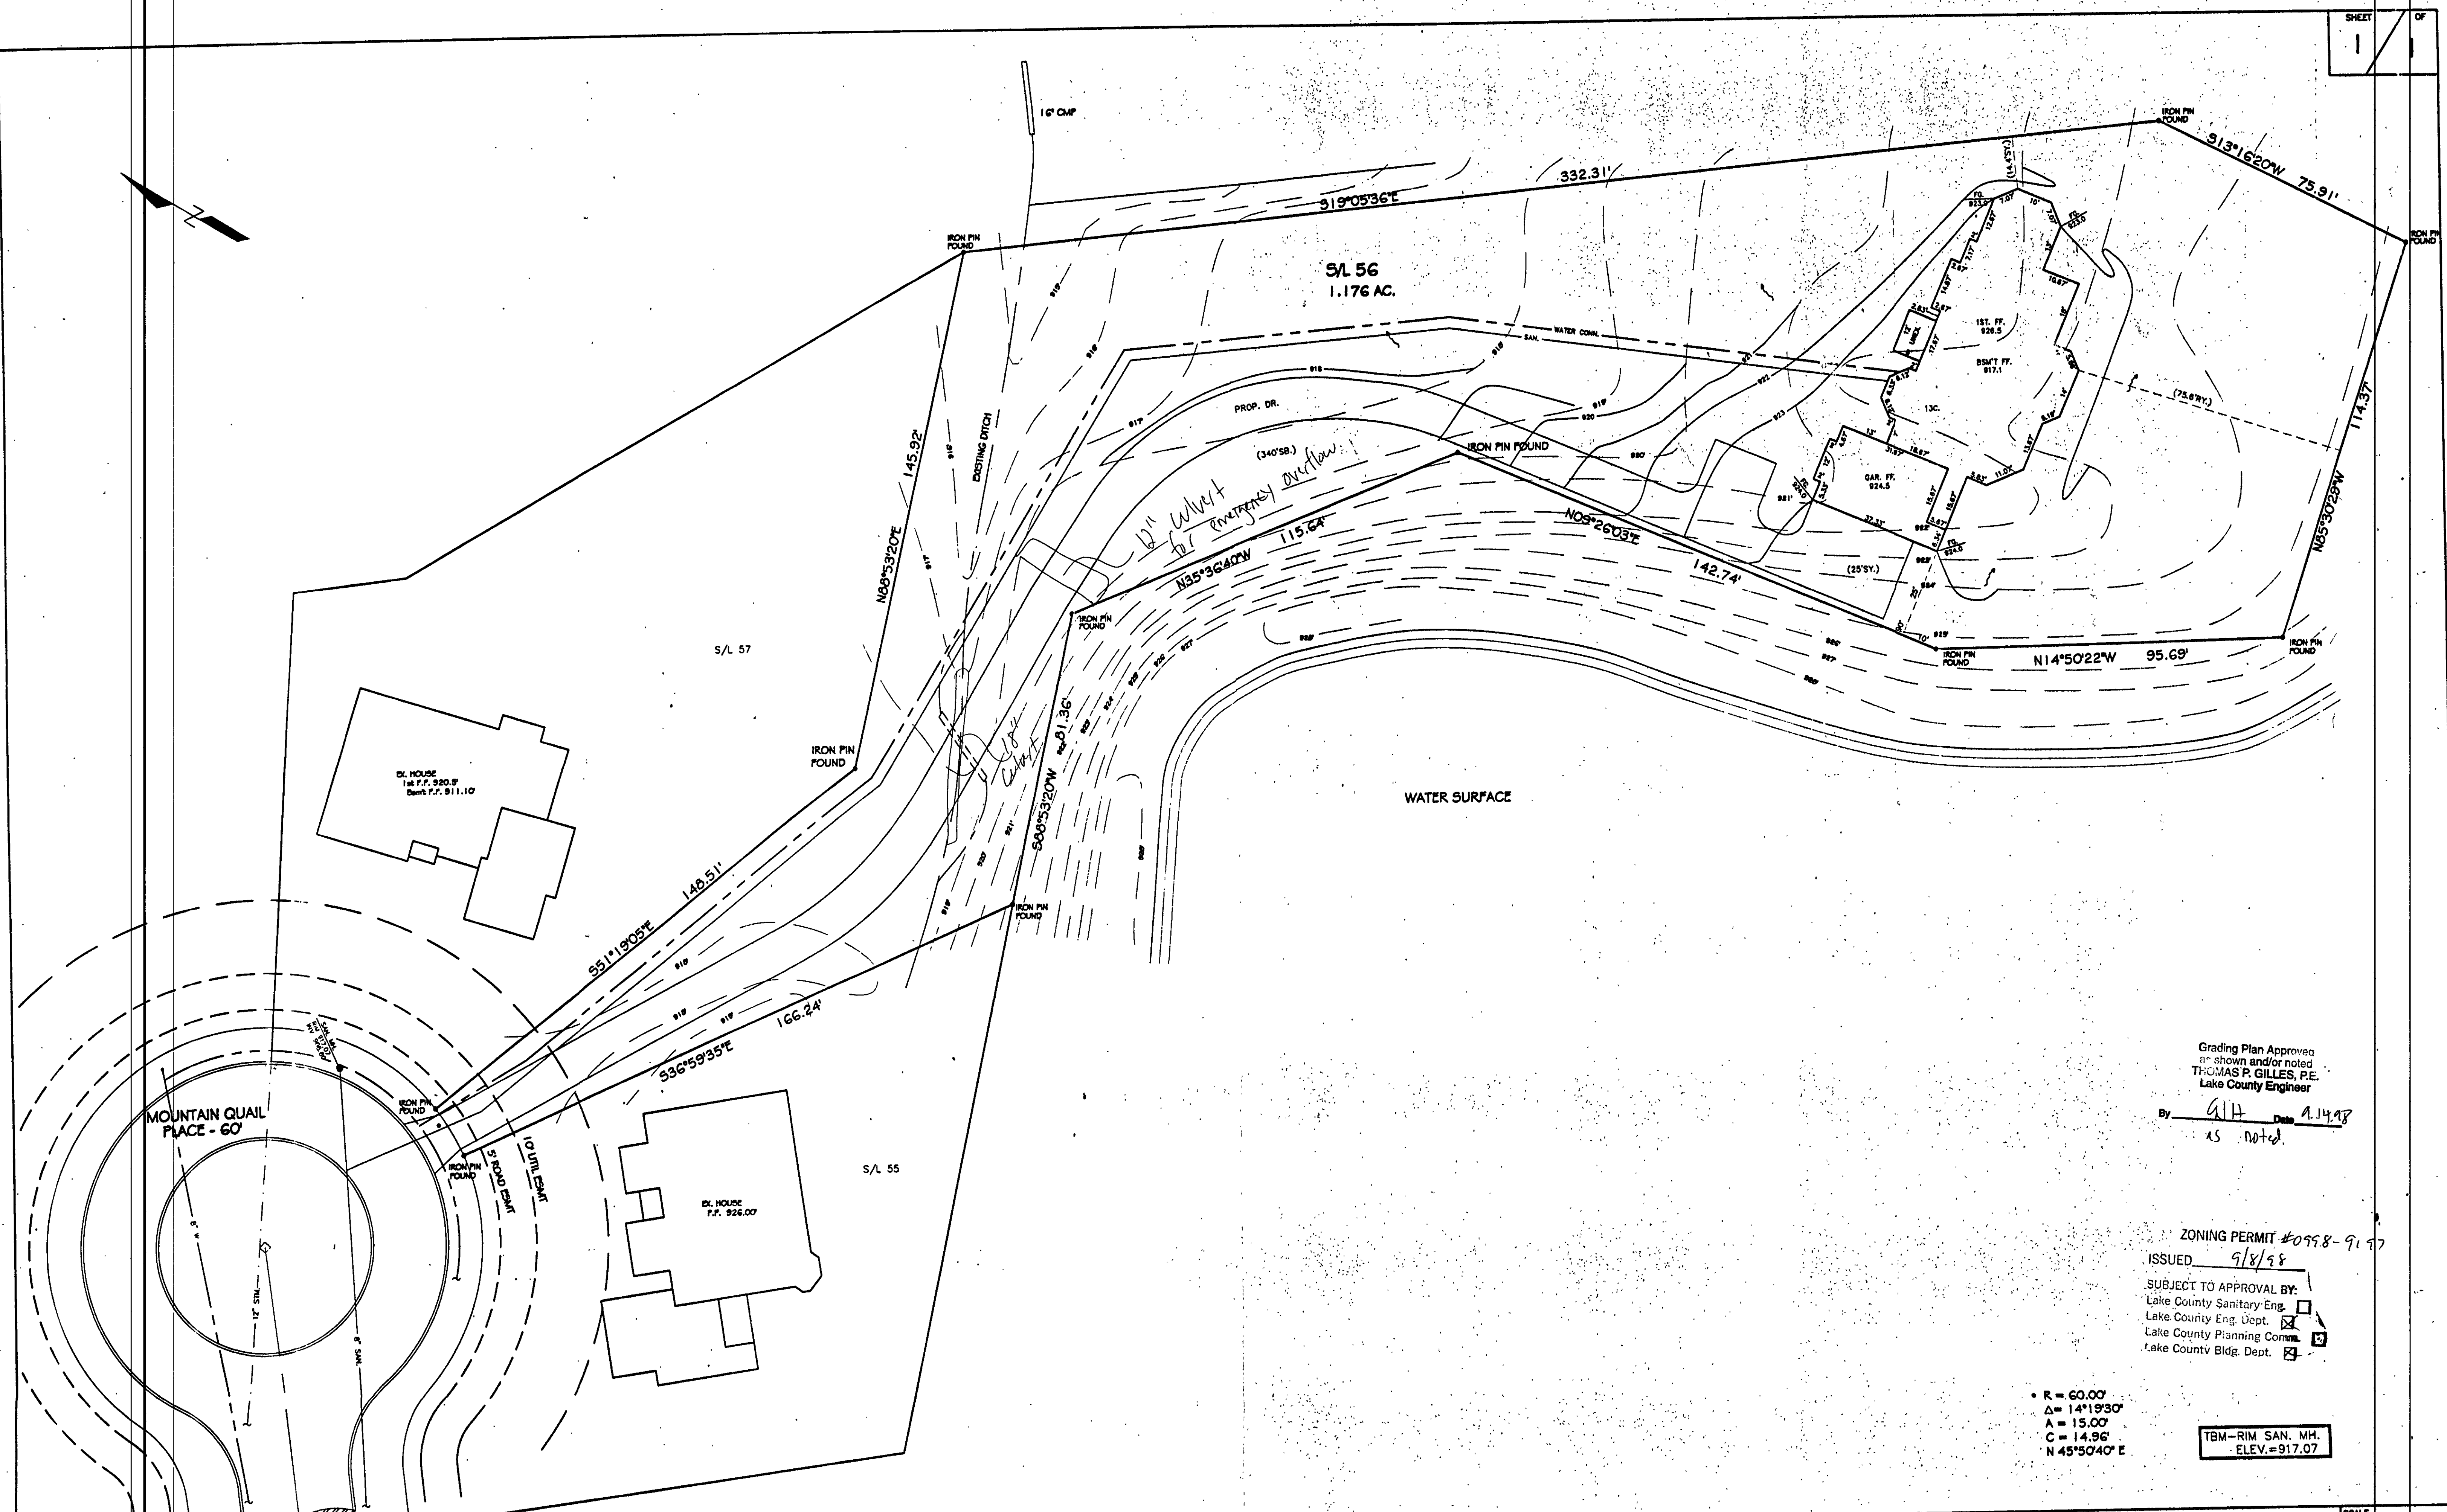

Grading Plan Approved
as shown and/or noted
THOMAS P. GILLES, P.E.
Lake County Engineer
By G.H. Date 9.14.98
AS NOTED

ZONING PERMIT #0998-9197
ISSUED 9/8/98
SUBJECT TO APPROVAL BY:
Lake County Sanitary Eng. ☐
Lake County Eng. Dept. ☒
Lake County Planning Comm. ☒
Lake County Bldg. Dept. ☒

• R = 60.00'
Δ = 14°19'30"
A = 15.00'
C = 14.96'
N 45°50'40" E

TBM-RIM SAN. MH.
ELEV.=917.07

REV. NO.	DESCRIPTION	DATE	BY	CHK'D
1	ADDED HOUSE & UTILITIES	5/21/98	H.J.	H.J.
2	REVISED HOUSE DIMENSIONS	6/03/98	TR.	H.J.

bj BABCOCK, JONES AND ASSOCIATES, INC
CIVIL ENGINEERS - SURVEYORS - LAND PLANNERS
PAINESVILLE OHIO 44077

DATE 7/31/97
DESIGN BY H.J.
DRAWN BY M.S. & T.R.
APPROVED BY H.J.

SITE PLAN
for
SUBLOT 56
for
Michael Burk
Concord Twp.
Lake County, Ohio