
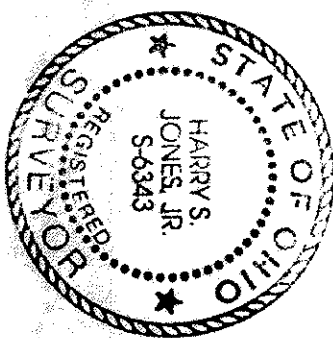


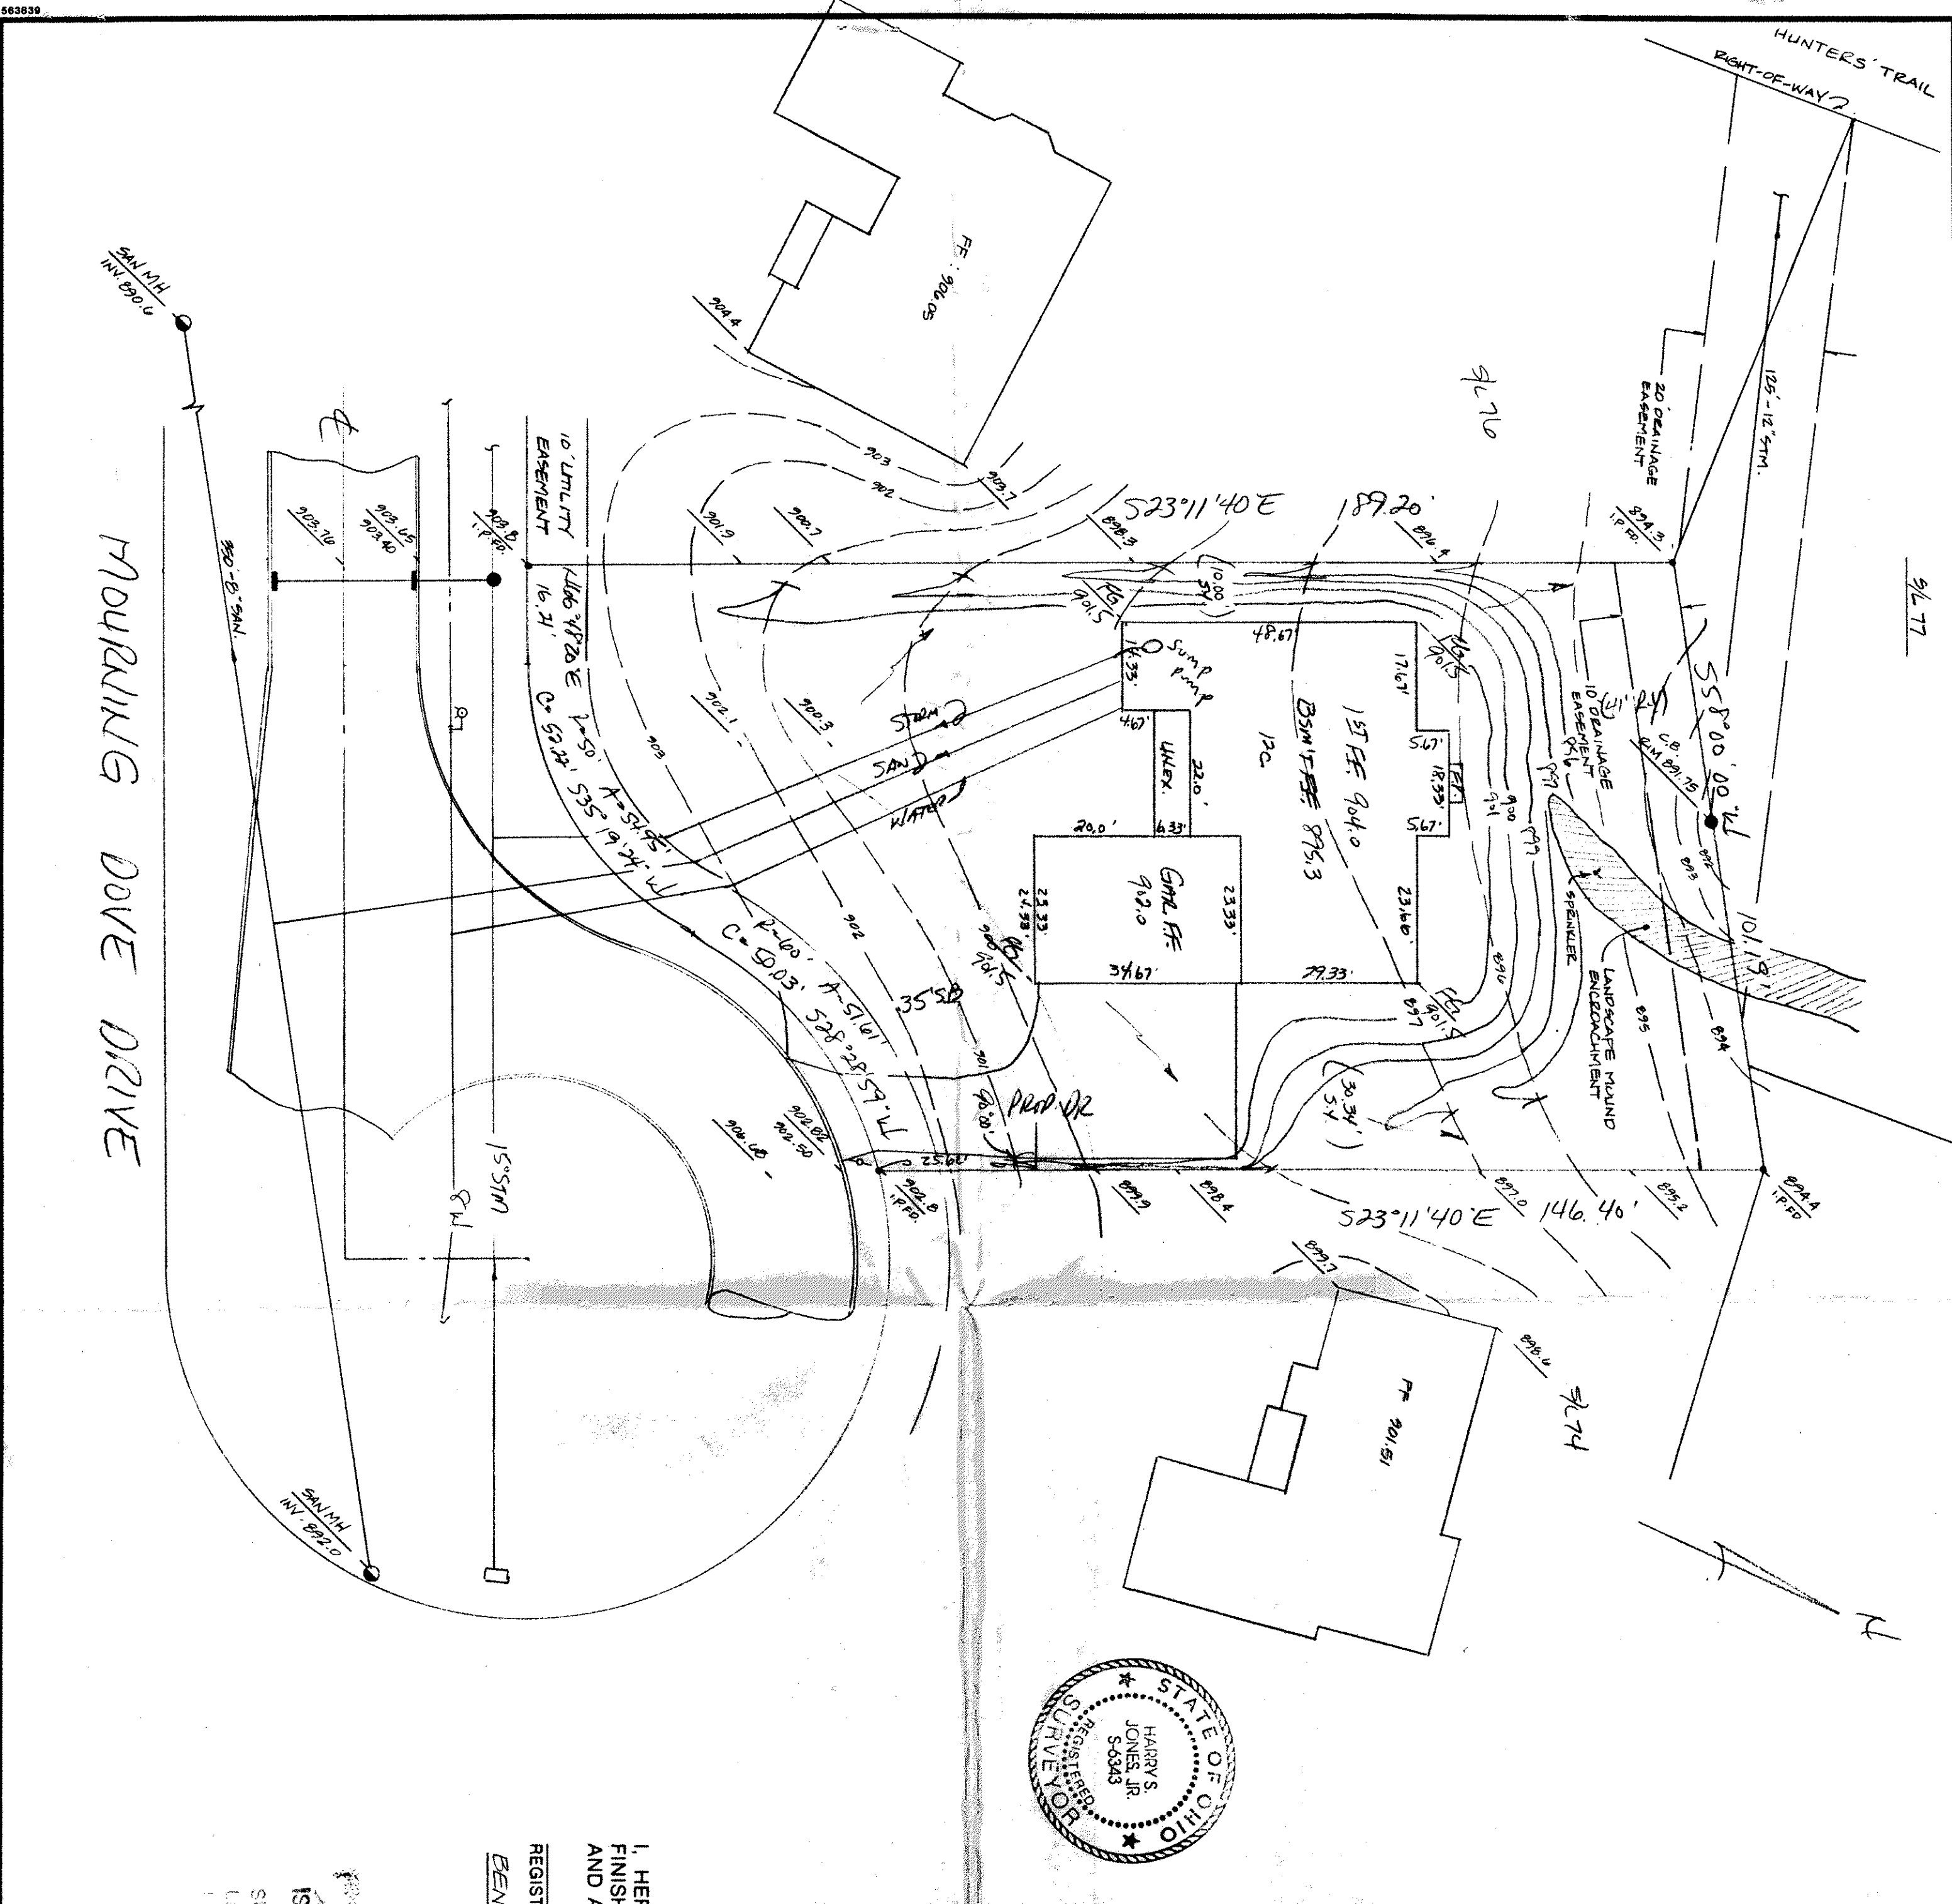

SITE PLAN

Collego Township, Lake County, Ohio

for: Leithner - Hill Building, Inc.

ADDRESS: _____ STREET: _____ CITY: _____ ZIP: _____

Subdivision: 10-44 NAME: Quail Hollow Sub
Volume: 75 Page: 1
Sheet: 1 of 1 SHEET NO. _____

LEGEND	
	SANITARY MANHOLE
	STORM MANHOLE
	INLET OR CATCH BASIN
	HYDRANT
	EXISTING CONTOURS
	PROPOSED CONTOURS
	WATER VALVE (GAS)
	WATER METER (GAS)
	AS BUILT ELEVATION
	DIRECTION OF SURFACE DRAINAGE

REMARKS
ALL BOUNDARY DATA SHOWN WAS OBTAINED FROM IDEEDS, RECORDED
SUBDIVISION PLAT OR OTHER PUBLIC RECORDS
LOCATIONS AS SHOWN OF ADJACENT WELLS AND SEPTIC TANKS OBTAINED FROM
LAKE COUNTY HEALTH DEPARTMENT

DESIGN CERTIFICATION
THIS PLAT WAS PREPARED BY ME, AND IS CORRECT
TO THE BEST OF MY KNOWLEDGE AND BELIEF
NAME: Harry S. Jones, Jr. SURVEYOR REGISTRATION NO. 56343

CHECK LIST	
NO. OF BEDROOMS	WATER MAIN SIZE, LOCATION
DIMENSIONS	SAN. SEWER SIZE % GR. LOC.
BEARINGS	SAN. NH. CAST. ELEV. INV. ELEV.
TIE TO NEAREST STREET	SAN. CONN. SIZE, LOC. DEPTH
SUBJECT NO. PARCEL NO.	STORM SEWER SIZE % GR. LOC.
SURROUNDING OWNERS	BLDG. DIMENSIONS FIN. GR.
BLDG. DIMENSIONS FIN. GR.	PAYT TYPE GRADE CURBS
PAYT TYPE GRADE CURBS	APPROX. TYPE WIDTH THICKNESS
SEPTIC TANK LOCATION & DIRECTION	SEPTIC TANK LOCATION & DIRECTION
WELL LOCATION	WELL LOCATION
ROCK OUTCROPPING	ISOLATION RADIUS FROM WELL

REVISIONS	
NO.	DATE
1	BY
2	BY
3	BY
4	BY
5	BY

PLAN PREPARED BY:	DATE	SCALE	PHONE NO.
BABCOCK • JONES & ASSOCIATES, INC.	3/21/95	1" = 20'	357-1811
PAINEVILLE, OHIO	CHKD. BY	DATE	DRAWING NO.
	WJ	3/21/95	68-158-75
	CHIEF	WJ	

"AS BUILT" CERTIFICATION
I, HEREBY CERTIFY THAT THE CIRCLED GRADES ARE EXISTING
FINISH GRADES CHECKED IN THE FIELD ON _____ 19____
AND ARE CORRECT TO THE BEST OF MY KNOWLEDGE AND BELIEF.

REGISTERED SURVEYOR REG. NO. _____
BENCHMARK: TOP OF HYDRANT 5L 75, ELEV. = 906.50

ZONING PERMIT
ISSUED 4/22/95 BY 9495-81/5
SUBJECT TO APPROVAL BY: _____
Lake County Sanitary Eng. _____
Lake County Engineer _____
- Remove landscape mound for drainage.
ROOF DRAINS SHALL DISCHARGE TO SPLASH BLOCKS.