

for : TOM ACKERMAN CLIENT

2921 CATSBY LANE STREET WILLOUGHBY HILLS
ADDRESS CITY

CALL WOODS VOL. PAGE
SUBDIVISION NAME OHIO

SUBLOT No. 9 CONCORD 8,9,10
LOT TOWNSEND 1 TRACT

DESIGN CERTIFICATION

THIS PLAT WAS PREPARED BY ME, AND IS CORRECT TO THE BEST OF MY KNOWLEDGE AND BELIEF.

[illegible]

"AS BUILT" CERTIFICATION
I HEREBY CERTIFY THAT THE CIRCLED INFORMATION IS
EXISTING AS OBTAINED ON THE SITE _____
1984 AND IS CORRECT TO THE BEST OF MY KNOWLEDGE
AND BELIEF.

LEGEND STEIN MANHOLE SANITARY MANHOLE EXISTING CONDITIONS PROPOSED CONDITIONS		DRAWN BY G.S.V./J.B.R.	SCALE 1"=30'-0"
DIRT, ELEV. 10.0 F.6100.0 = PROP. ELEV.		CHECK'D BY	DATE SEPT., 1998
DIRECTION OF SURFACE DRAINAGE		1	2

BENCHMARK B.M.=T.B.M. SET ON TOP OF
HYDRANT LOCATED IN
FRONT OF S/L 9, NANCY
ANN DRIVE; E1927.25

EXISTING UNDERGROUND UTILITIES NOTE: THE LOCATION, BOTH HORIZONTAL AND VERTICAL, OF THE UNDERGROUND UTILITIES SHOWN HEREON, HAS BEEN OBTAINED BY A DILIGENT AND COMPREHENSIVE SEARCH OF AVAILABLE RECORDS. VERIFICATION BY FIELD OBSERVATION HAS BEEN CONDUCTED WHERE PRACTICAL. HOWEVER, LDC INC. DOES NOT GUARANTEE THE COMPLETENESS NOR ACCURACY THEREOF.

ISSUED 10/27/64
SUBJECT TO APPROVAL BY:
Lake County Sanitary Eng. ☐
Lake County Eng. Dept. ☒
Lake County Planning Comm. ☐
Lake County Blgd. Dept. ☒

500 GALLON DOSING TANK



SECTION A-A

ALTERNATE DUPLICATE SPRINKLER PUMPS
 4500 G.P.M. 100 G.P.M. 100 G.P.M.

HWB

DWG. NAME





ACKET1-9602

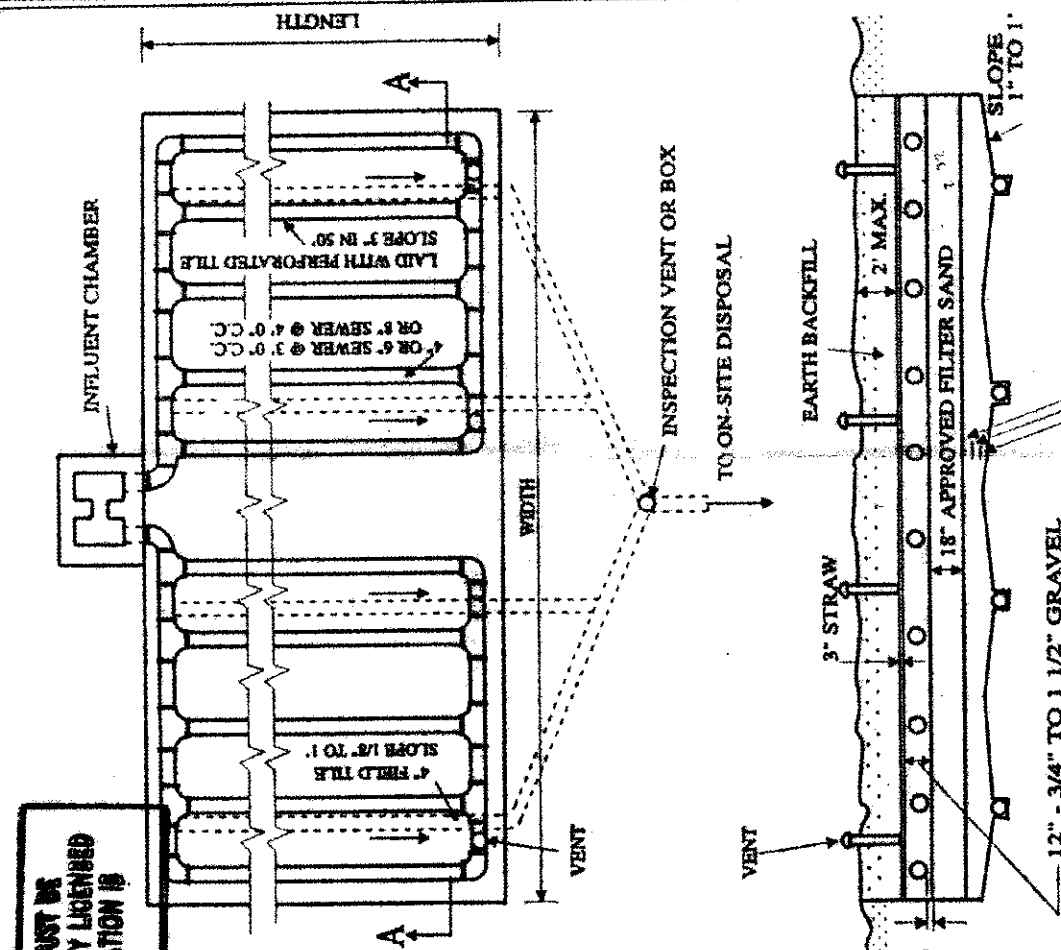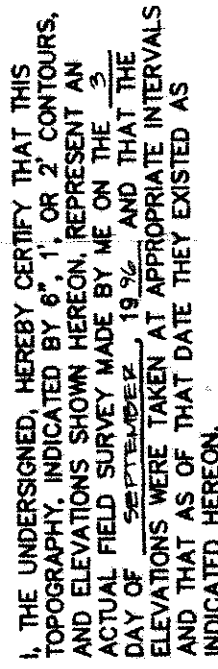






SUBSURFACE SAND FILTERS

**LOW YIELD WATER
FIXTURES REQUIRED**

B. No footer drains or downspouts to be discharged into septic tanks

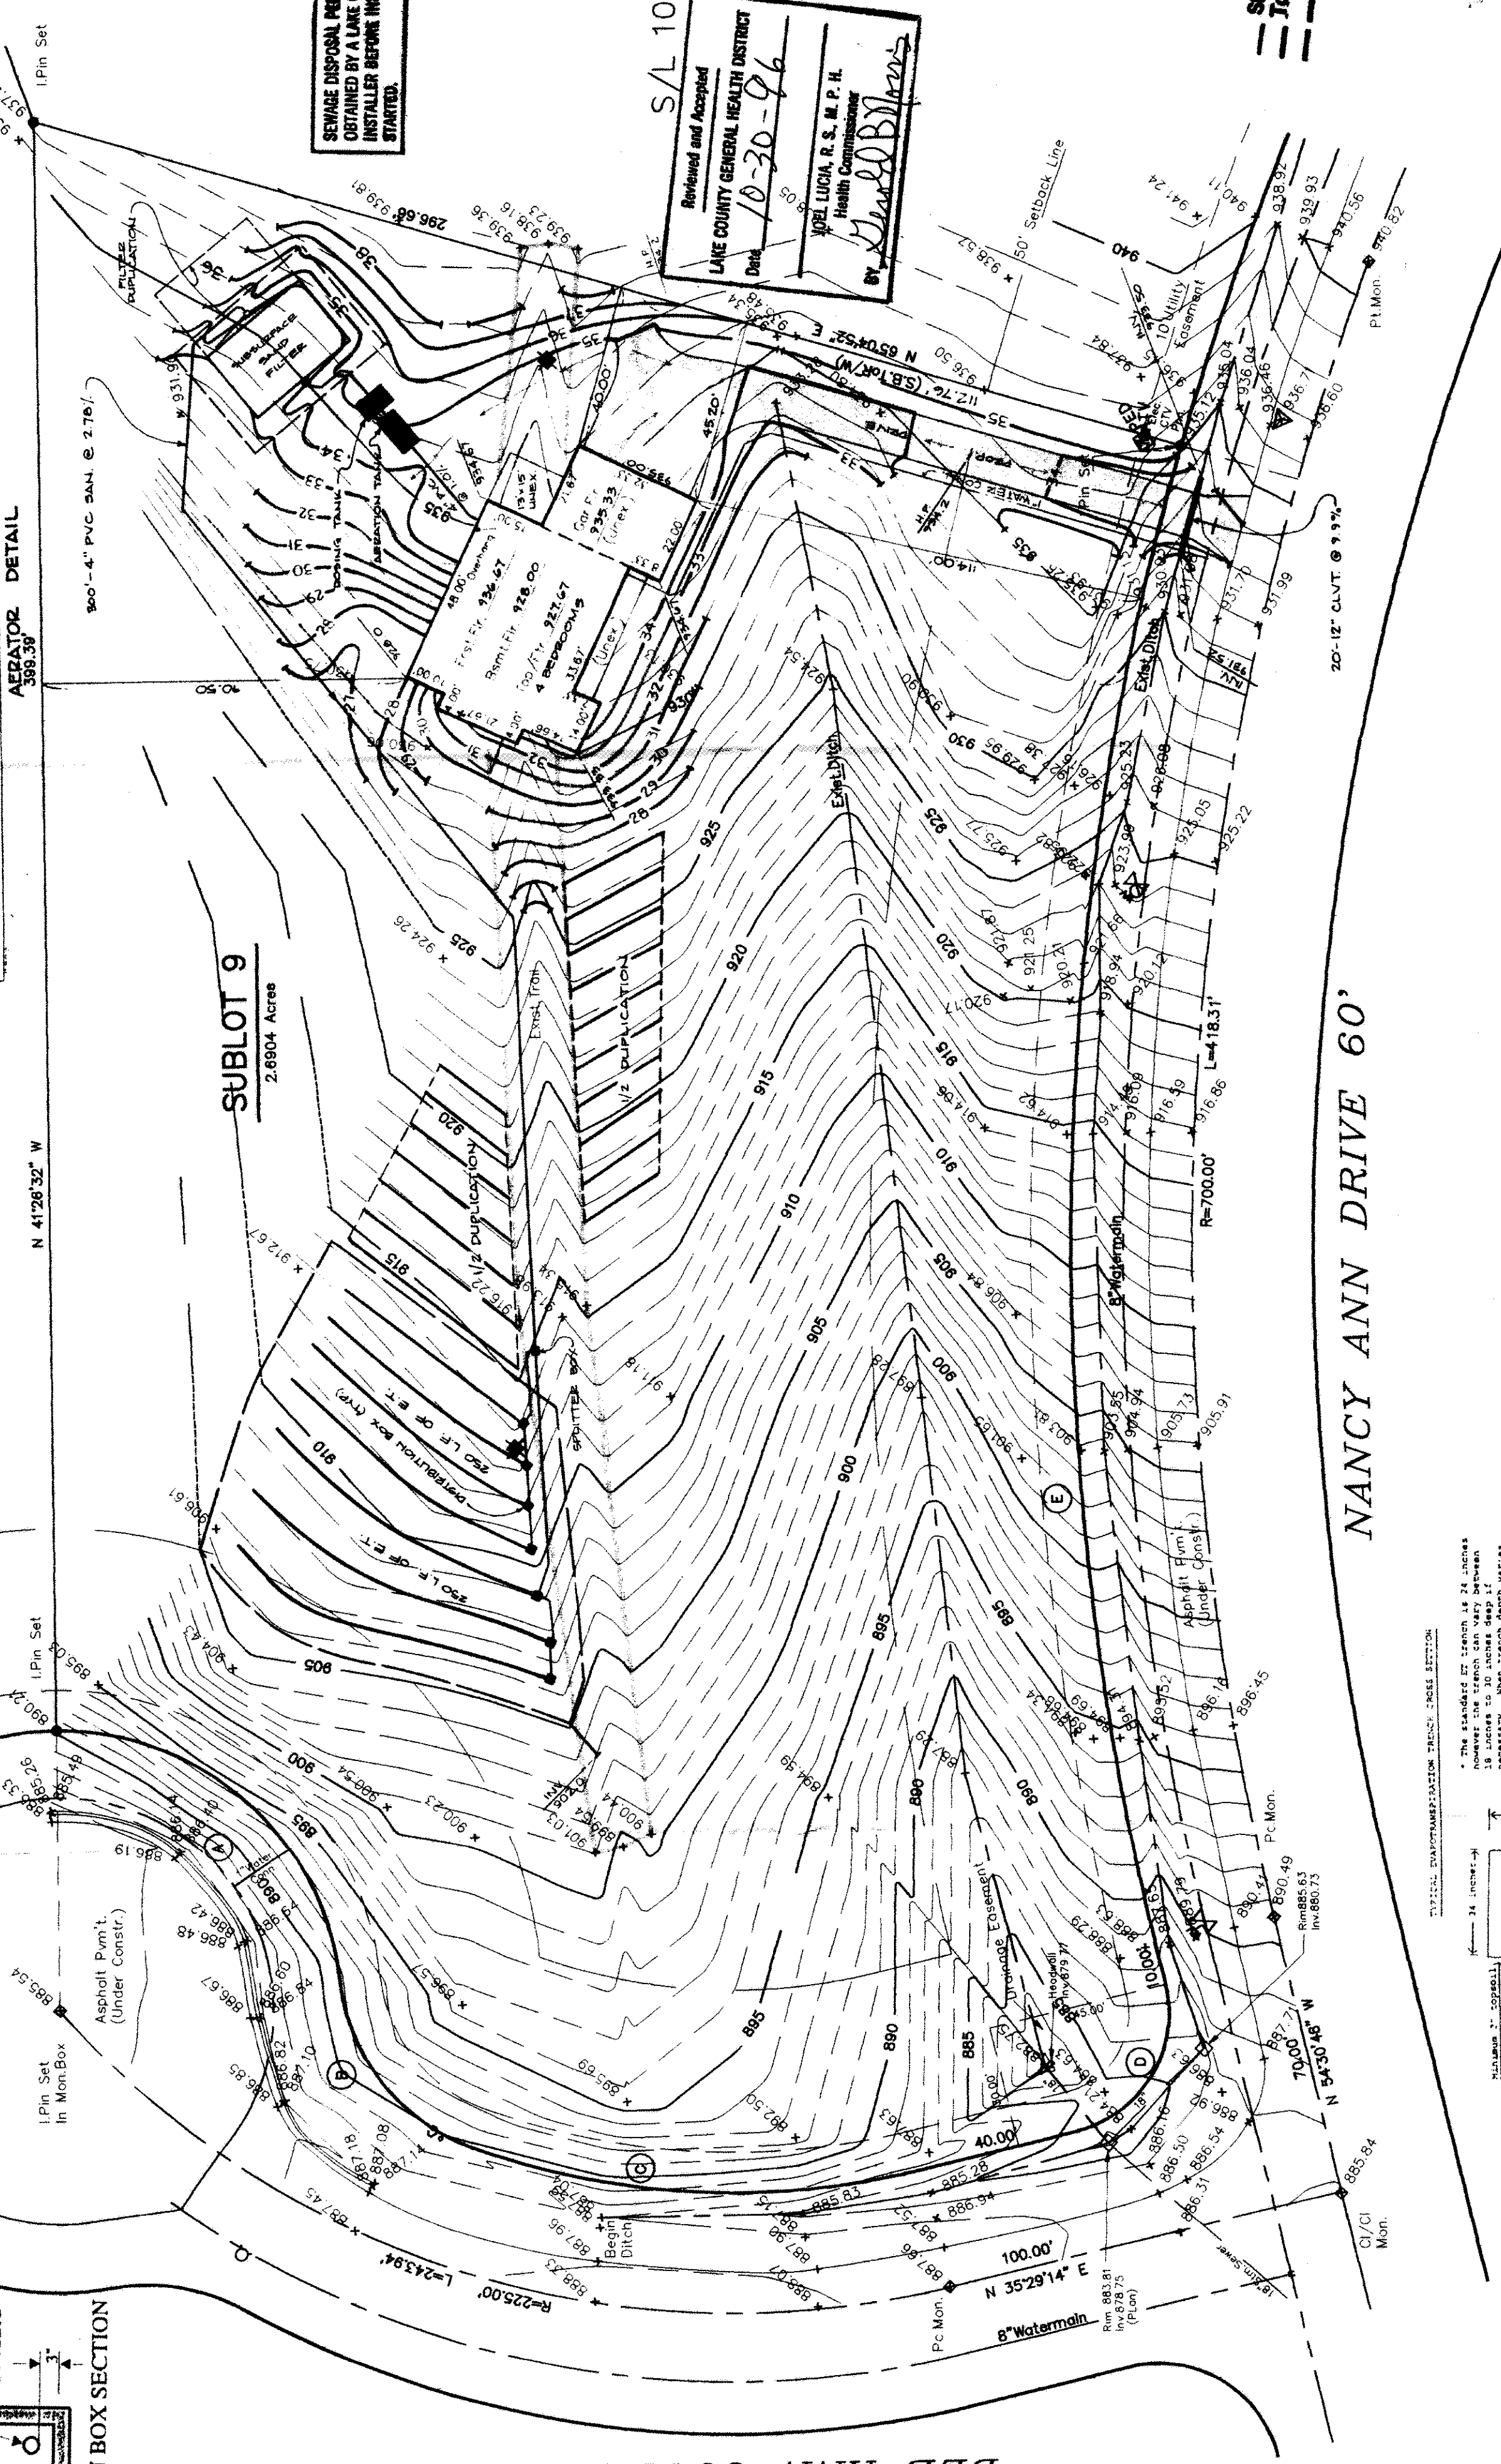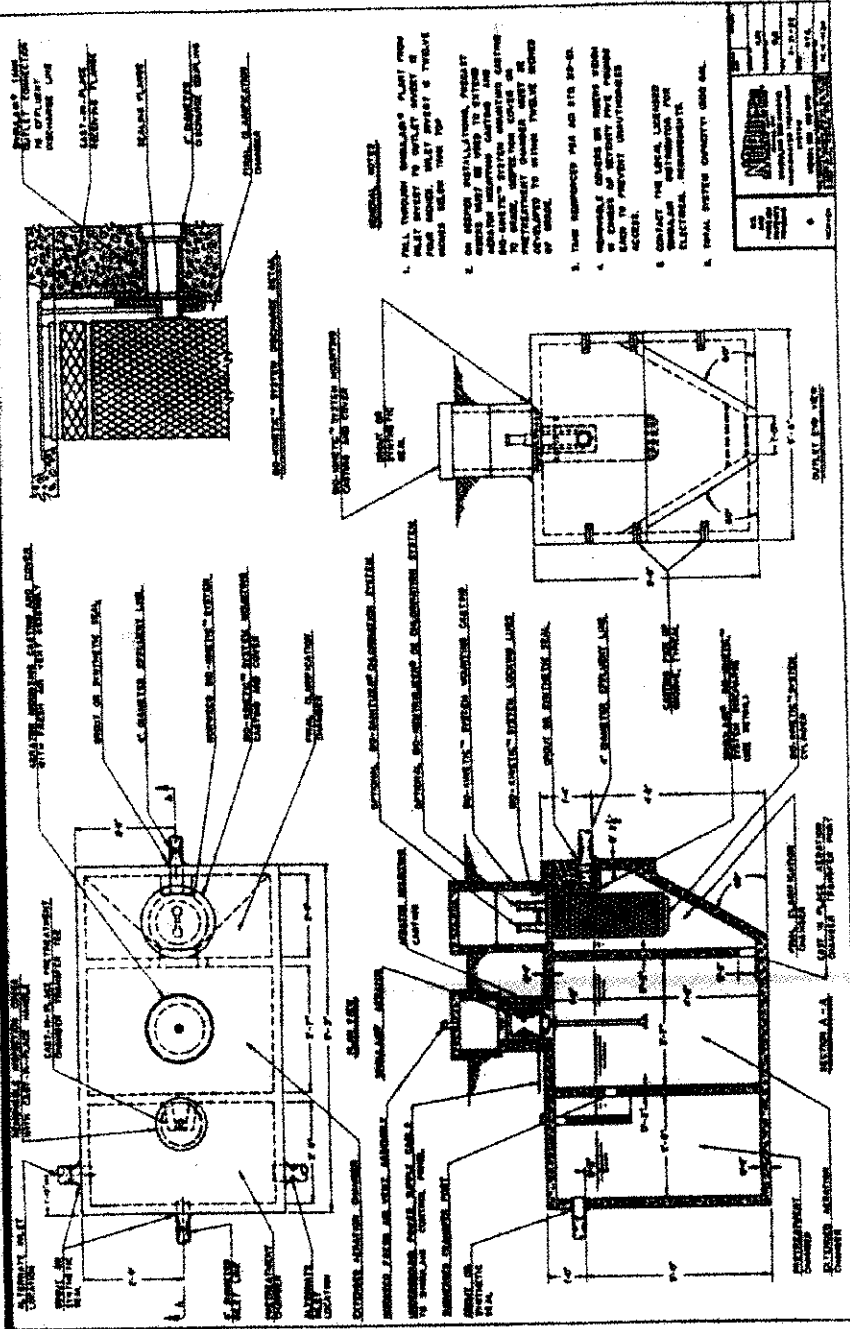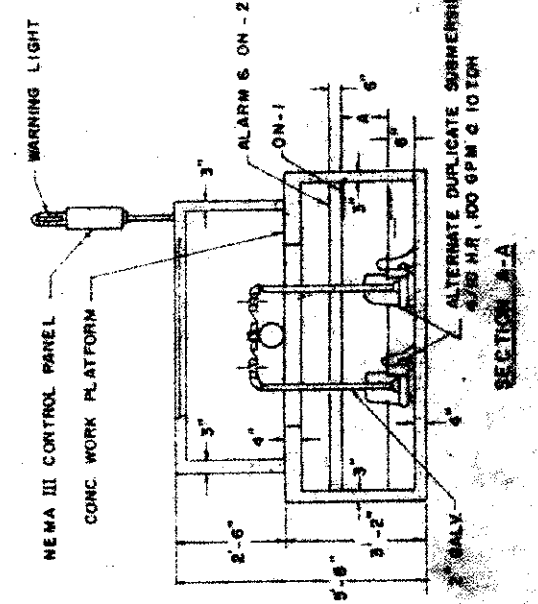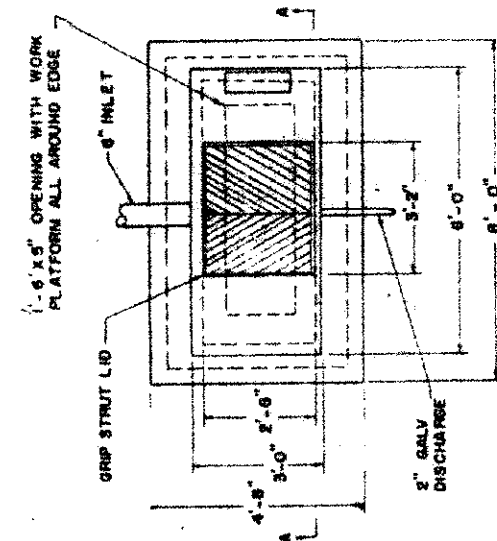

NANCY ANN DRIVE 60'

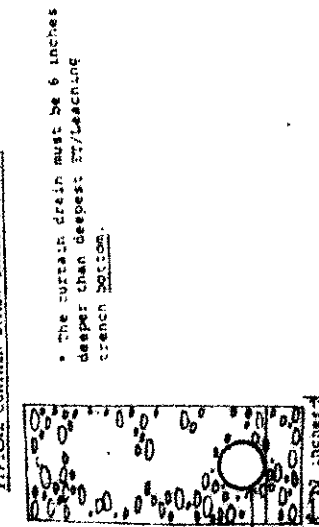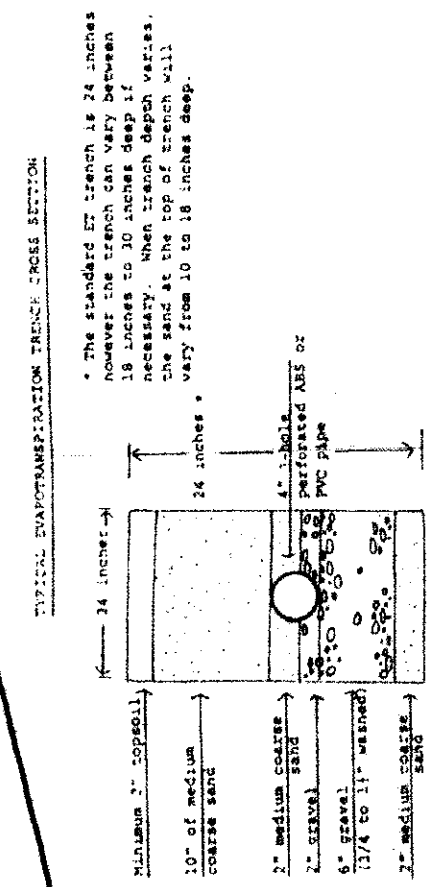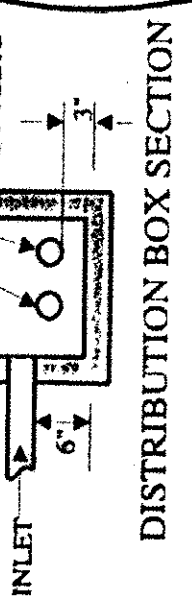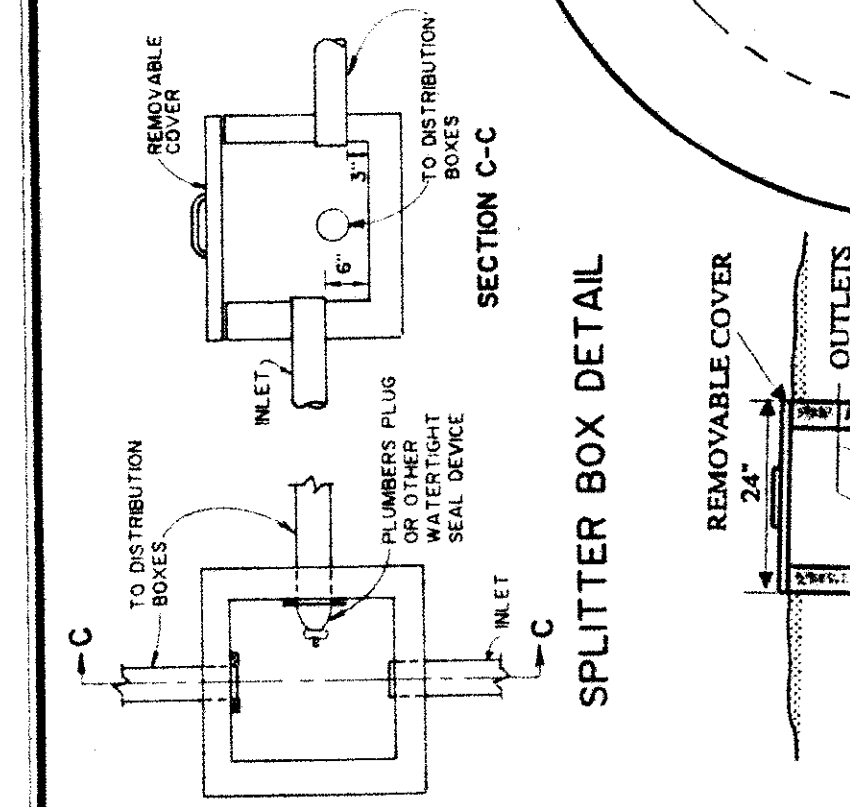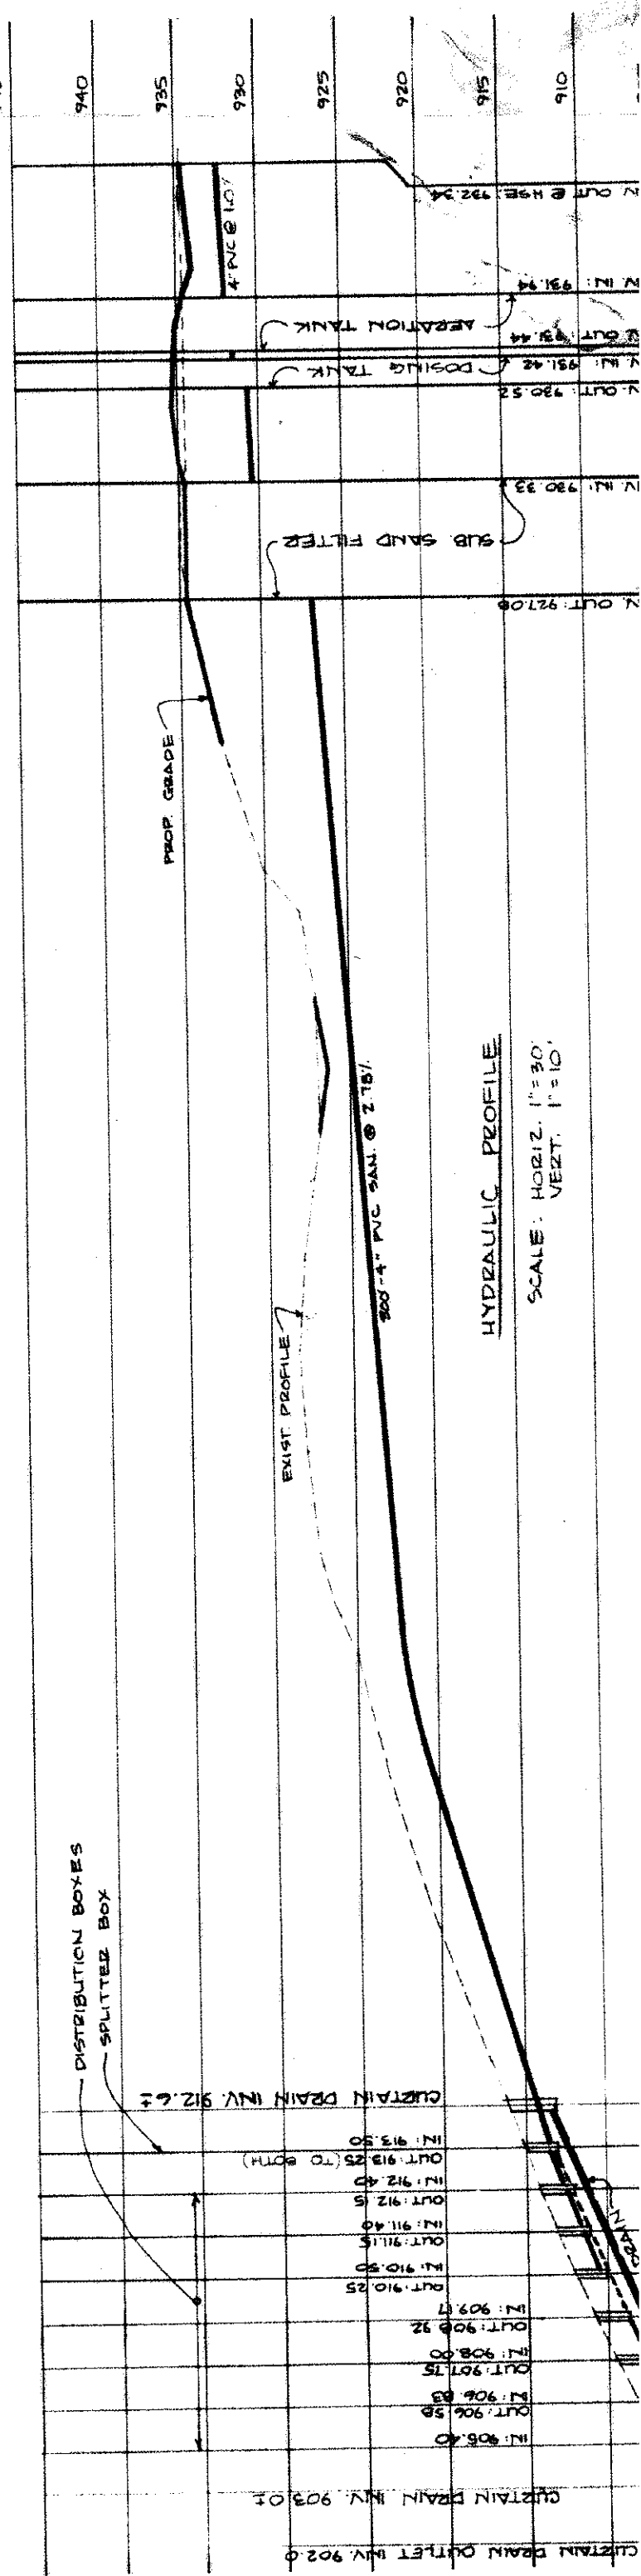

TRENCH DETAILS							
LOT	CURVE	RADIUS	LENGTH	TANGENT	CHORD	BEARING	DELTA
A		70.00'	104.21'	63.56'	94.11'	N 89°12'0" W	84.28'45"
B		50.00'	55.94'	45.07'	79.00'50"	N 84°08'05" W	64.06'05"
C		168.00'	118.64'	58.59'	112.23'	N 52°14'0" E	30.00'00"
D		30.00'	47.12'	35.45'	50.00'00"	N 36°42'57" W	23.35'36"
E		730.00'	37.05'	192.65'	372.67'	N 38°42'57" W	23.35'36"