


TOPOGRAPHIC SURVEY AND SITE PLAN
for
AVID CONSTRUCTION
CONCORD TOWNSHIP - LAKE COUNTY - OHIO
S/L 33 NOBHILL LANE, HERMITAGE BLUFFS SUBD. No. 2
Stormwater Management Plan
Approved as shown and/or noted
JAMES R. GILLS, P.E.
County Drainage Engineer
SCALE: 1"=30'
OCTOBER, 2005


By L.S. Date 10/29/05

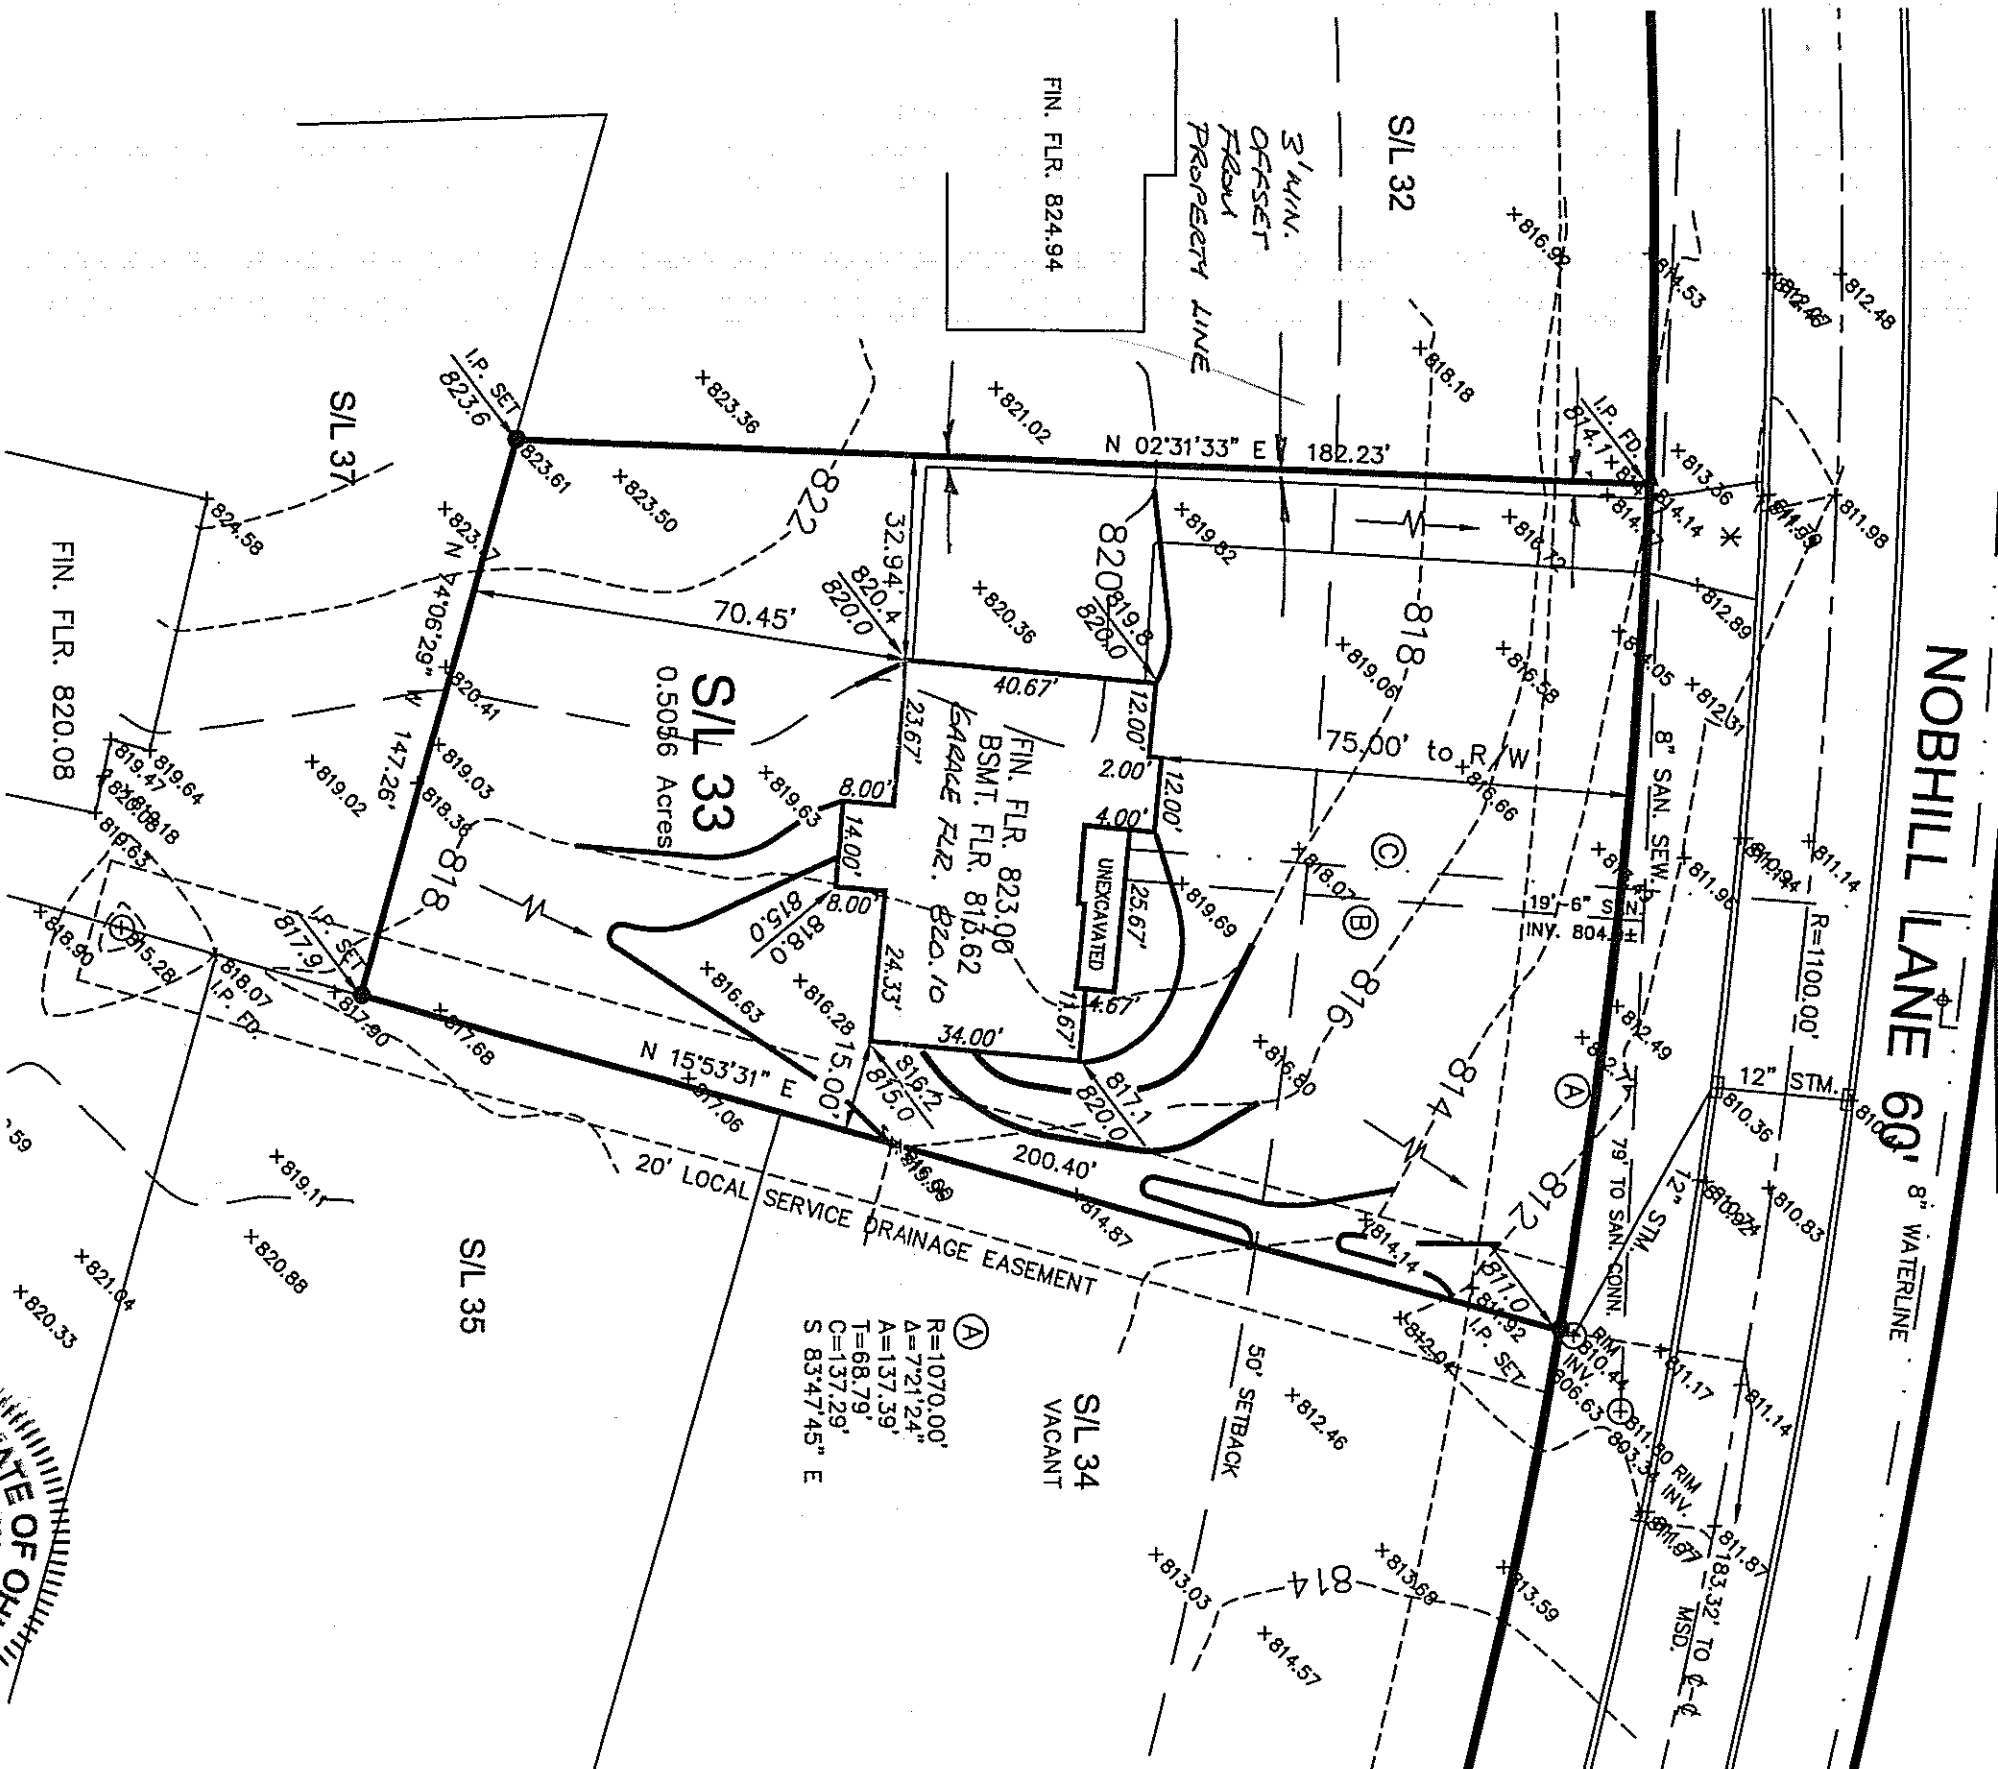


- LEGEND**
- ⑥ 64' - 6" SAN @ 1.00%
 - ⑦ 1" WATER CONN.
 - EXIST EL (PROP ELEV)

BENCHMARK:
RIM OF SAN. M.H. 811.80
* APRON IS 6" THICK CONCRETE
DOWNSPOUTS ARE SPLASHBLOCKED
TO FRONT AND REAR OF HOUSE

FOR EROSION AND SEDIMENT CONTROL PLAN
SEE SHEET 2 of 2

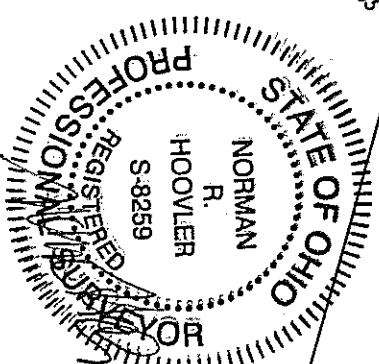

NORMAN R. HOOVER, P.S.
7970 MENTOR AVENUE, UNIT N-1
MENTOR, OHIO 44060
ph. & fax 440.255.1951

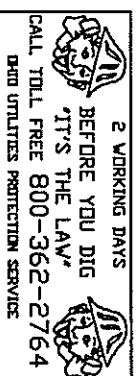

Norman R. Hoover
NORMAN R. HOOVER P.S. #8259 - 10/10/05
SHEET 1 of 2