

SITE PLAN FOR:

PREPARED BY

CERTIFICATION

SHANDLE CONSTRUCTION
8353 MENTOR AVENUE
MENTOR, OHIO

W. M. R. GRAY ASSOC., INC.
ENGINEERS & SURVEYORS
7547 MENTOR AVENUE
MENTOR, OHIO

DATE: MARCH 1, 1974

Scale: 1:20



BEING SUBLT No 8 IN MORLEY HILLS ESTATES
SUBDIVISION No. 1 IN CONCORD TOWNSHIP OHIO

I HEREBY CERTIFY THAT THIS
IS CORRECT TO THE BEST OF MY KNOW

By Mrs. R. Gray

Wm. R. GIBB REG. SURV

Zoning Permit # 2626
 Issued Mar 13, 77
 H.E. on West

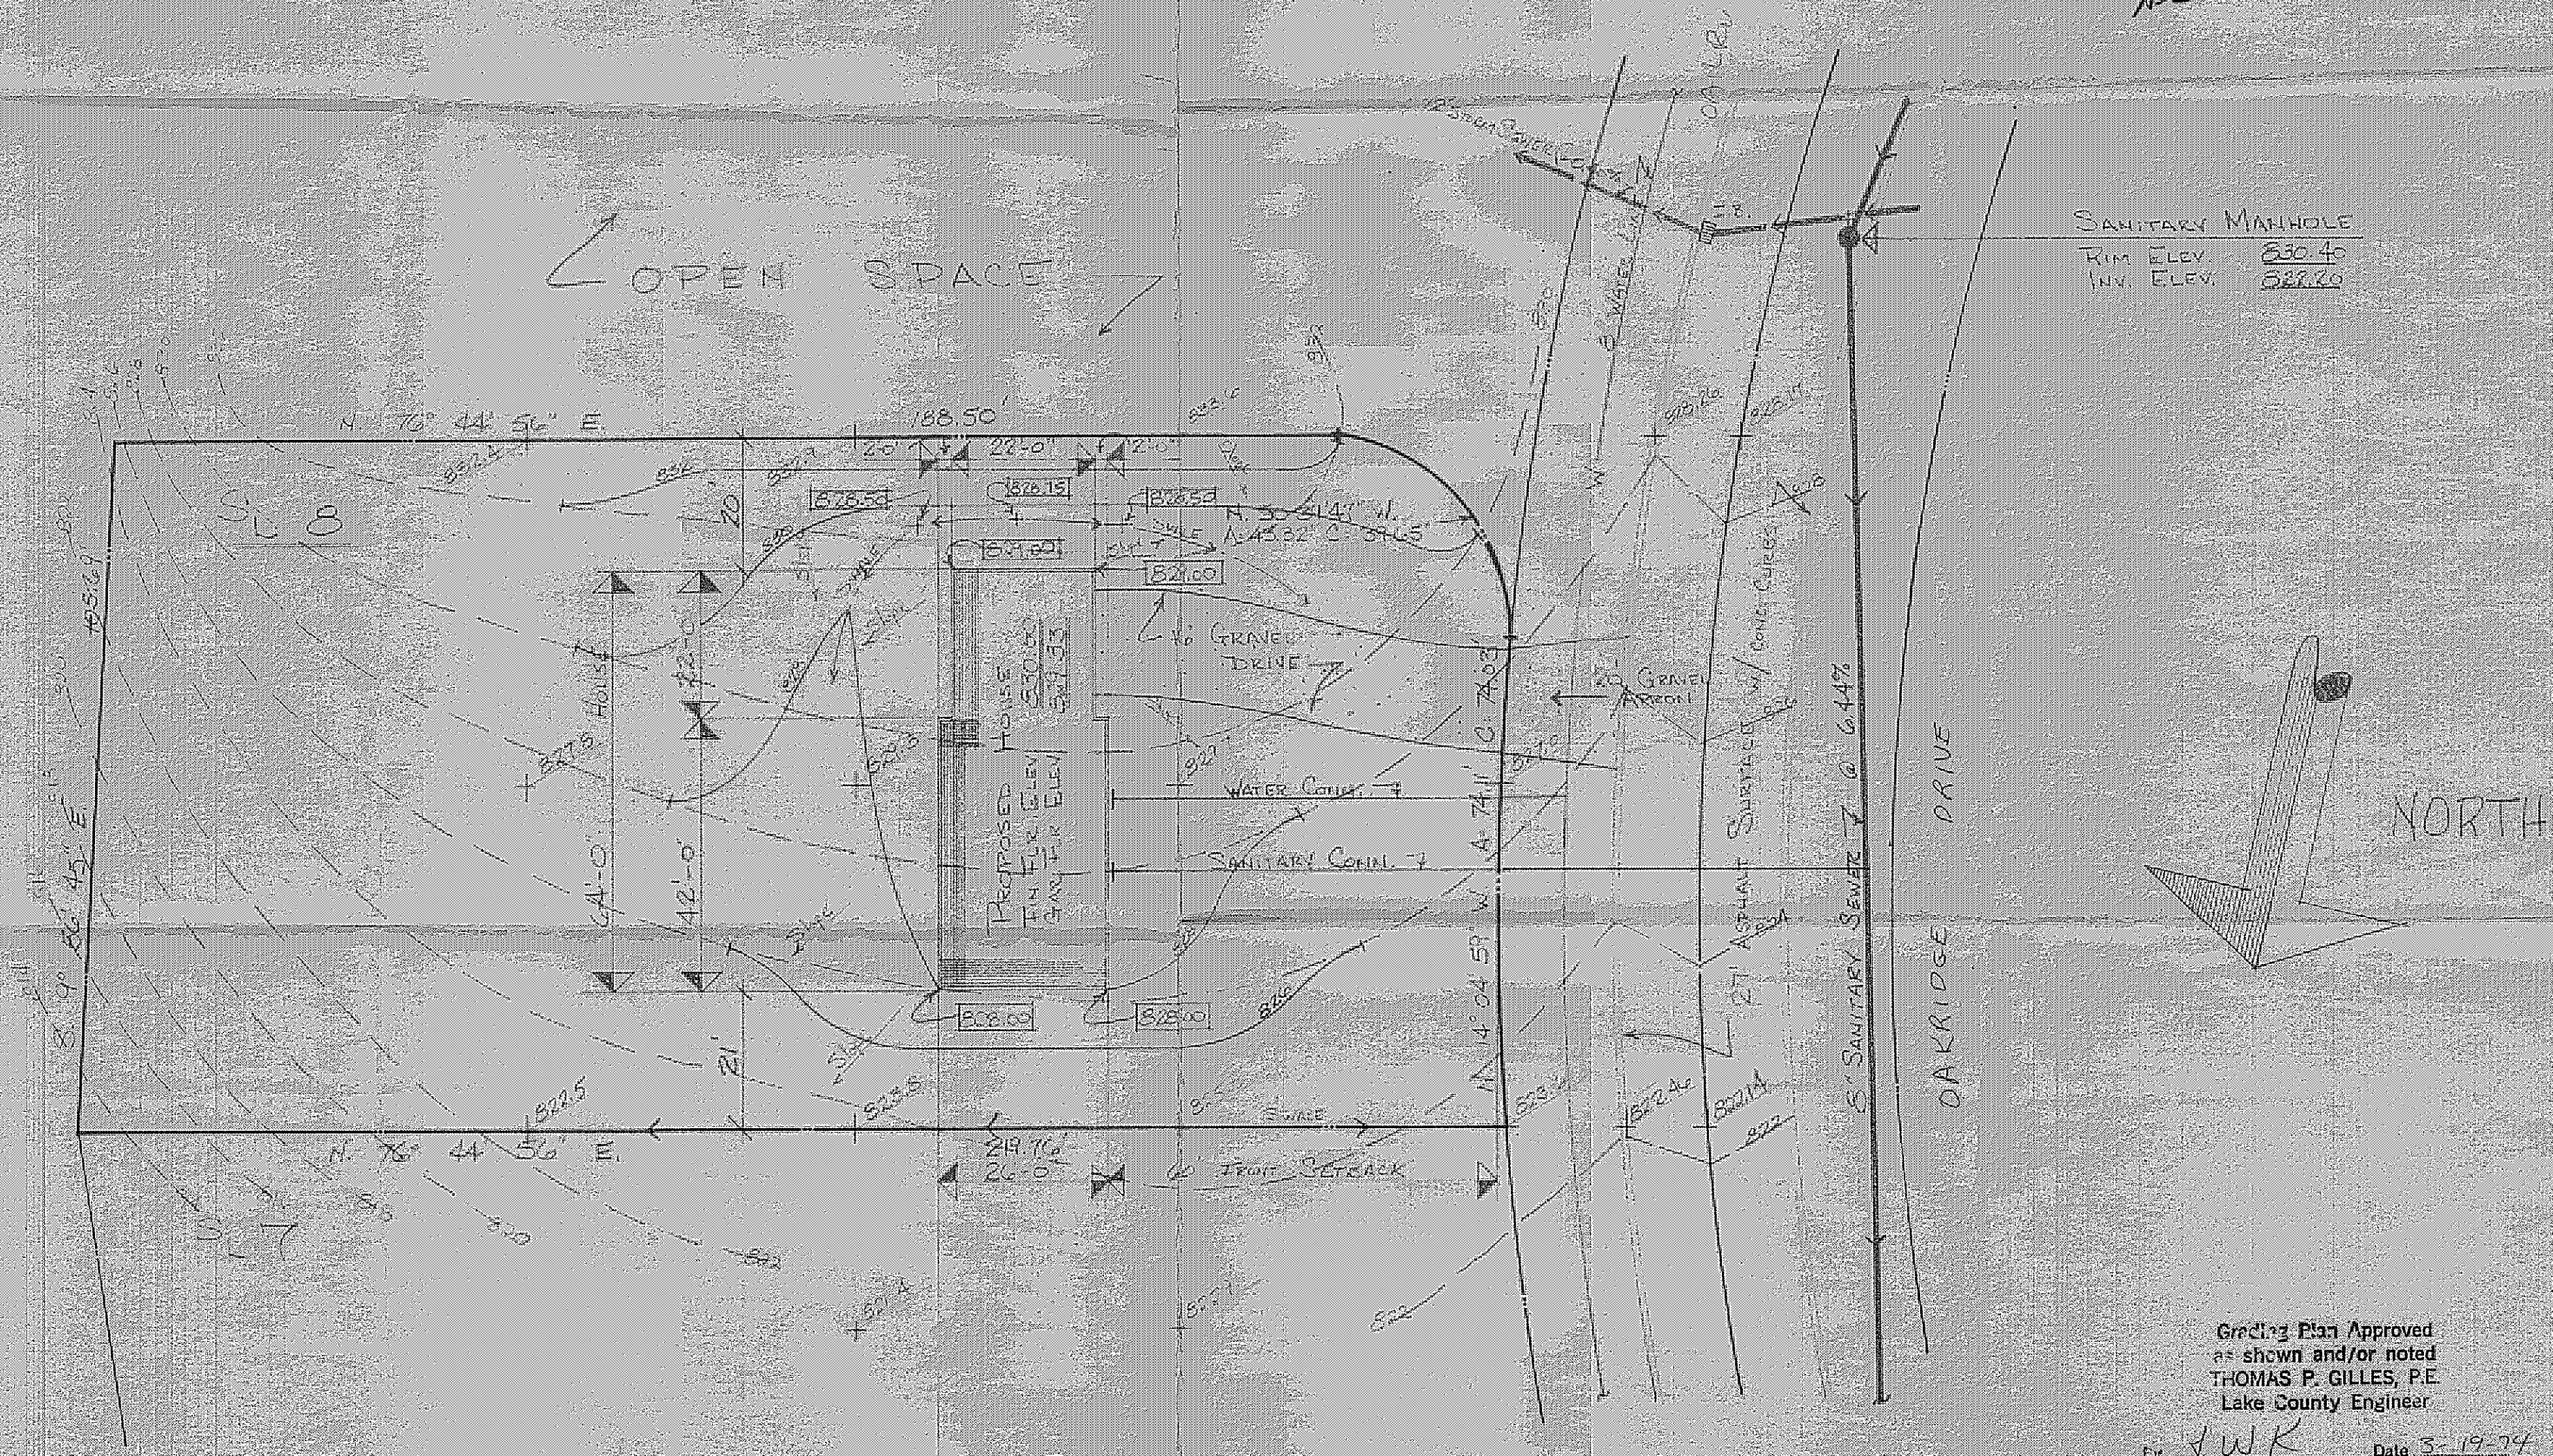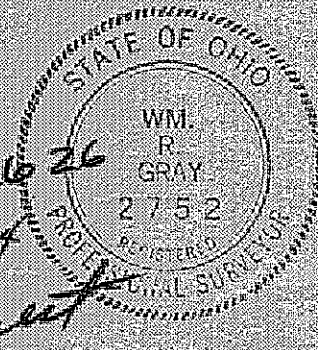

Grading Plan Approved
as shown and/or noted
THOMAS P. GILLES, P.E.
Lake County Engineer

By JWK Date 3-19-74