

SITE PLAN FOR:

SHANDLE CONSTRUCTION
 8353 MENTOR AVENUE
 MENTOR, OHIO

BEING SUBLot NO. 33 IN THE MORLEY HILLS ESTATES SUBDIVISION #2 IN CONCORD TWP.


PREPARED BY:

WM. R. GRAY ASSOC., INC.
 ENGINEERS & SURVEYORS

7547 MENTOR AVENUE
 MENTOR, OHIO
 DATE: JULY 3, 1974 SCALE: 1"=20'

CERTIFICATION:

I HEREBY CERTIFY THAT THIS PLAT IS CORRECT TO THE BEST OF MY KNOWLEDGE.

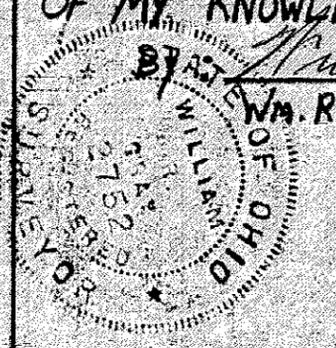

BY: *Wm. R. Gray*
 WM. R. GRAY REG. SURV
 #2752

Grading Plan Approved as shown and/or noted
 THOMAS P. GILLES, P.E.
 Lake County Engineer

CURVE DATA

R=434.56' A=85.80'
 C=85.61' N. 11° 53' 22" E

NOTE: ELEVATIONS SHOWN ARE DESIGNATED AS FOLLOWS,

- * 850.00 — INDICATES EXISTING ELEVATIONS
- * 850.50 — INDICATES PROPOSED ELEVATIONS
- * 851.00 * — INDICATES AS-BUILT ELEVATIONS

NOTE: UTILITIES SHOWN ARE SUBJECT TO AS-BUILT CONDITIONS.

