

# SITE PLAN FOR: SHANDLE CONSTRUCTION 8453 MENTOR AVENUE MENTOR, OHIO 44060

BEING SUBLOT NO. 82 IN MORLEY HILLS  
ESTATES SUBDIVISION NO. 2 IN CONCORD TWP. OHIO

PREPARED BY:

Wm. R. Gray Associates, Inc.

1547 Mentor Avenue

Mentor, Ohio 44060

Date: May 22, 1974 Scale: 1" = 20'

Civil Engineers

Surveyors


## CERTIFICATION:

I hereby certify that this plan  
is correct to the best of my  
knowledge.

Wm. R. Gray

Wm. R. Gray, P.E., C.E.

1547 MENTOR AVENUE

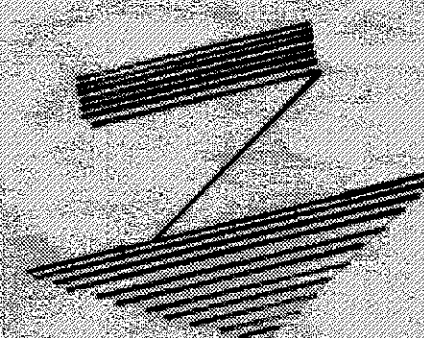

Survey Point # 2668  
dated 5-22-74  
H.E. new sheet

NOTE: ALL UTILITIES AND  
PAVEMENT SHOWN ARE  
SUBJECT TO AS-BUILT  
CONDITIONS.

Grading Plan Approved  
as shown and/or noted  
THOMAS P. GILLES, P.E.  
Lake County Engineer

JW K Date 5-28-74

