

SHANDLE CONST.
8353 MENTOR AVENUE
MENTOR, OHIO.

44860

PREPARED By :

WM. R. GRAY ASSOC. INC.
7547 MENTOR AVE.



MENTOR, OHIO

DATE: MAY 18, 1976, SCALE: 1" = 20'

I HEREBY CERTIFY THAT THIS PLAT IS CORRECT
TO THE BEST OF MY KNOWLEDGE.

By: Wm. A. Gray

Wm. R. Gray / Reg. Sur. # 2752

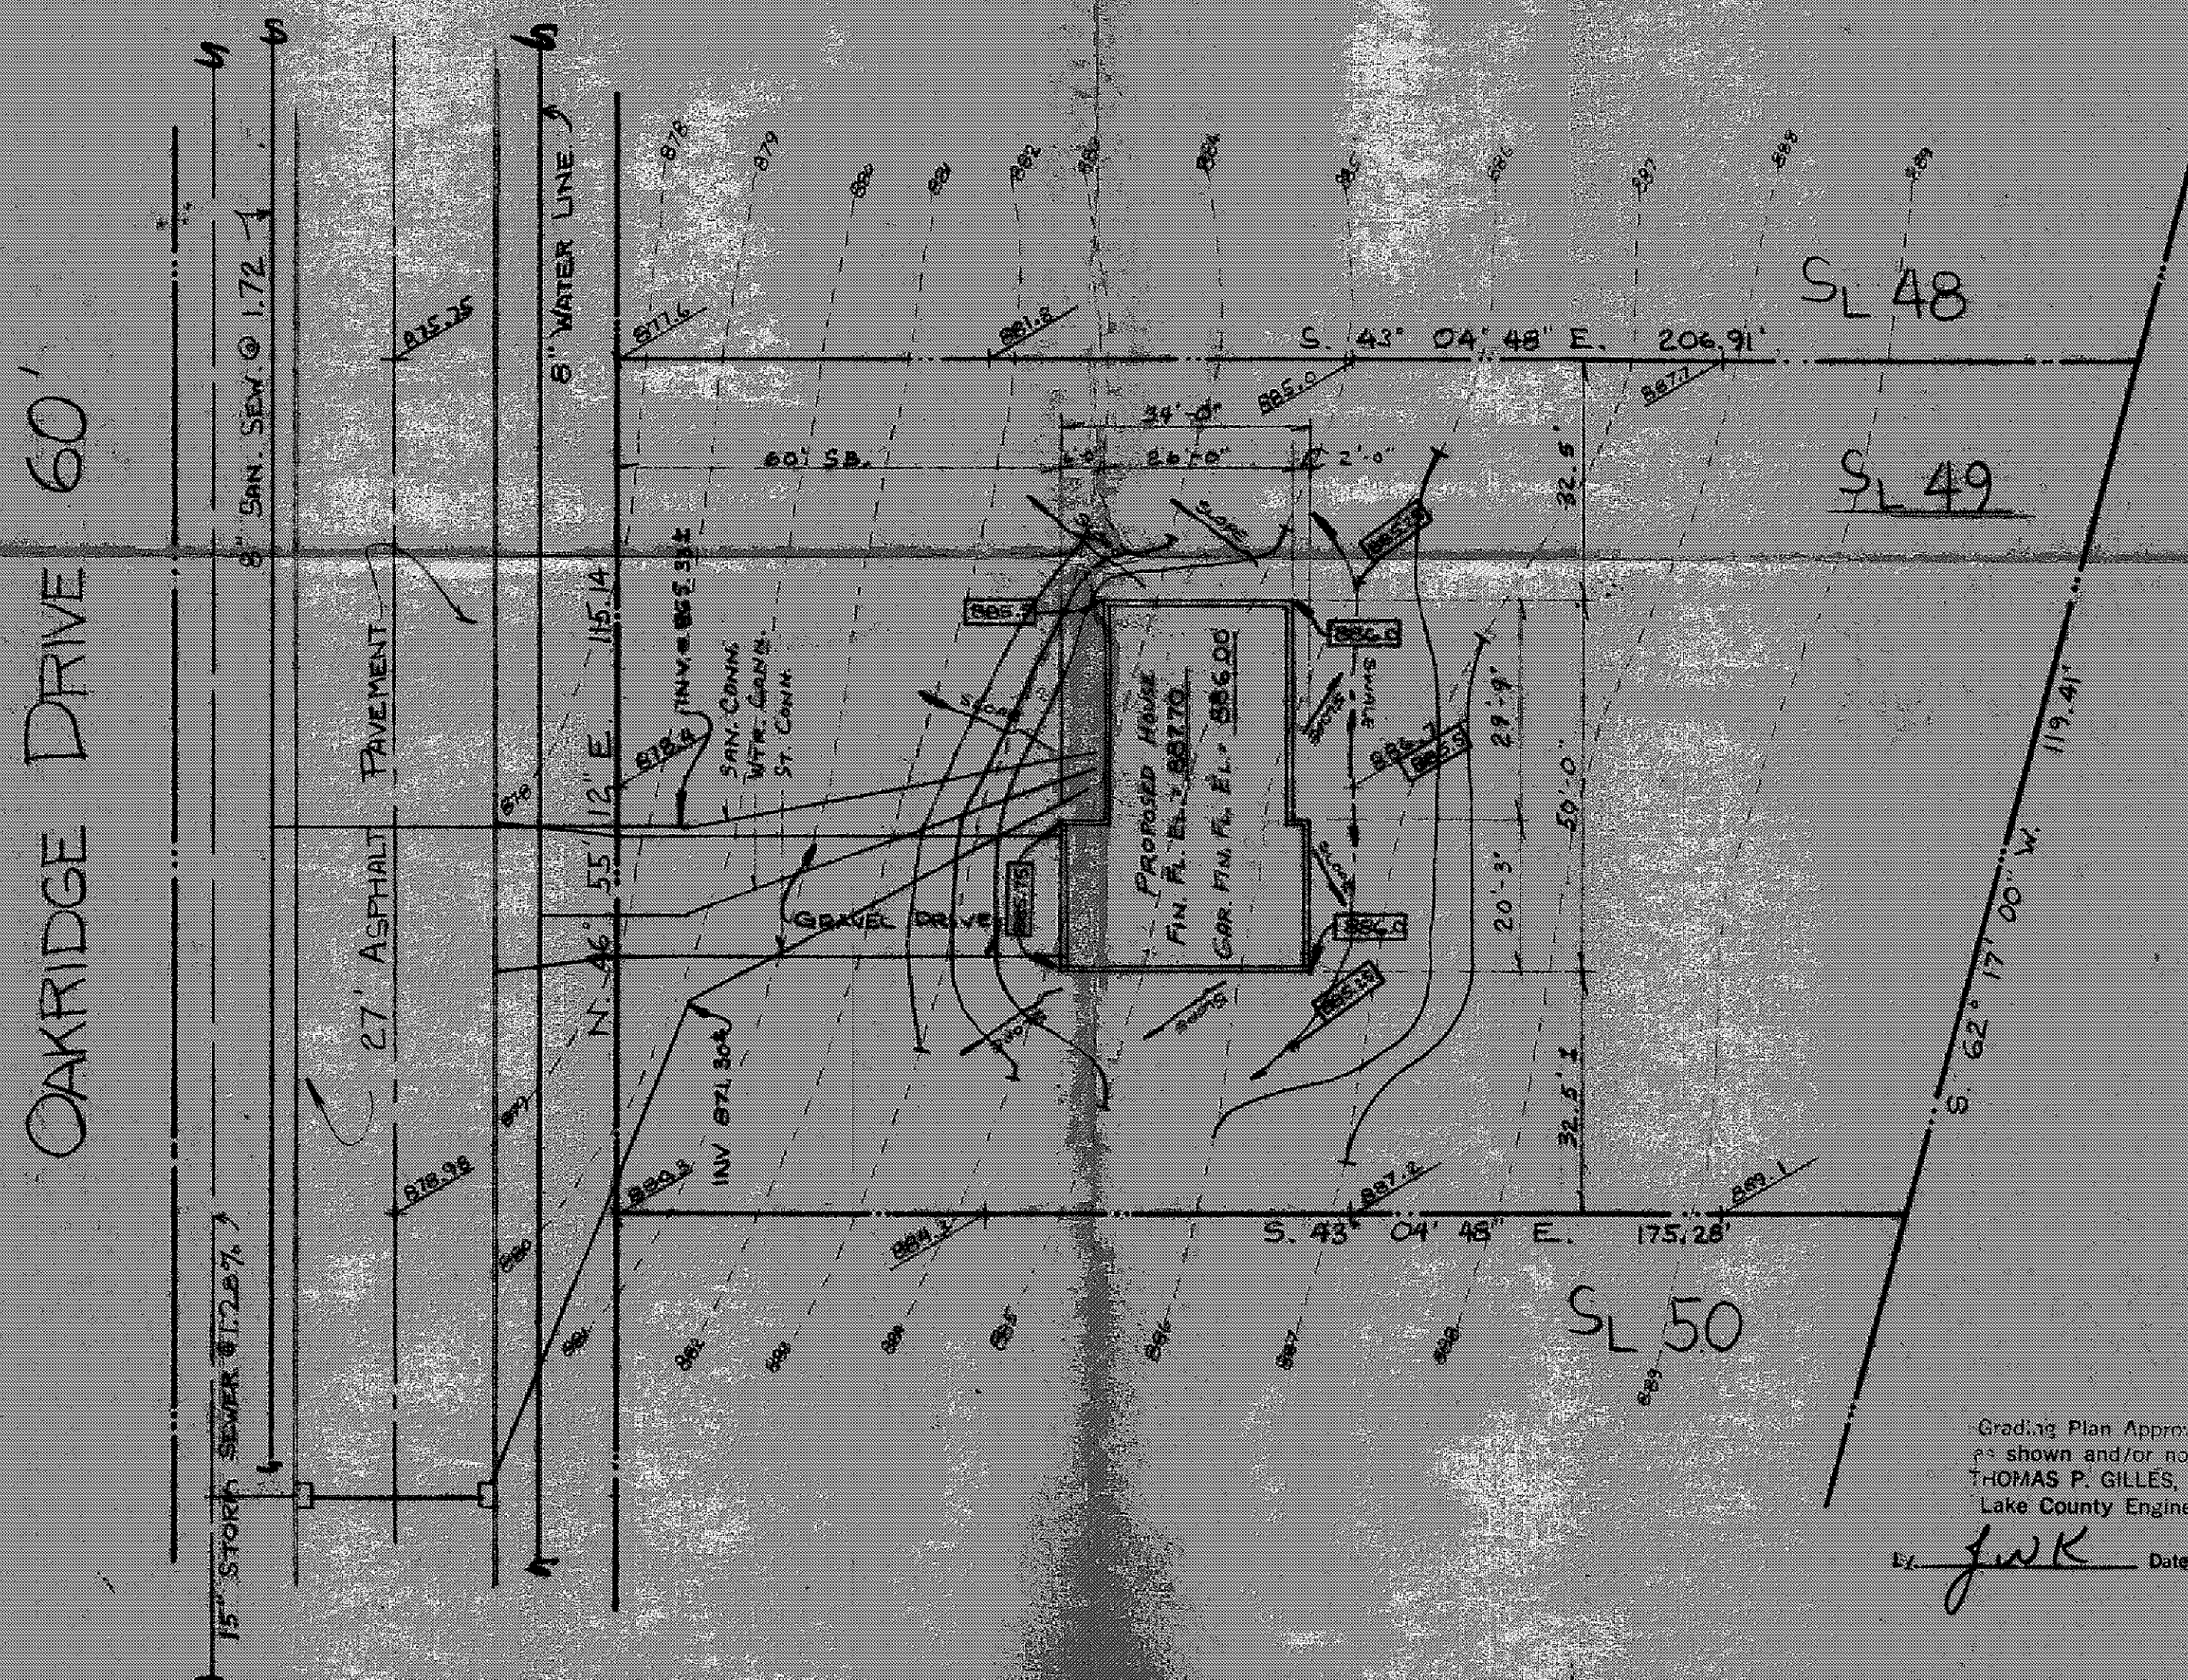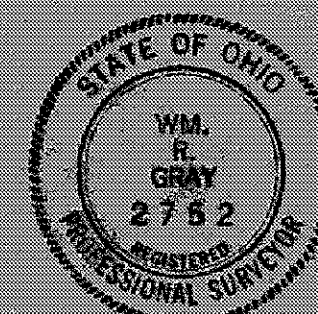

**ZONING
PERMIT**

Approved 5-19-76
3040 HEman 16

Grading Plan Approved
as shown and/or noted
THOMAS P. GILLIS, P.E.
Lake County Engineer

Ex. JWK Date 5-20-76