

SITE PLAN FOR:

SHANDLE CONSTR.
8353 MENTOR AVE.
MENTOR, OHIO

BEING SUBLOT NO. 75 IN THE MORLEY
HILLS ESTATES SUBDIVISION NO. 2 LOCATED
IN CONCORD TWP., OHIO.

PREPARED BY:



WM. R. GRAY ASSOC. INC.
7547 MENTOR AVE.
MENTOR, OHIO

DATE: MAR. 5, 1975 SCALE: 1" = 20'

CERTIFICATION:

I HEREBY CERTIFY THAT THIS PLAN IS
CORRECT TO THE BEST OF MY KNOWLEDGE.

By: Wm. R. Gray
WM. R. GRAY REG. SURV. #2

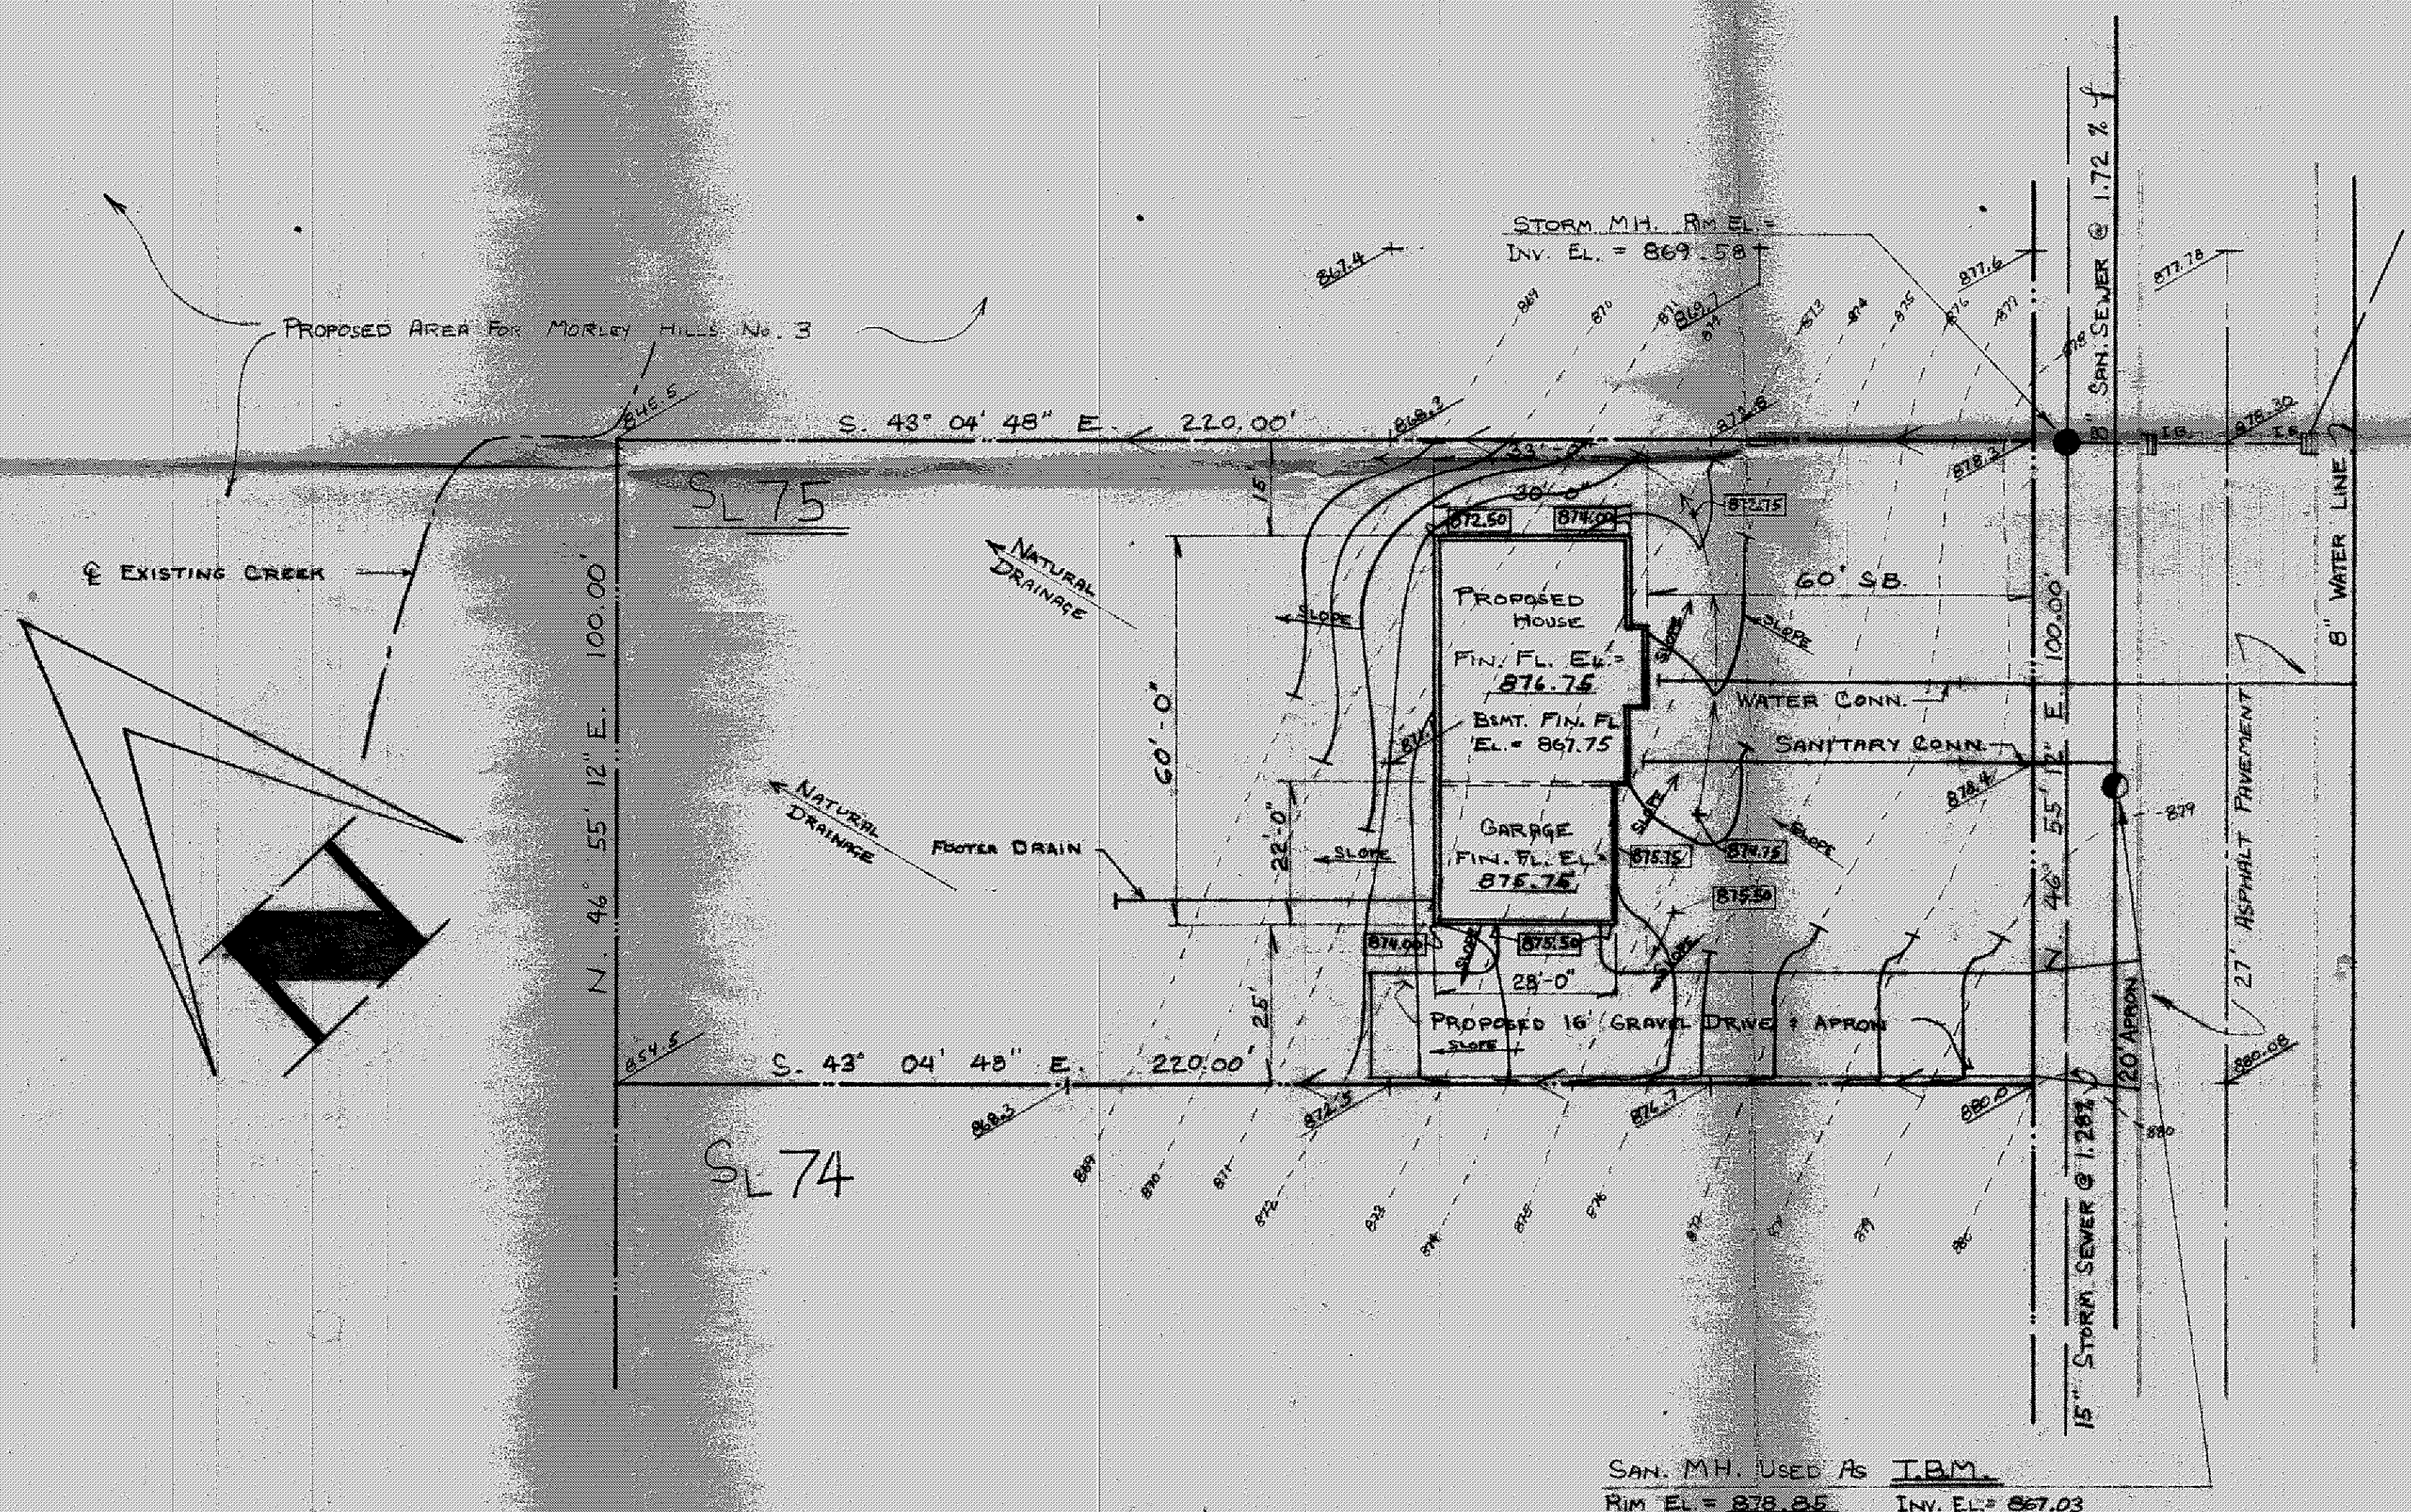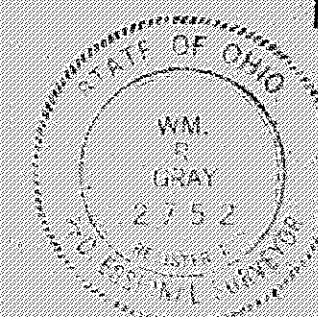

OAKRIDGE DRIVE 60'

Joining permit #27
issued 3/12/75
R. J. G. P.

Grading Plan Approved
as shown and/or note
THOMAS E. GILLES, P.E.
Lake County Engineer

By: JWK Date: 3/12/75

SAN. MH. USED AS I.B.M.
RIM EL. = 878.25 INV. EL. = 867.03