


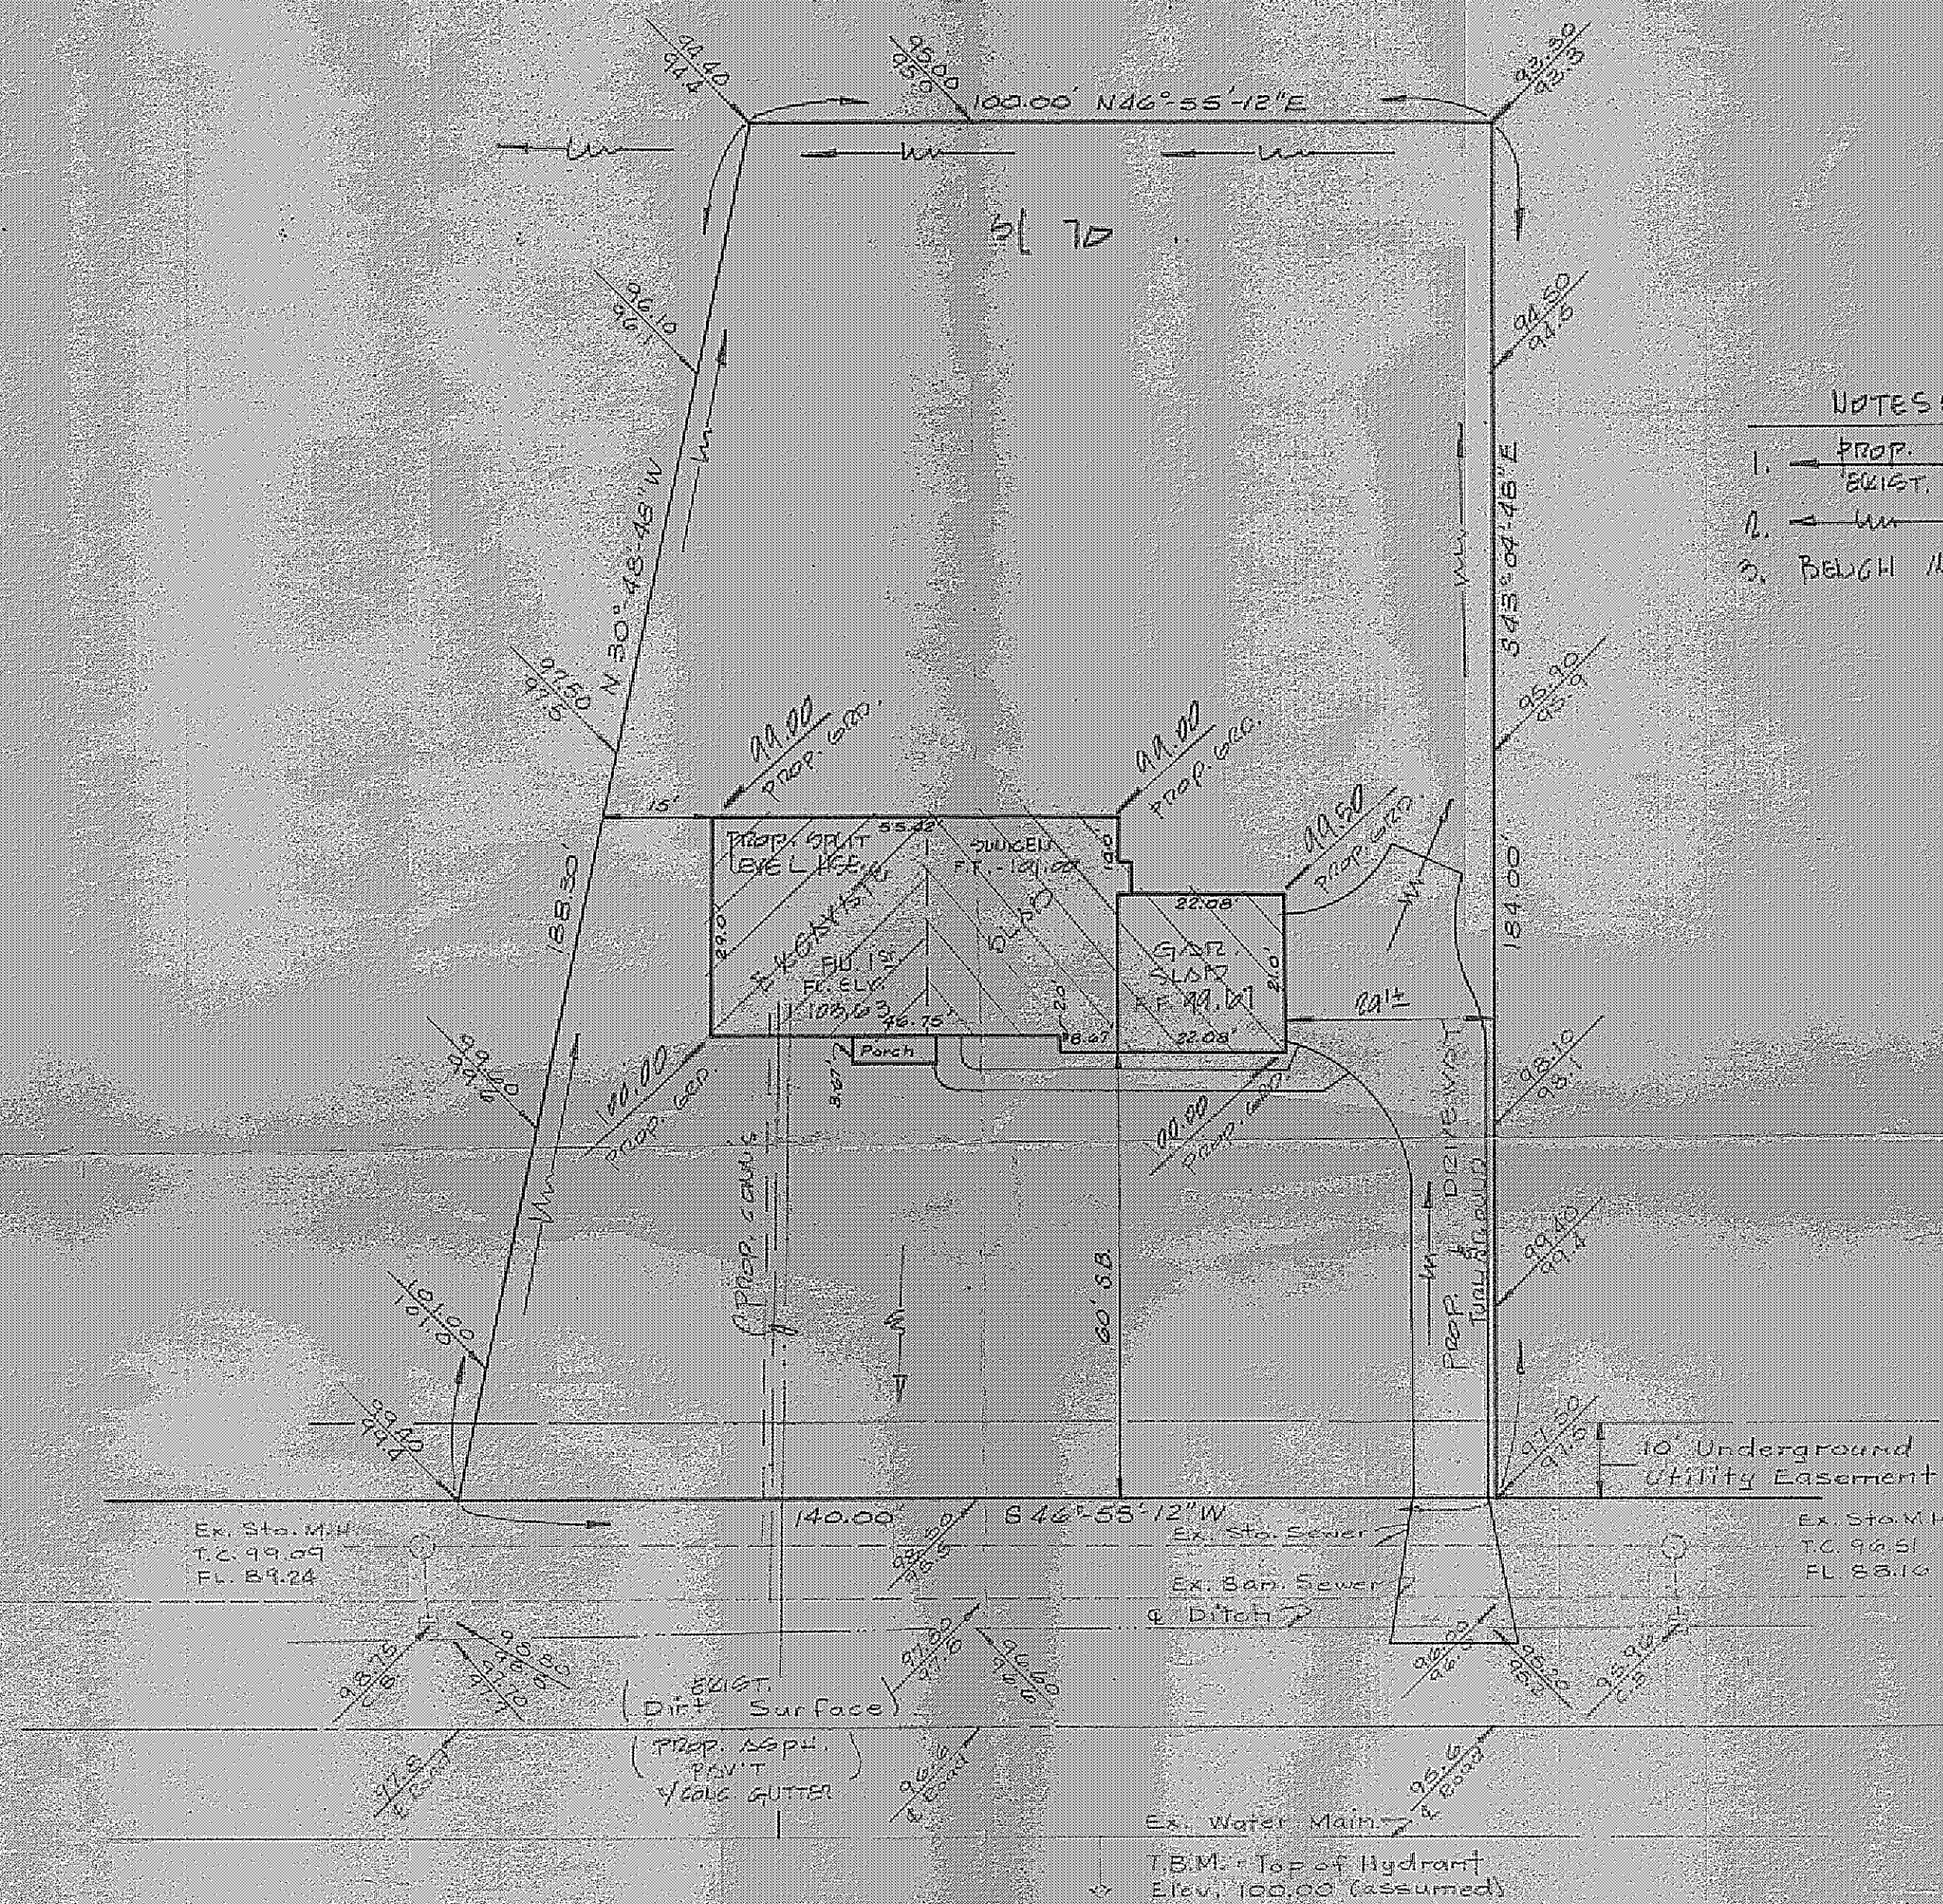

- NOTES:
1. $\rightarrow$ PROP. EXIST. GROUND GRADES.
 2. $\rightarrow$ OVERLAND DRAINAGE FLOW.
 3. BEUGH 11/21/61: TOP OF HYD. OPP. S/L 70 ELEV. 100.00 ASSUMED


Ord. 13 Plan Approved as shown and/or noted
 THOMAS P. GILLES, P.E.
 Lake County Engineer
 Date 6-30-75

*Joining Parcel # 2851
 signed 6-25-75
 J.E. Smith*

Oakridge Dr. 60'

PRINTED
 JUN 24 1975
 F. A. THOMAS & ASSOC. INC

SCALE: 1" = 20' VERT.
 1 of 1 SHEETS

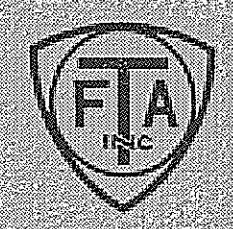

Plot Plan
 of S/L 70 in the Marley Hills Estd. Subdivision No 2
 for Sam Friedman
 Concord Twp., Ohio

FRANK A. THOMAS & ASSOCIATES, INC.
 CONSULTING ENGINEERS
 WILLOUGHBY, OHIO

DRAWN BY: Smith
 CHECKED BY:
 DATE: 6-20-75