

SITE PLAN FOR:

SHANDLE CONST.
8353 MENTOR OHIO
MENTOR, OHIO. 44060

BEING SUBLT No. 58 IN THE
MORLEY HILLS ESTATES SUBDIVISION No. 2 IN
CONCORD TWP., OHIO.

PREPARED BY:

WM. R. GRAY ASSOC. INC.
7547 MENTOR AVE.
MENTOR, OHIO

DATE: NOV 19, 1976 SCALE: 1" = 20'

Grading Plan Approved
as shown and/or noted
THOMAS P. GILLES, P.E.
Lake County Engineer
By JWK Date 12-3-76


CERTIFICATION:

I HEREBY CERTIFY THAT THIS PLAN IS
CORRECT TO THE BEST OF MY KNOWLEDGE.

BY: Wm R Gray
WM. R. GRAY REG. SURV. # 2752

ZONING
PERMIT

Approved Wm R Gray
12-1-76

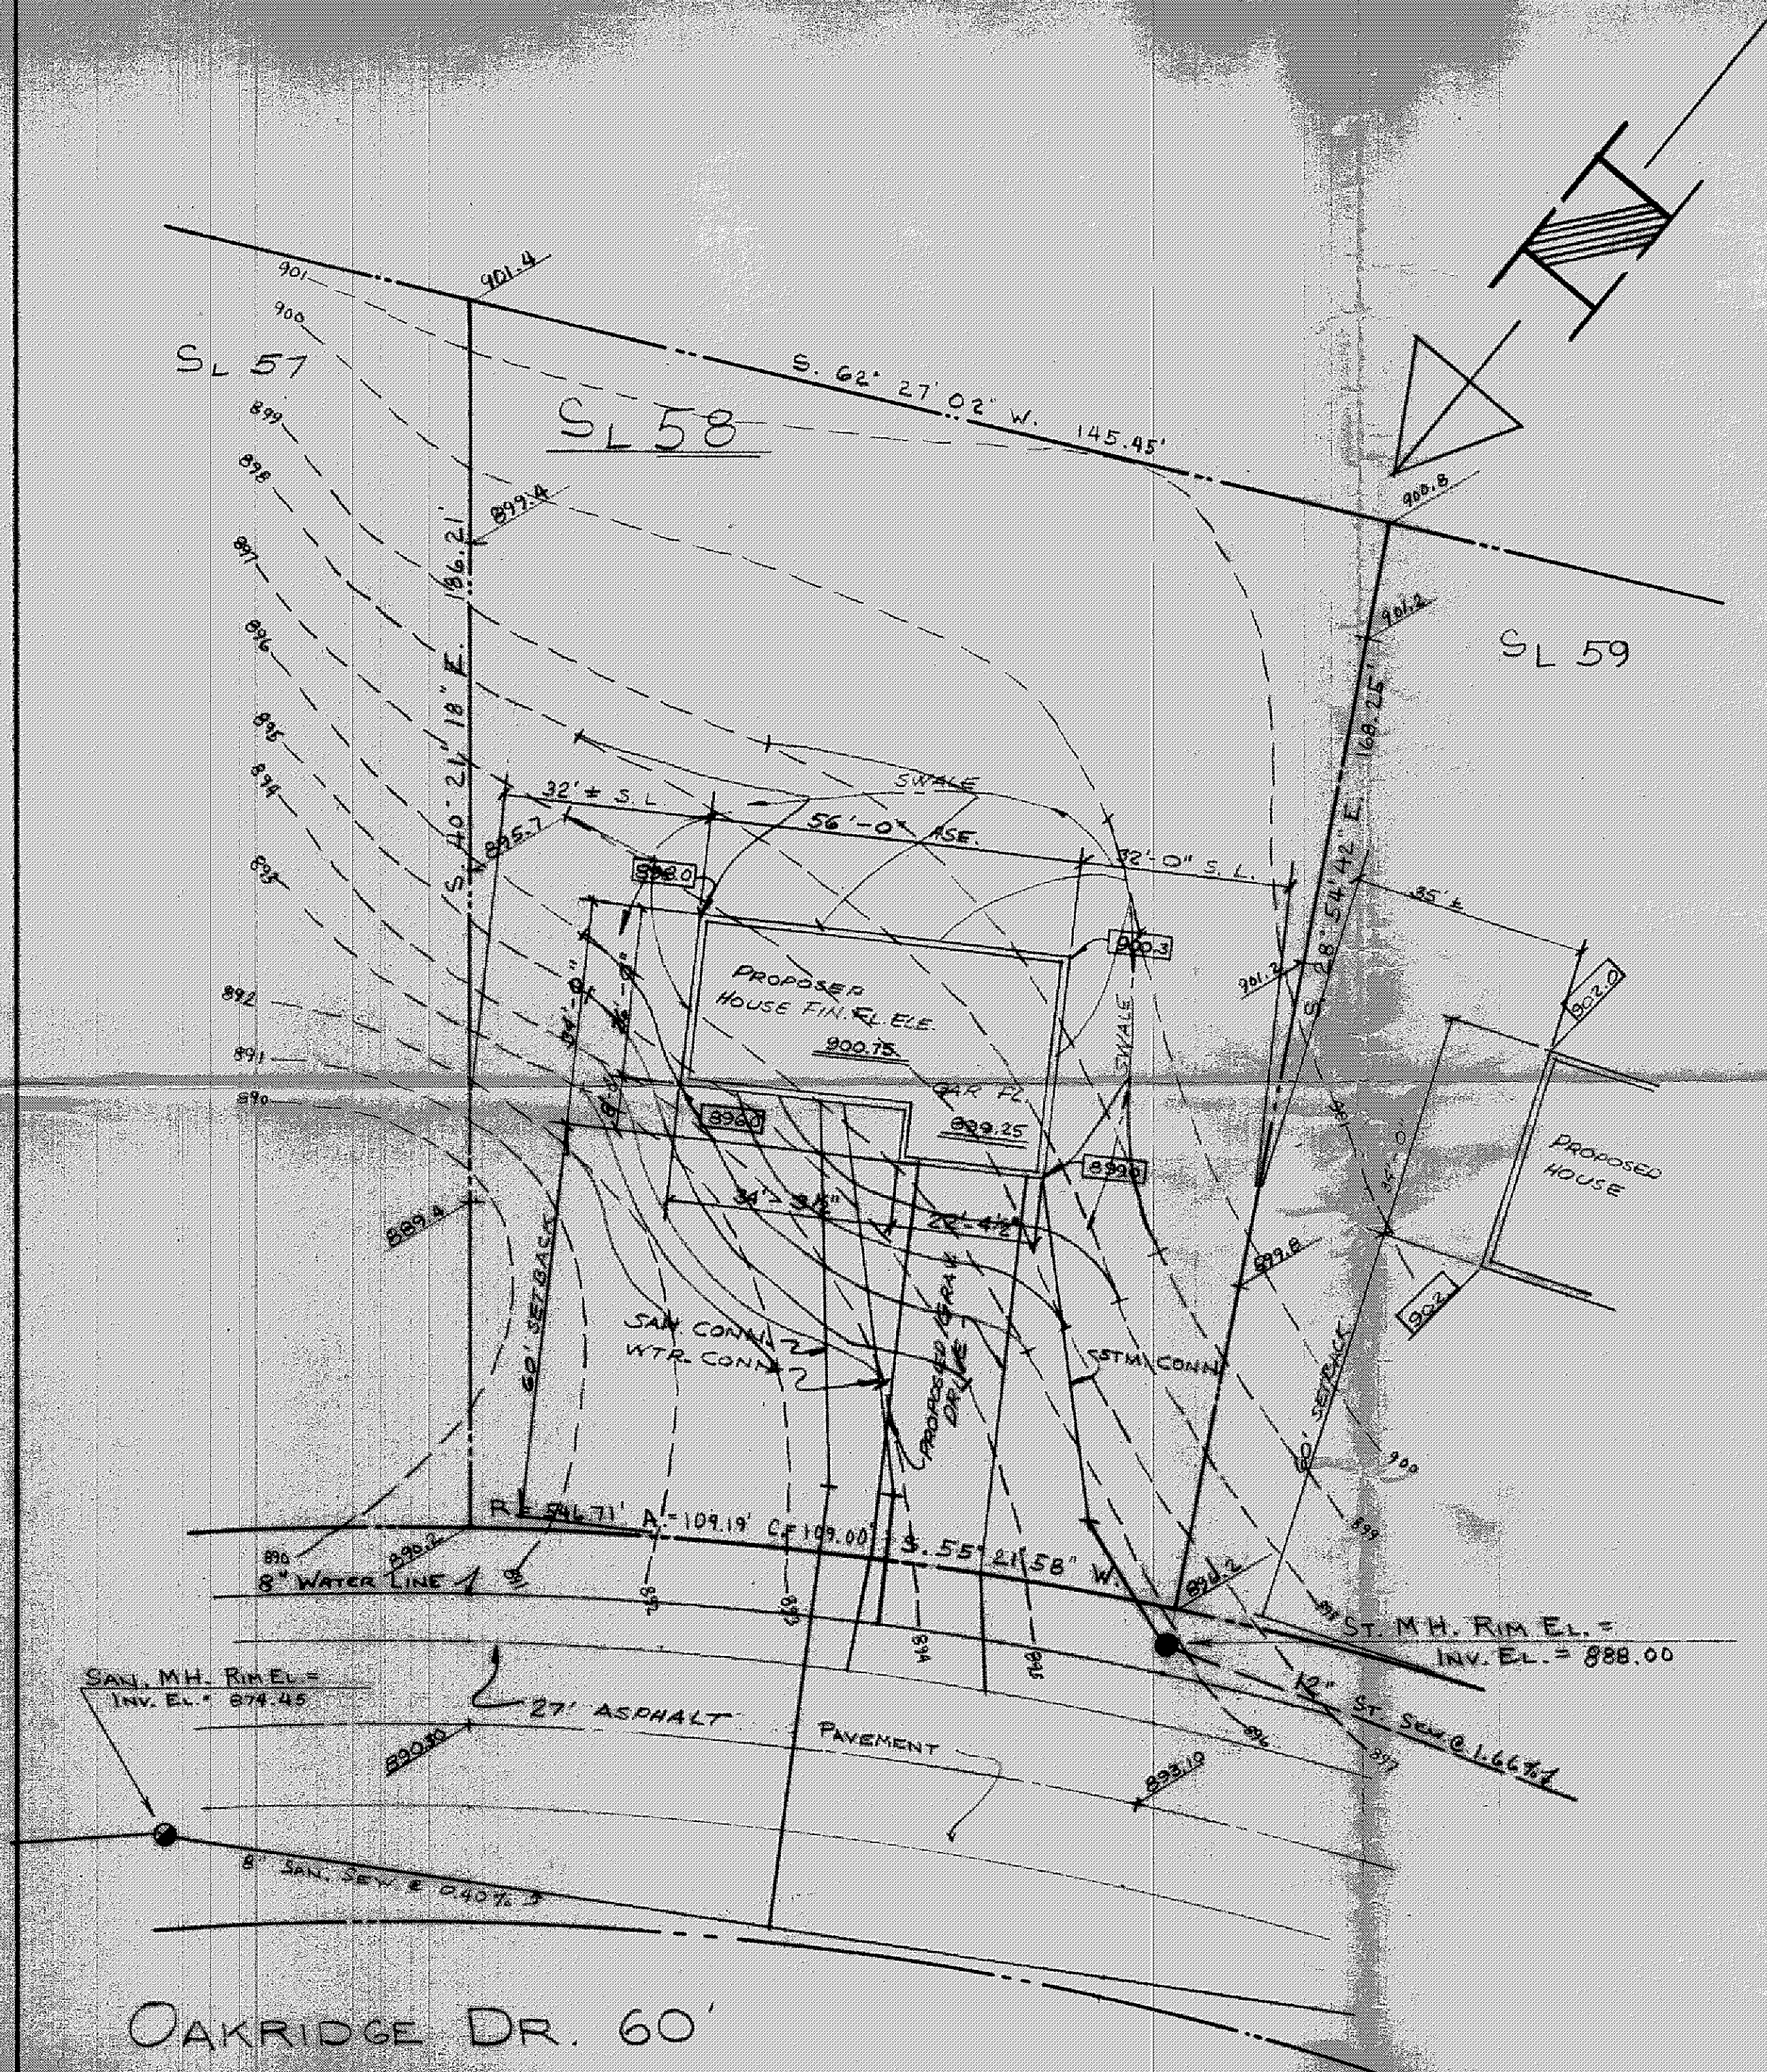

OAKRIDGE DR. 60'