

SITE DRAINAGE PLAN FOR:

SHANDLE CONST.
8353 MENTOR AVENUE
MENTOR, OHIO 44060

BEING SUBLOT NO. 19
IN MORLEY HILLS ESTATES
SUBDIVISION NO. 1
IN CONCORD TWP.
OHIO.

PREPARED BY


WM. R. GRAV ASSOC. INC.
CIVIL ENGINEERS & SURVEYORS
7547 MENTOR AVENUE
MENTOR, OHIO 44060

CERTIFICATION:

I HEREBY CERTIFY THAT THIS
PLAN IS CORRECT TO THE BEST
OF MY KNOWLEDGE

Box 1 Mr. R. Gray

Wm. R. Gray, PE #6421; F.S.#2

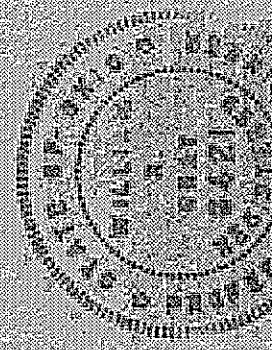


STOLEN MAIL
RIN. 840.32
WV. 831.60
831.50

SOLITARY MANHOLE
KIN. 838.53
INV. 828.02

Don't Report # 269
Noted 4-24-77

OAK RIDGE
D2V
B

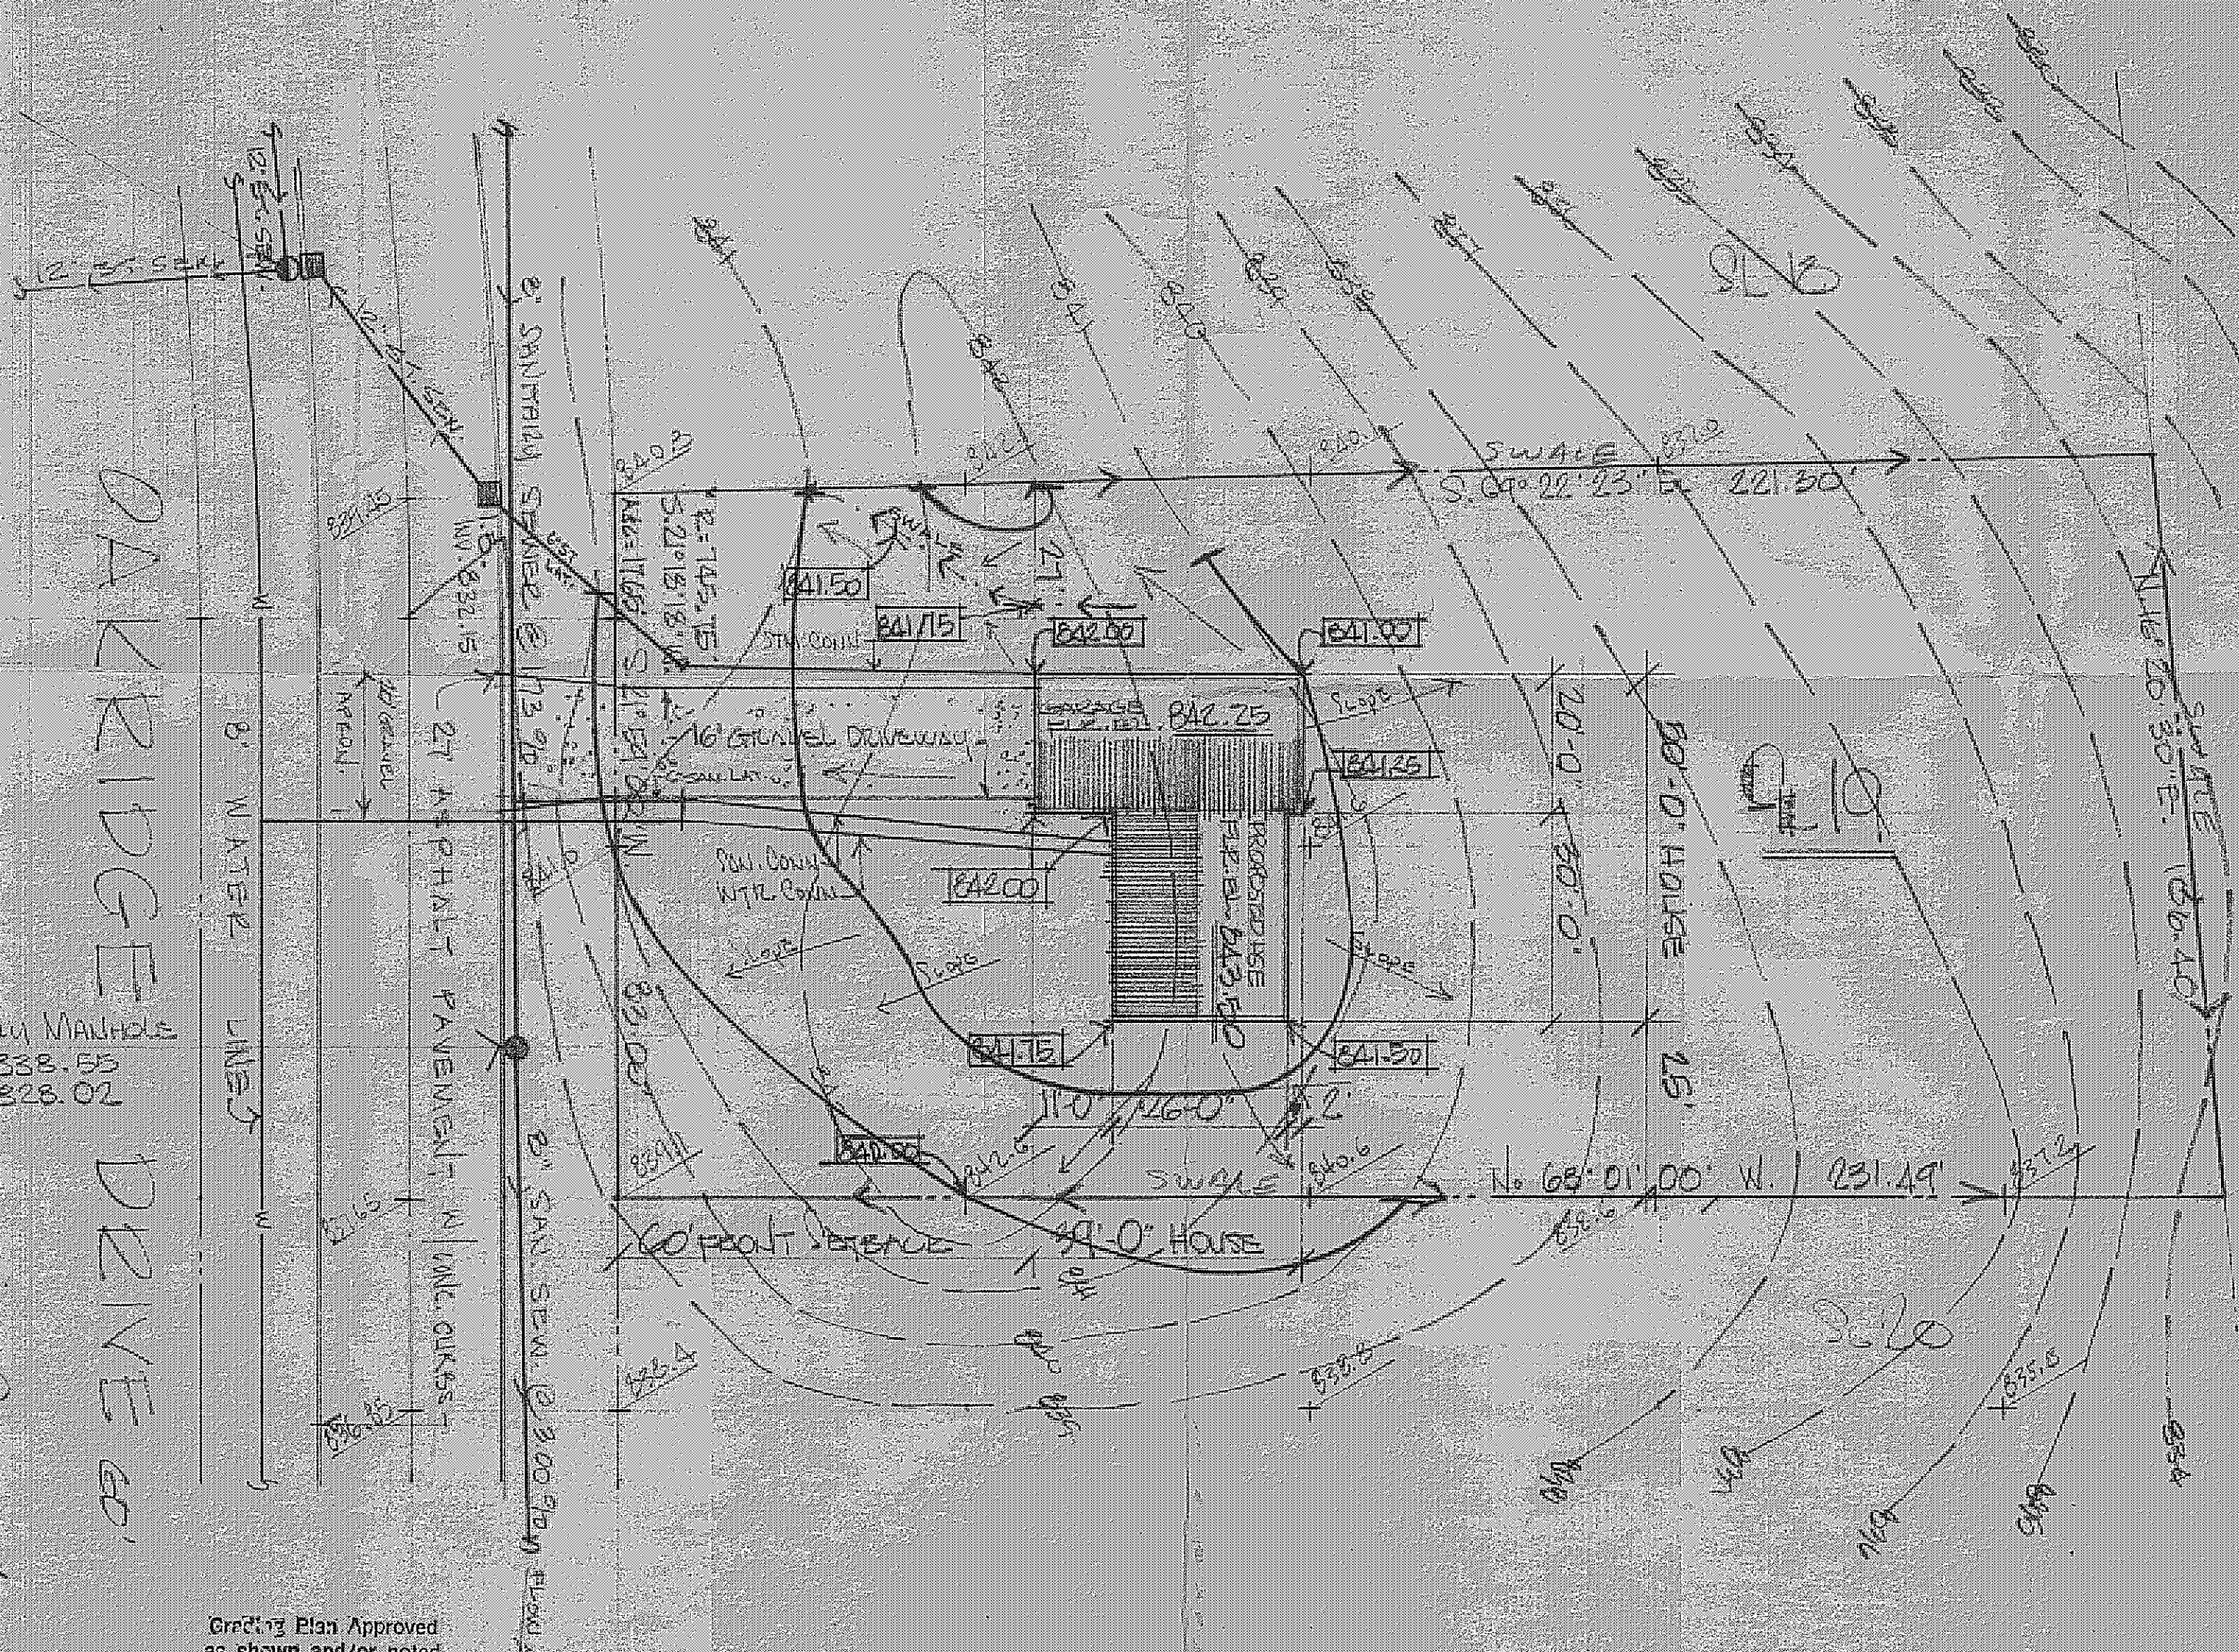

Grading Plan Approved
as shown and/or noted
THOMAS P. GILLES, P.E.
Lake County Engineer

Br DWK Date 4-29-74