

SITE PLAN FOR:

SHANDLE CONSTRUCTION
8353 MENTOR AVE.
MENTOR, OHIO

BEING S.L. No. 11 IN THE MORLEY HILLS
ESTATES SUBDIVISION No. 1 LOCATED
IN CONCORD TWP., OHIO.

PREPARED BY:

WM. R. GRAY ASSOC. INC.
7547 MENTOR AVE.
MENTOR, OHIO

DATE: Nov. 19, 1974

SCALE: 1" = 20'

CERTIFICATION:

I HEREBY CERTIFY THAT THIS
PLAN IS CORRECT TO THE BEST OF MY
KNOWLEDGE.

By: Wm. R. Gray
WM. R. GRAY REG. SURV. #




*Young Permit # 2762
issued 11-20-74
J.E. new sheet*

Grading Plan Approved
as shown and/or noted
THOMAS B. GILLES, P.E.
Lake County Engineer

By: JWK Date: 11/20/74

OAKRIDGE DRIVE 60'

SANITARY M.H.
Rim EL. = 838.52 Inv. EL.

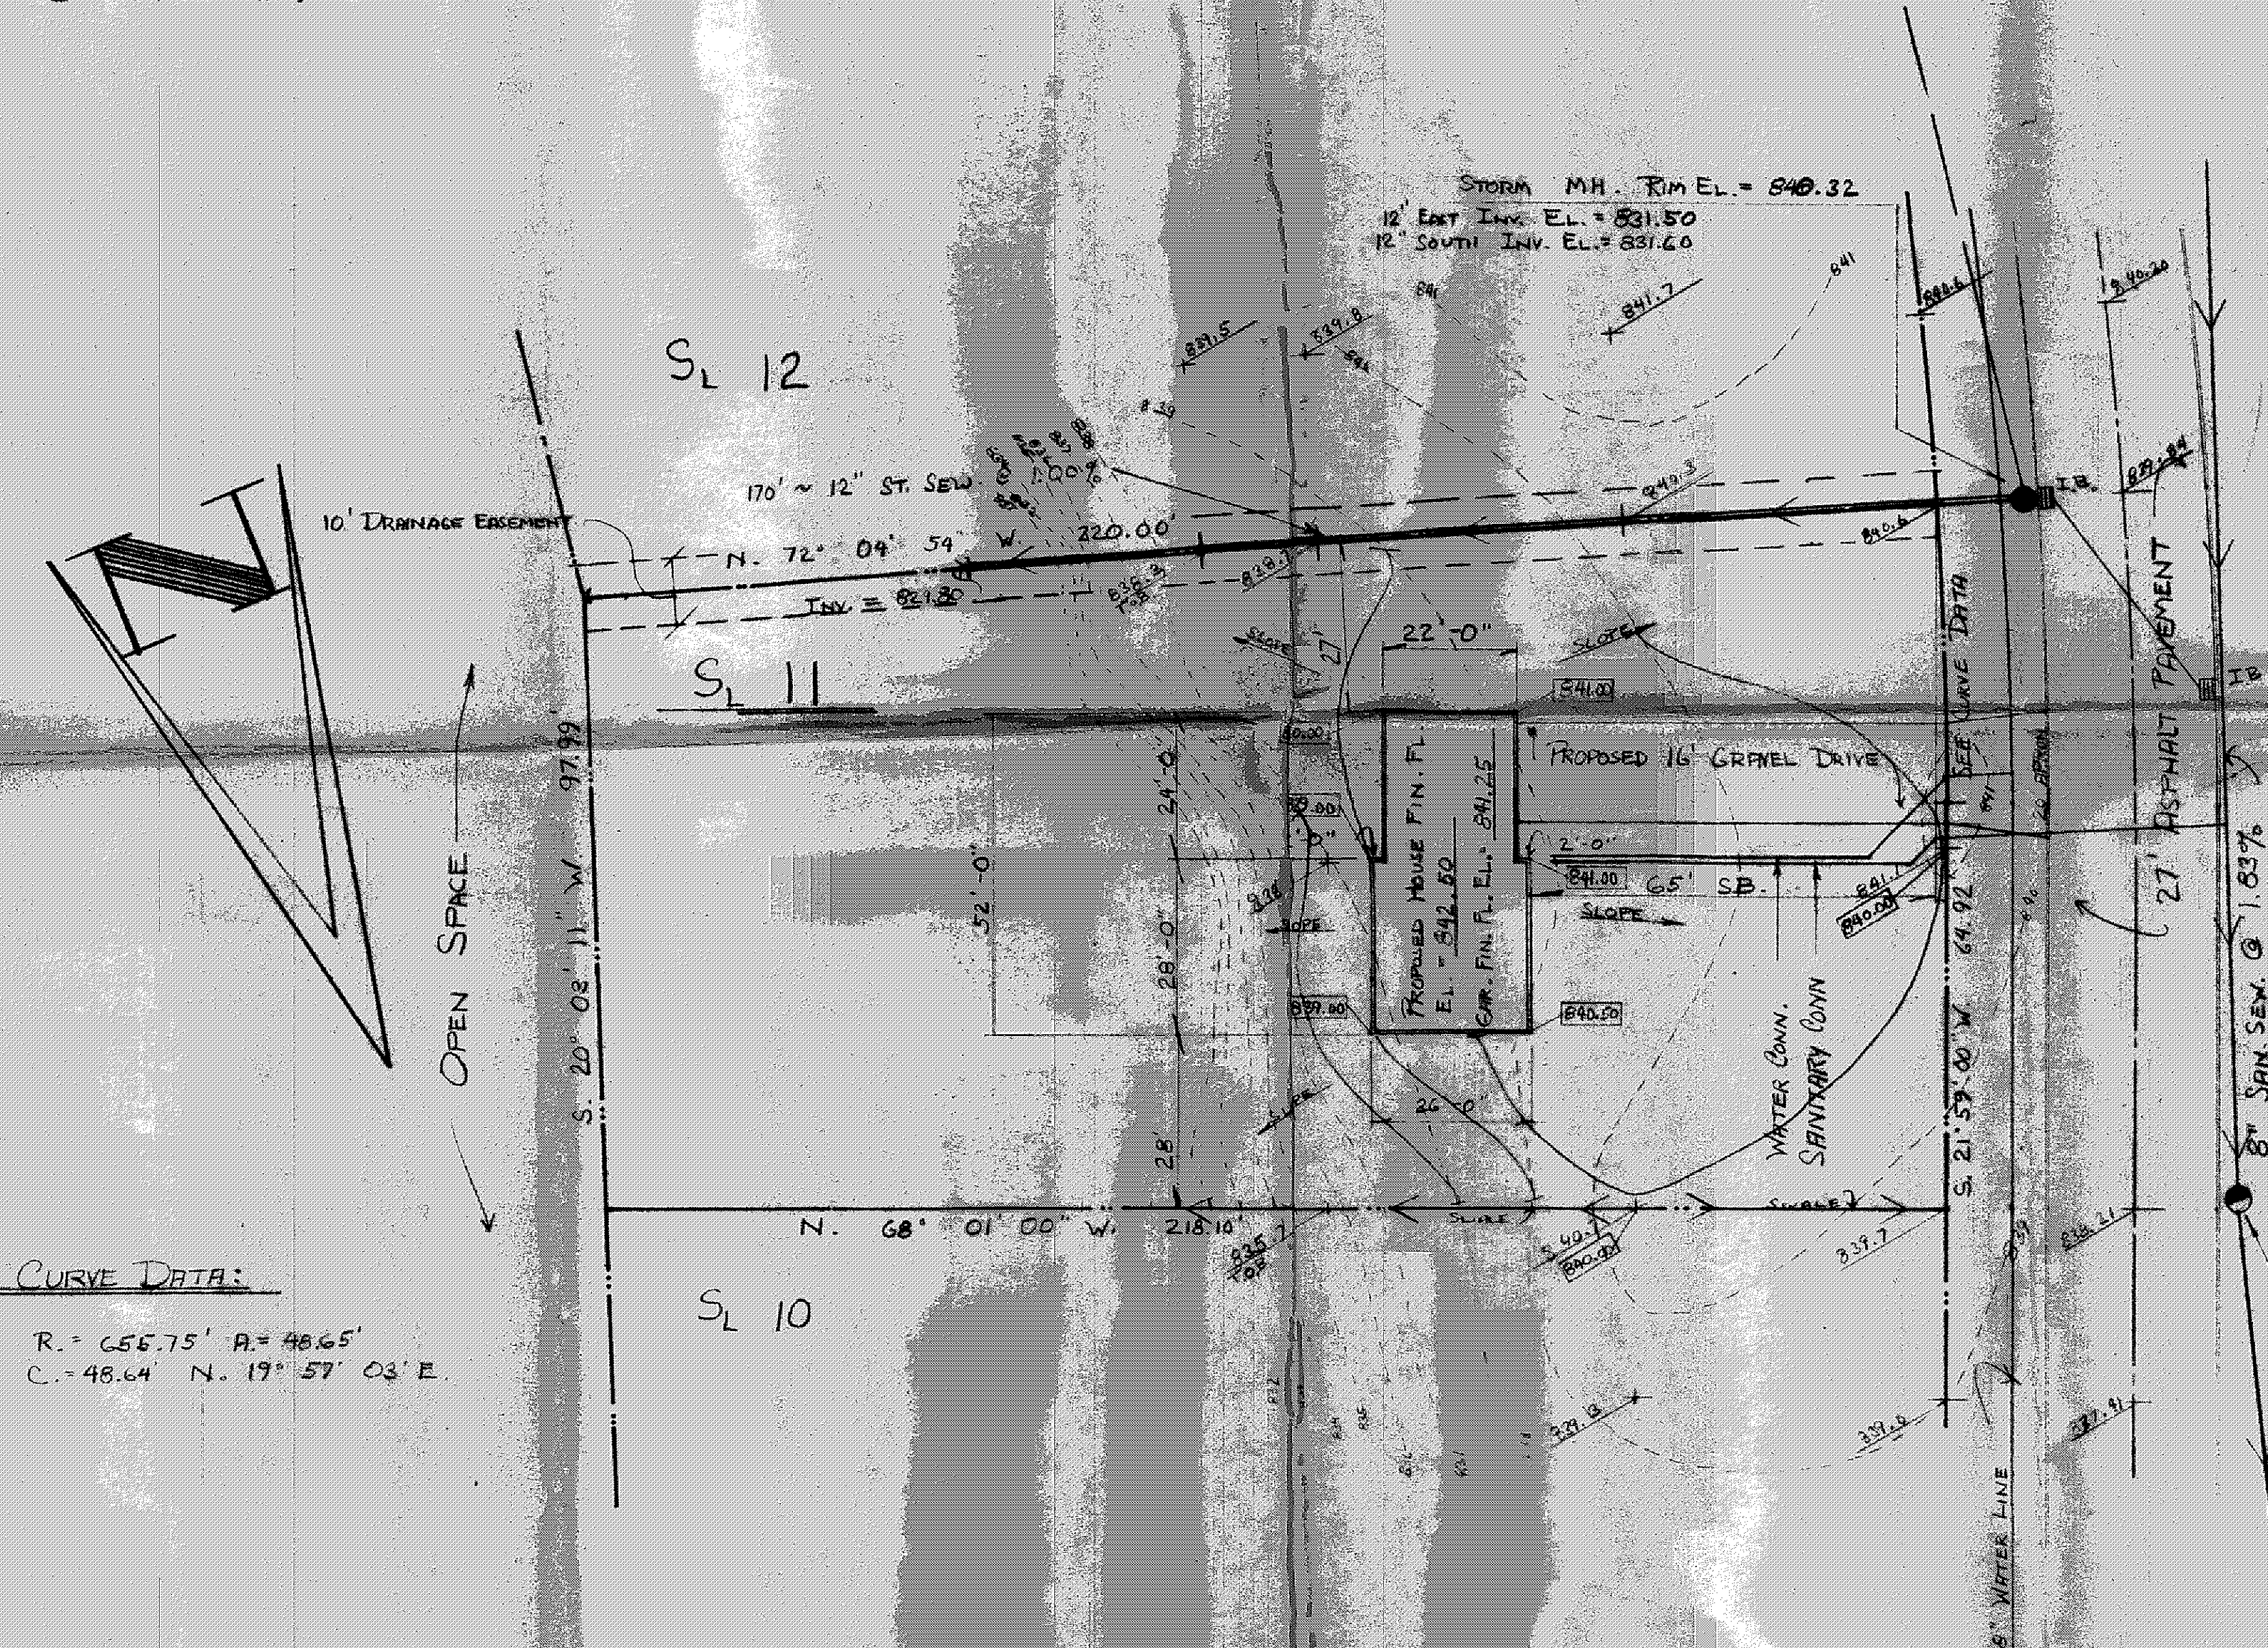

CURVE DATA:

R. = 656.75' A. = 48.65'
C. = 48.64' N. 19° 57' 03" E.