


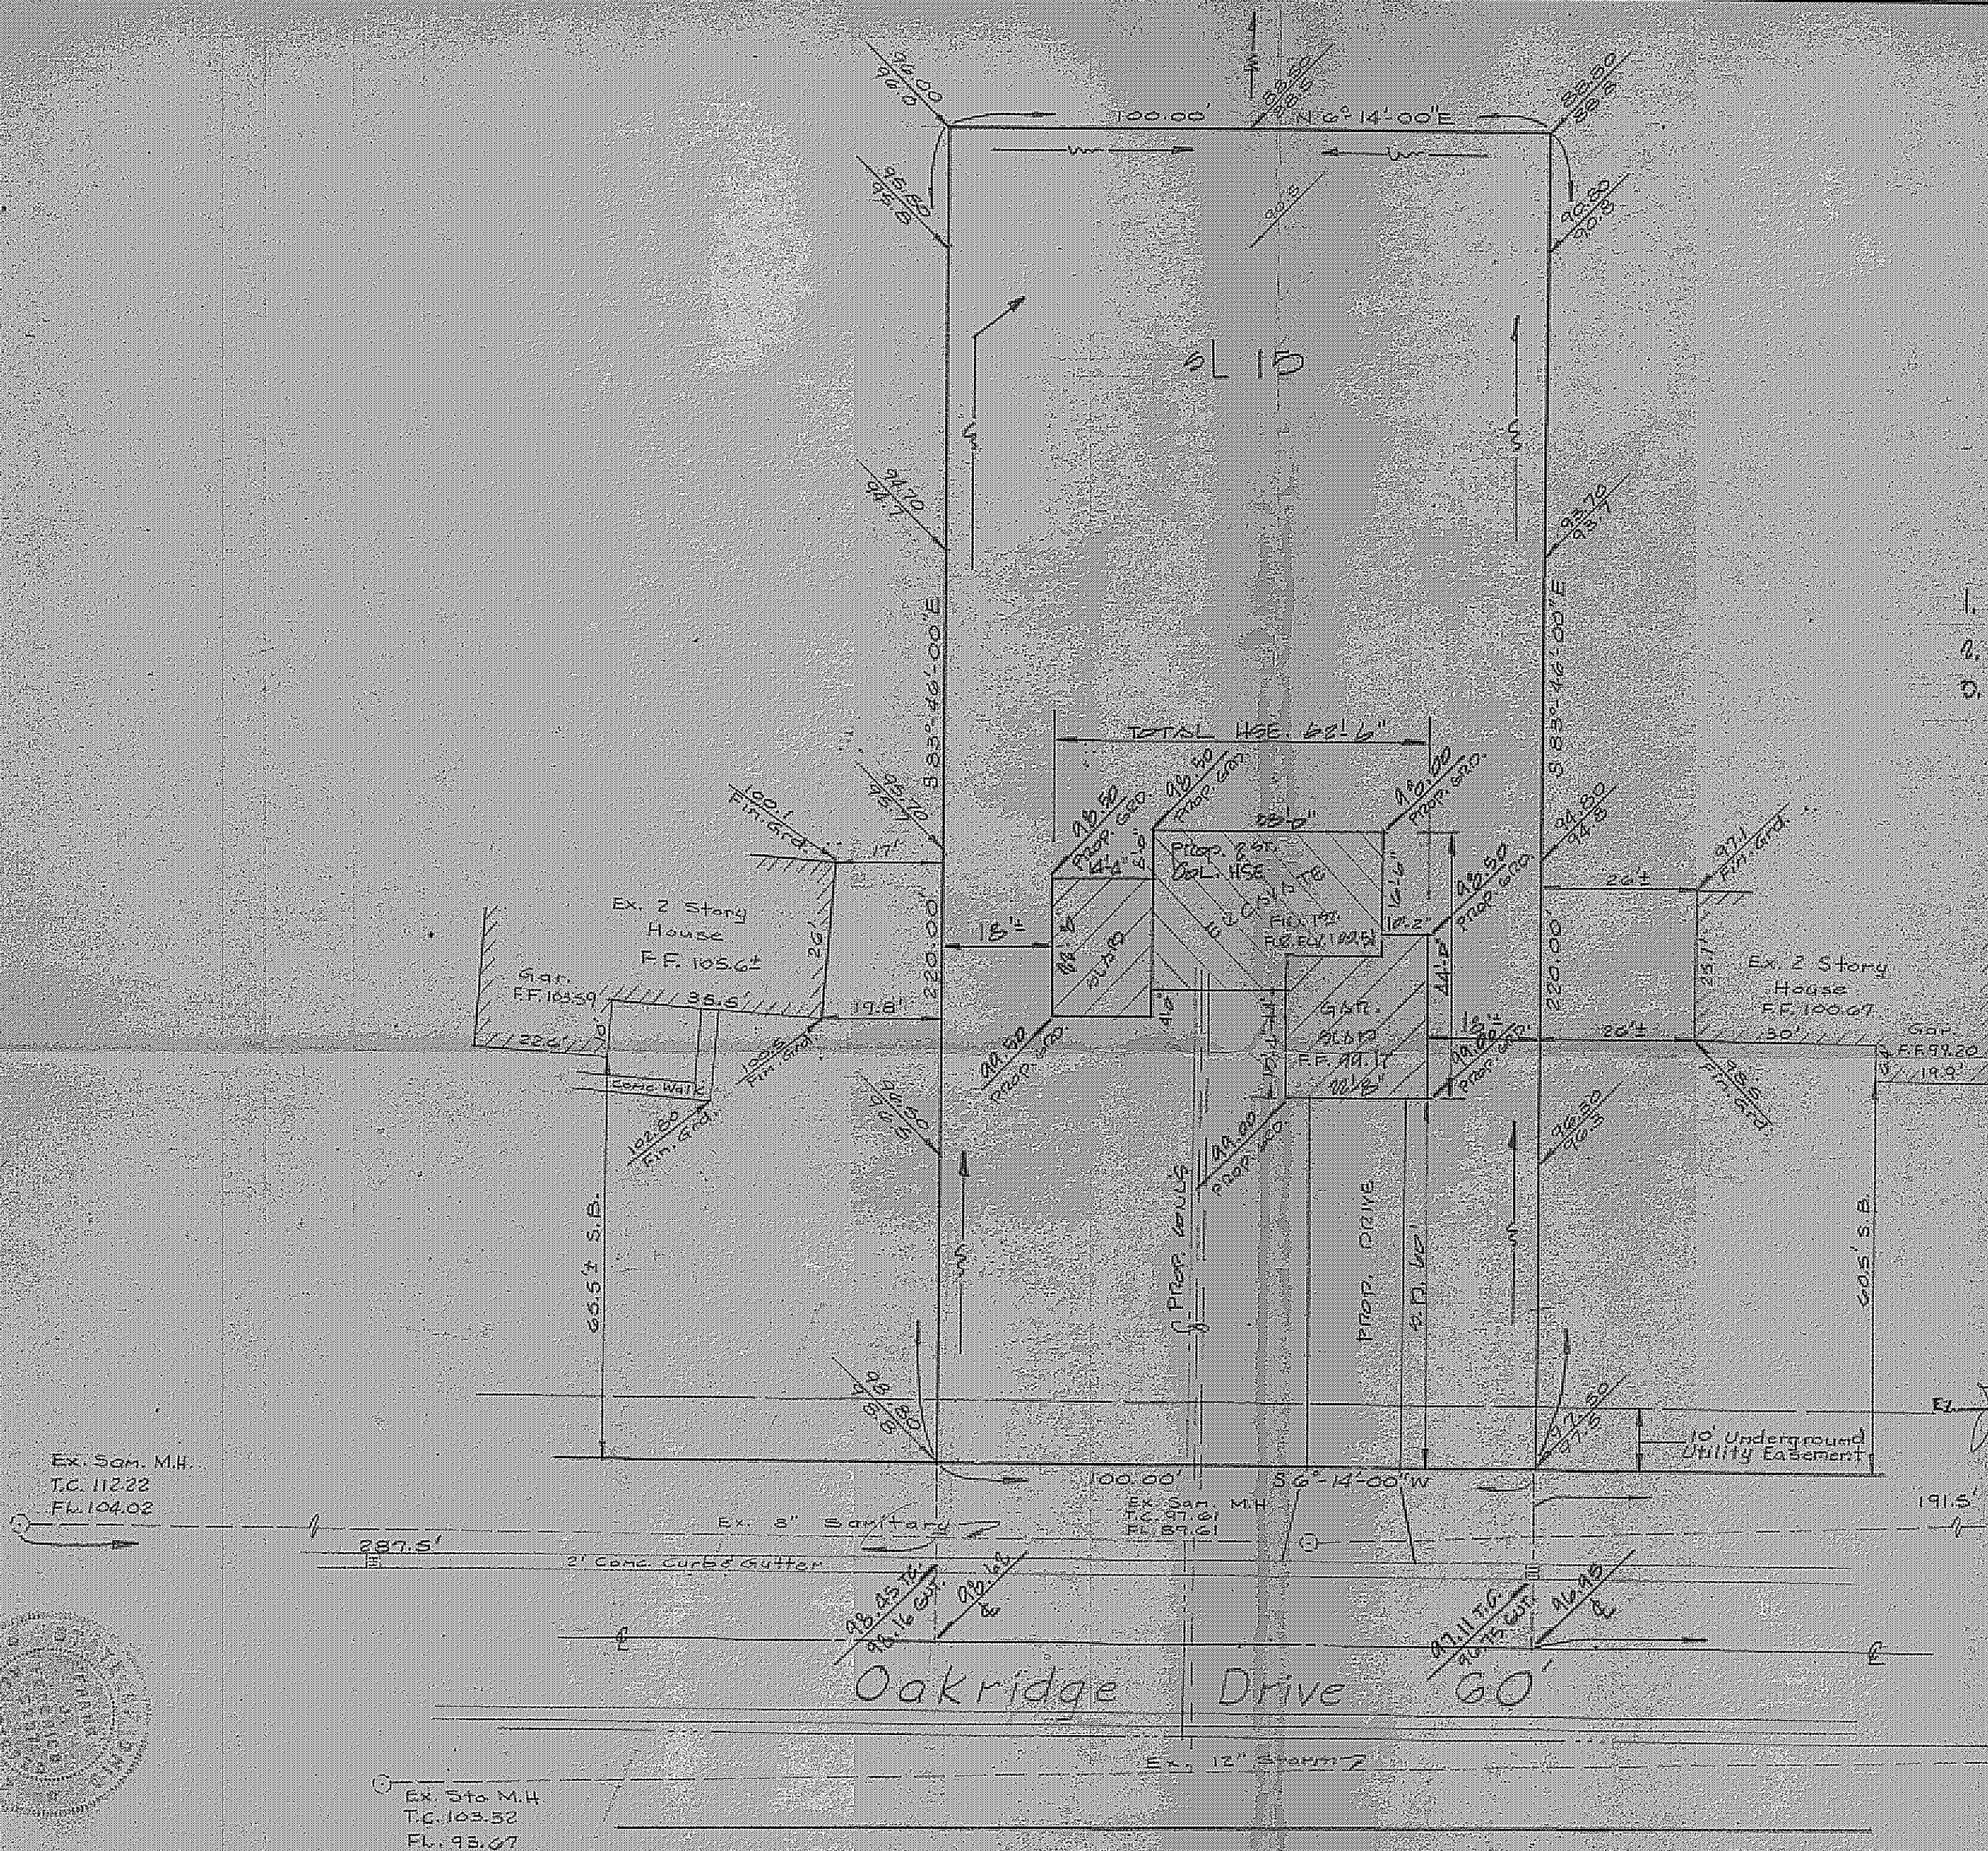

- NOTES:**
1. $\rightarrow$ Prop. EX. ST. GROUND GRADES.
 2. $\rightarrow$ OVERLAND DRAINAGE FLOW.
 3. DEUCH MARK: TOP OF HYD. OPP. S/L 16
EVL. 100.00 ASSUMED.

*Joining #2856
used
NE*

Grading Plan Approved
as shown and for
THOMAS P. GILES, P.E.
Lake County Engineer
Date 6-30-75 F. A. THOMAS & ASSOC. INC.


PRINTED
JUN 24 1975

Ex. San. M.H.
T.C. 95.40
FL 85.60

Ex. Sto. M.H.
T.C. 94.98
FL 85.98

Ex. San. M.H.
T.C. 112.22
FL 104.02

Ex. Sto. M.H.
T.C. 103.52
FL 93.67

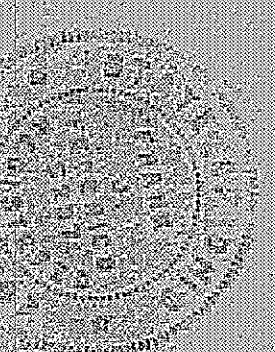

SCALE:
1" = 20'
VERT.
1 of 1
SHEETS



Plot Plan
of S/L 15 in the Morley Hills Estd. Subdivision No 2
for Sam Friedman
Concord Twp., Ohio

FRANK A. THOMAS & ASSOCIATES, INC.
CONSULTING ENGINEERS
WILLOUGHBY, OHIO

DRAWN BY: Smith
CHECKED BY:
DATE: 6-20-75