

LEGEND

IPnF/S - Iron Pin Found/ Set
 IPnF+U - Iron Pin Found and Used
 IPF/S - Iron Pipe Found/ Set
 IPF+U - Iron Pipe Found and Used
 PKF/S - PK nail Found/ Set
 PKF+U - PK nail Found and Used
 DHF+U - Drill Hole Found and Used
 D&M - Deed and Measured

- Existing
 - Proposed

Site Plan




PREPARED FOR

Carla Collins & Mike Santoli

BEING PART OF ORIGINAL LOT 31, TRACT 4, IN THE TOWNSHIP OF CONCORD,
 COUNTY OF LAKE, STATE OF OHIO ALSO KNOWN AS PPN 10A-028-00-030.

NOTES

- 1) All iron pins found are #5 rebar unless otherwise noted.
- 2) Downspouts to Splashblocks.

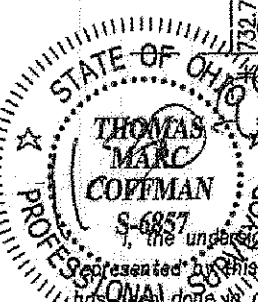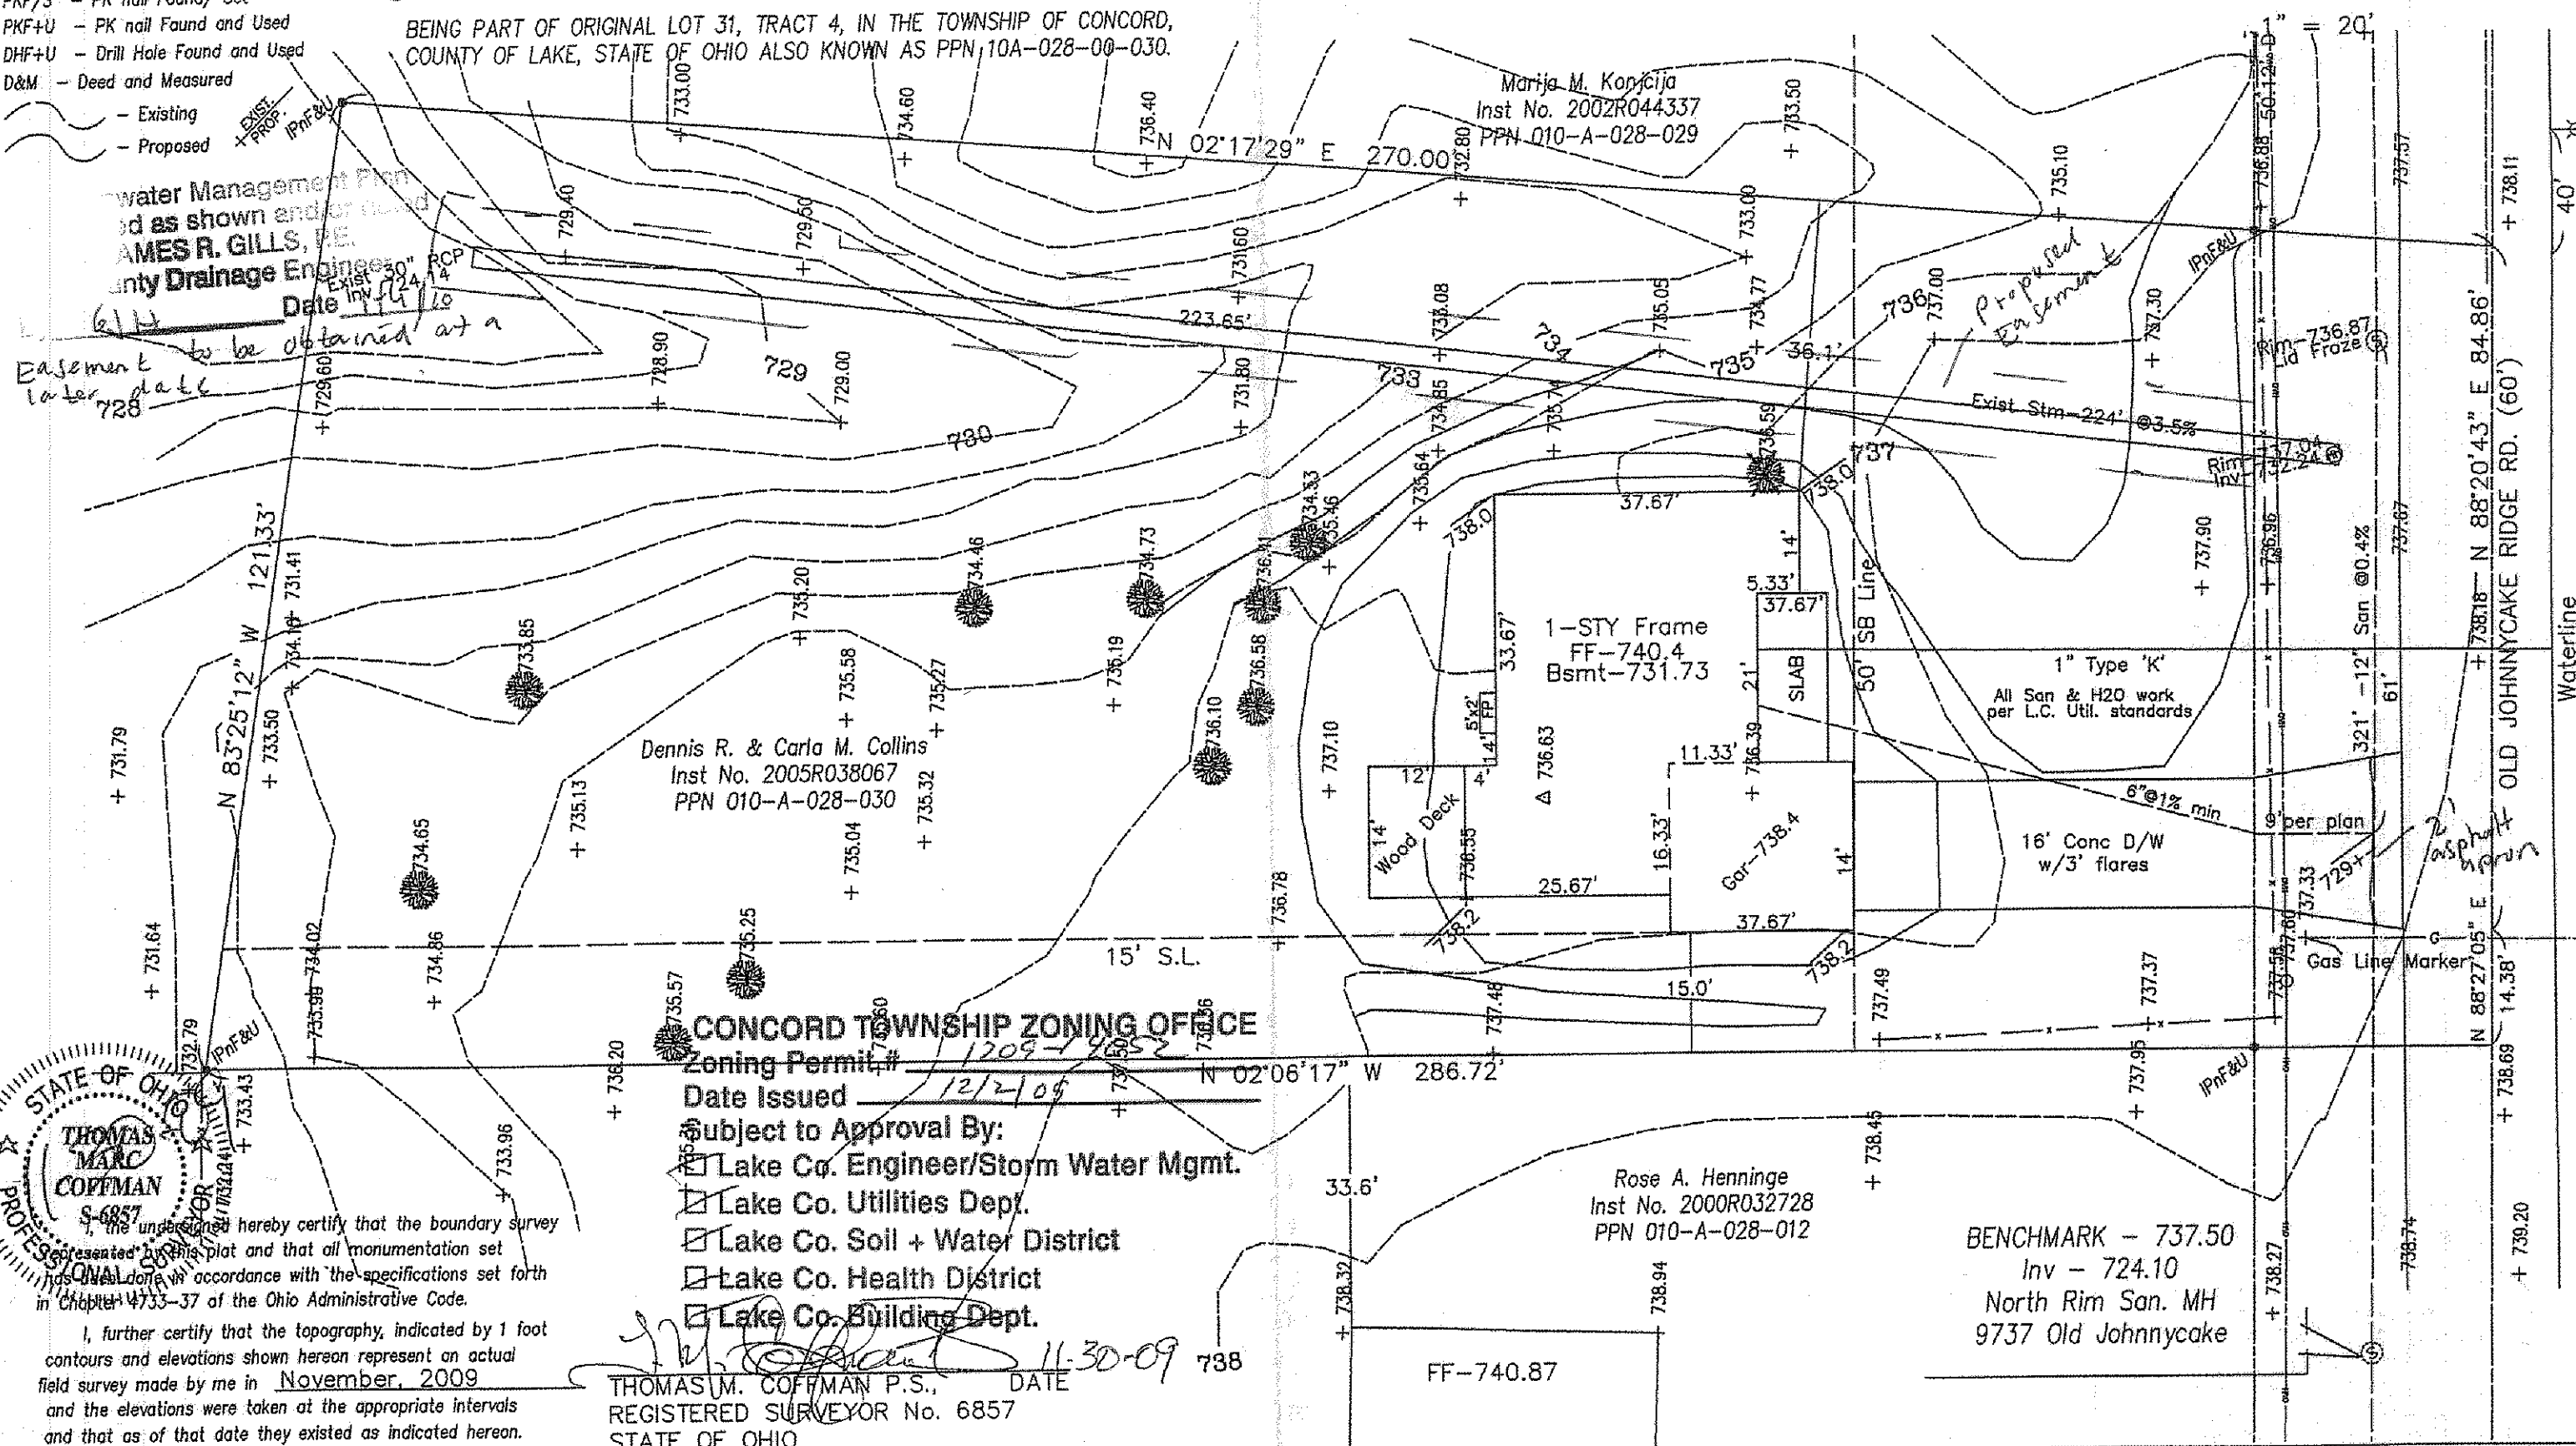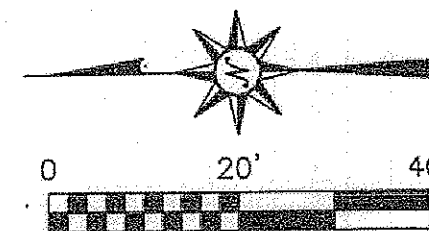

I, the undersigned hereby certify that the boundary survey represented by this plat and that all monumentation set has been done in accordance with the specifications set forth in Chapter 4733-37 of the Ohio Administrative Code.

I, further certify that the topography, indicated by 1 foot contours and elevations shown hereon represent an actual field survey made by me in November, 2009 and the elevations were taken at the appropriate intervals and that as of that date they existed as indicated hereon.

CONCORD TOWNSHIP ZONING OFFICE

Zoning Permit # 1209-19652

Date Issued 12/2/09

Subject to Approval By:

- ☒ Lake Co. Engineer/Storm Water Mgmt.
- ☒ Lake Co. Utilities Dept.
- ☒ Lake Co. Soil + Water District
- ☒ Lake Co. Health District
- ☒ Lake Co. Building Dept.

THOMAS M. COFFMAN P.S., DATE 11-30-09
 REGISTERED SURVEYOR No. 6857
 STATE OF OHIO

THOMAS M. COFFMAN P.S.

622 HIDDEN HARBOR DR., FAIRPORT HARBOR, OH 44077 TEL: 440-357-1359 CELL: 440-413-0524