



HERBERT & SOUTH LANSING AVE
VOL 401 PG 400

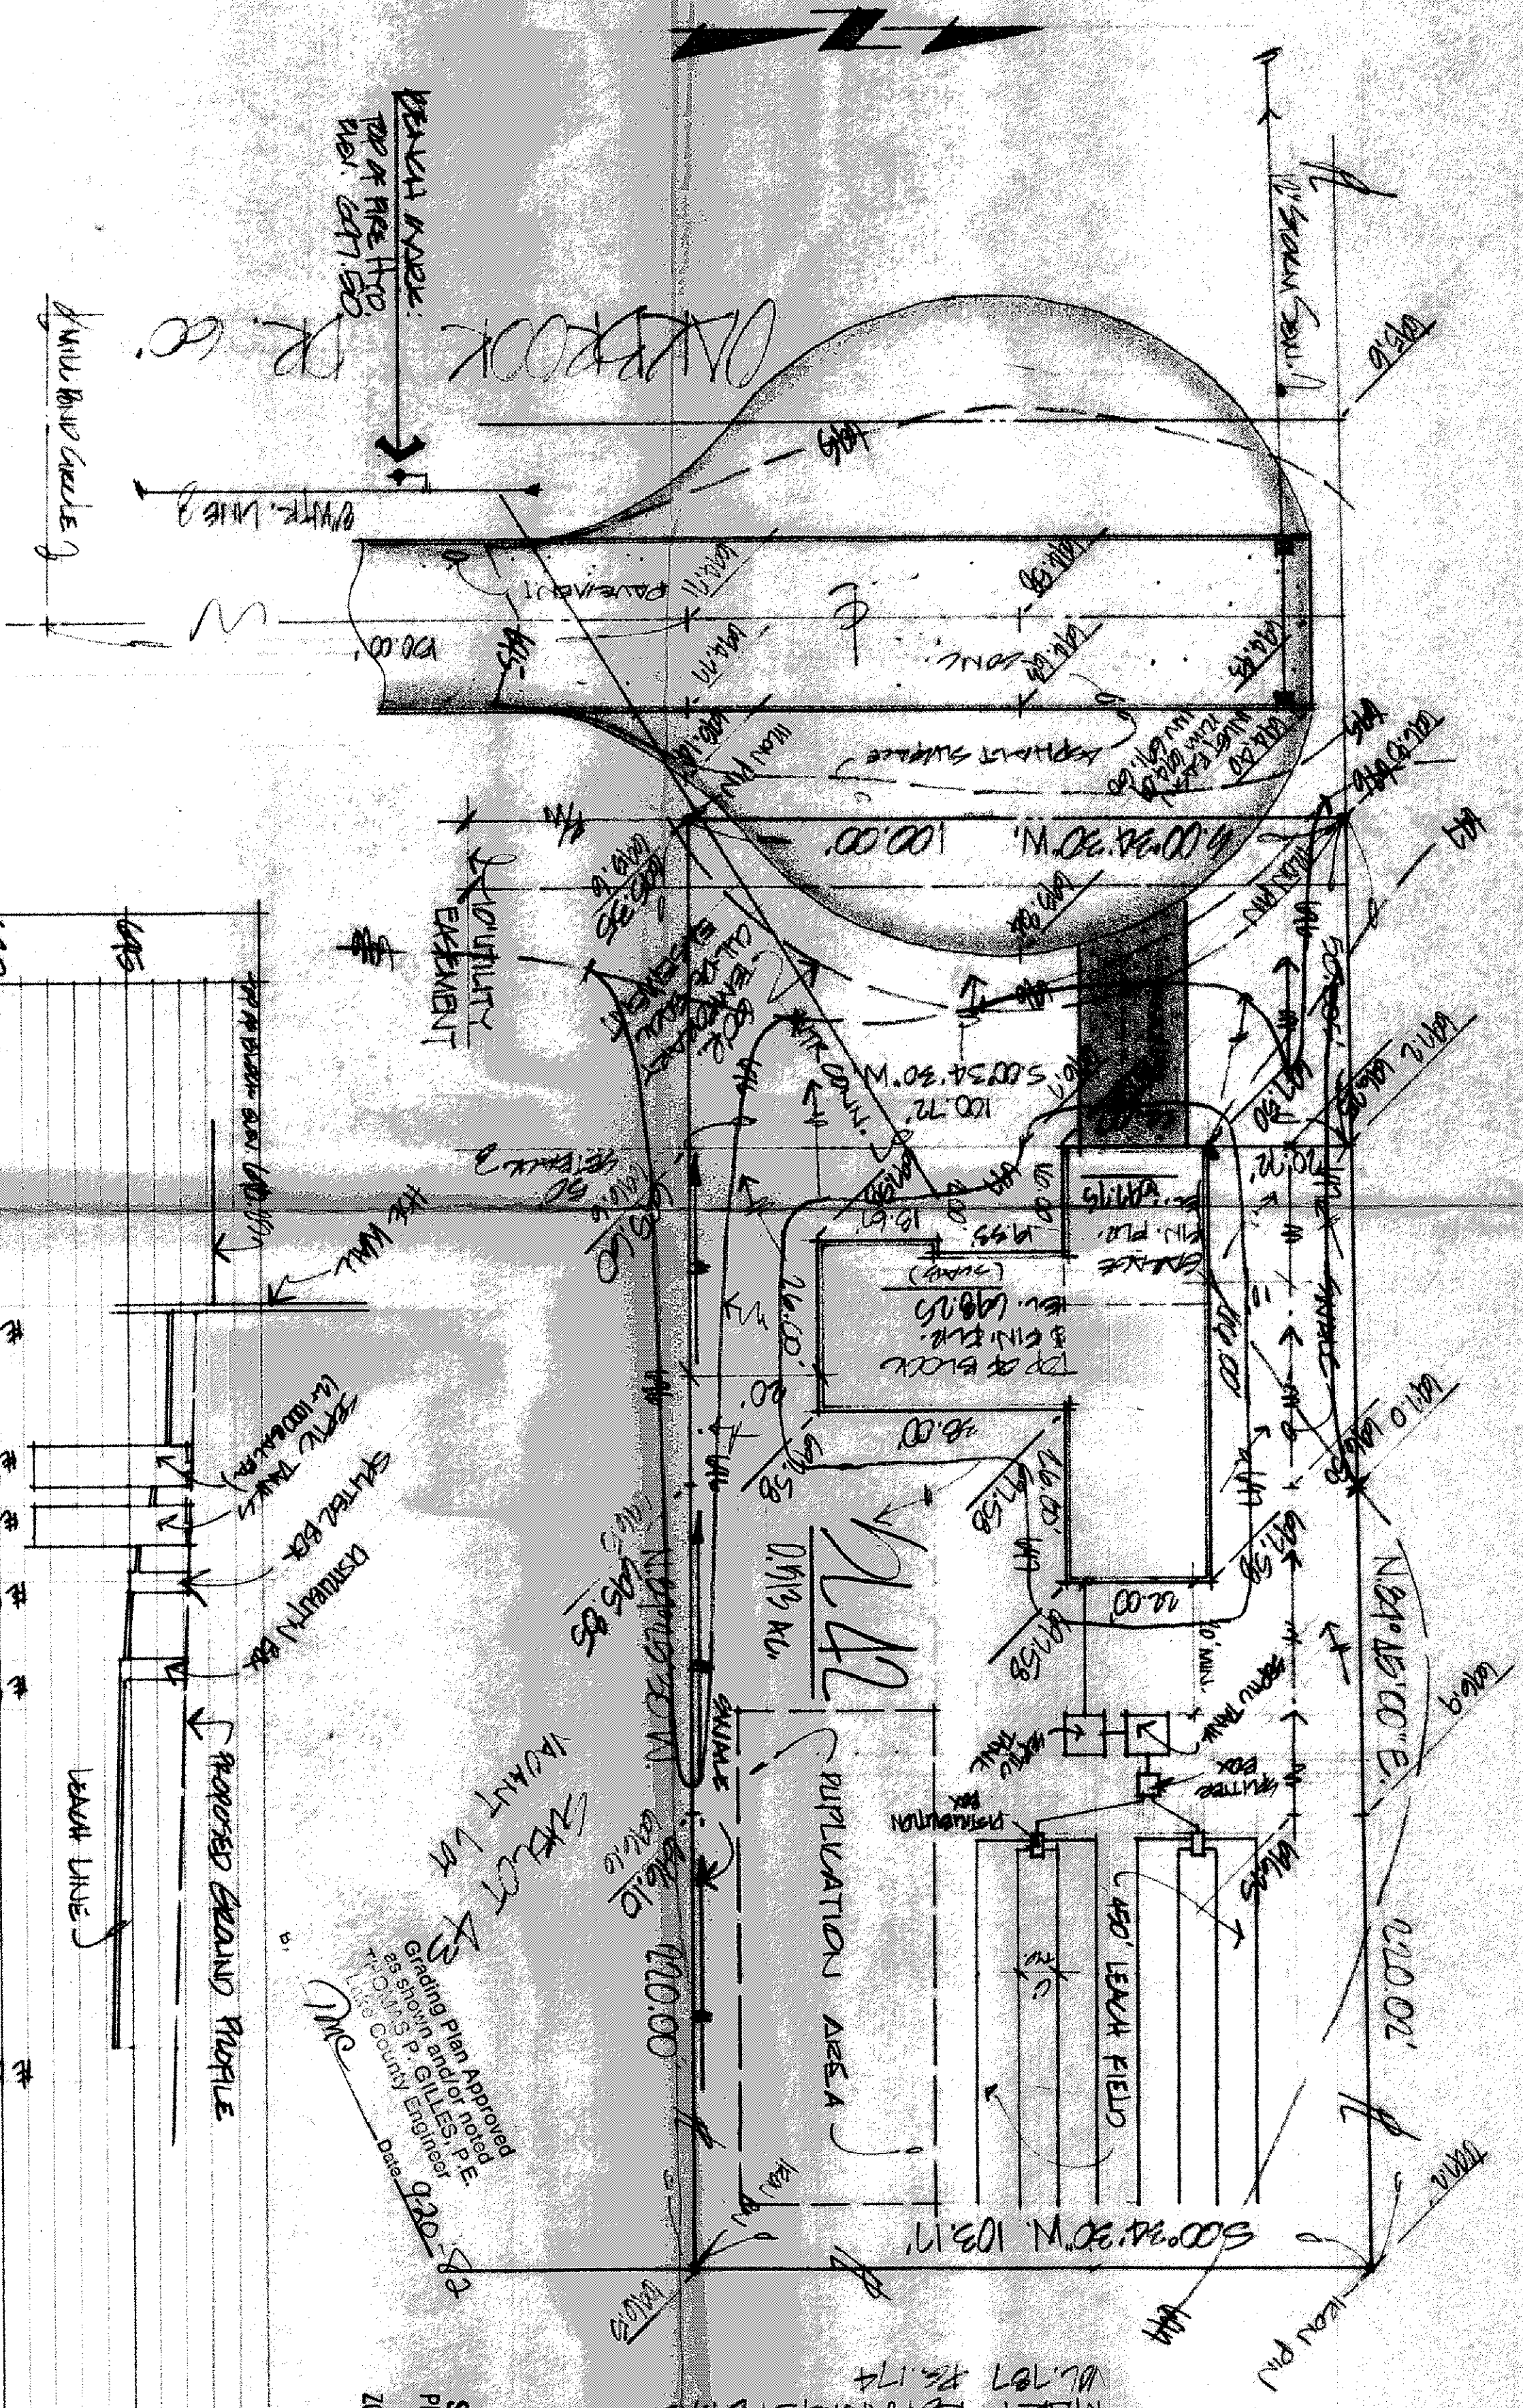

APPROVED
SIDE LINES & SET BACK
PERRY TOWNSHIP ZONING
E. ALL NO. 2625
ZONING INSPECTOR

SYSTEM PROFILE

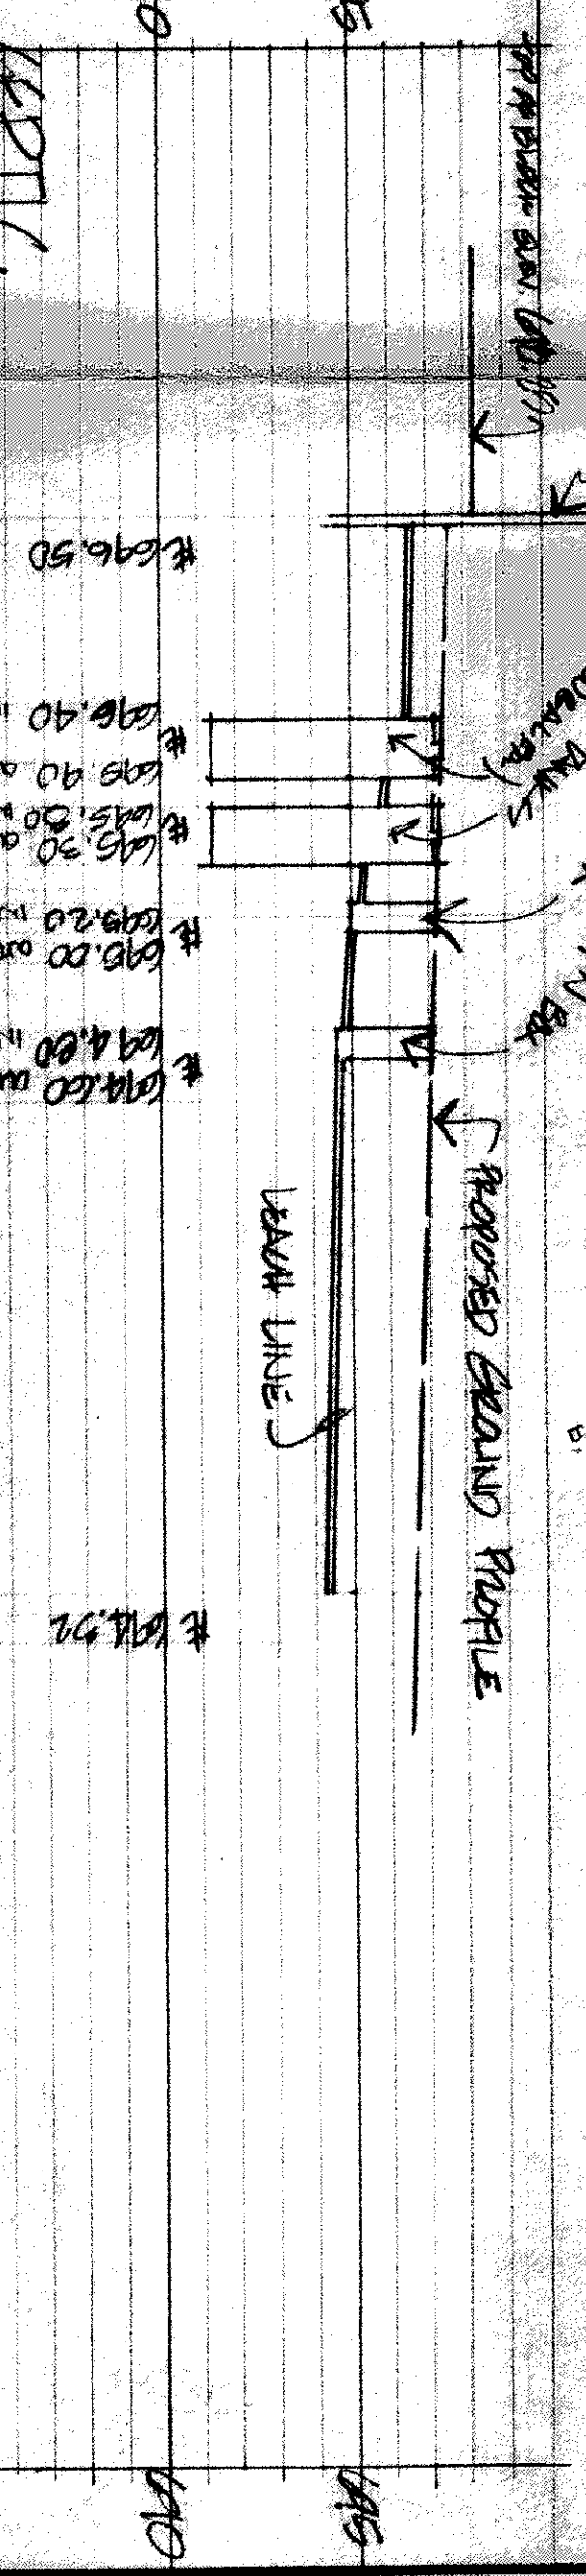

NOTE: UNDEVELOPED AREAS INDICATE PROPOSED GRADES.

DESIGN CERTIFICATION
THIS PLAN WAS PREPARED BY ME
AND I AM A LICENSED PROFESSIONAL ENGINEER
IN THE STATE OF OHIO.

AS BUILT CERTIFICATION
I HAVE EXAMINED THE CONSTRUCTION
AND FOUND IT TO BE IN ACCORDANCE
WITH THE DESIGN AND SPECIFICATIONS
AND I AM CERTIFIED TO THE BEST OF MY
KNOWLEDGE AND BELIEF.

DATE: 08/14/20
SCALE: 1\"/>
DRAWN BY: [Signature]
CHECKED BY: [Signature]
DATE: 08/14/20

COLPETZER WOODS
CONSULTANTS, INC.
MENTOR, OHIO 44060