
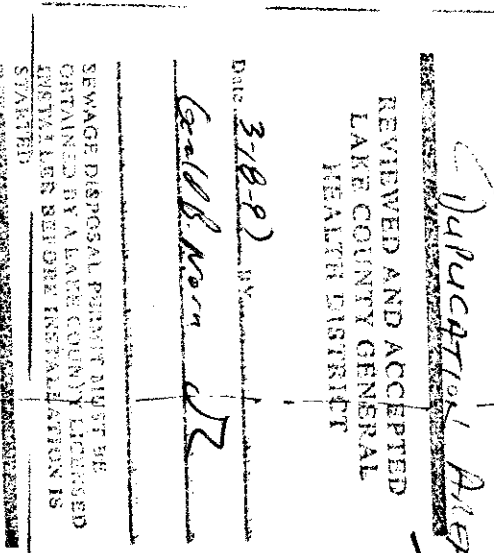
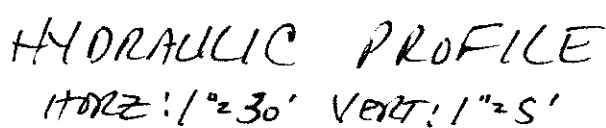


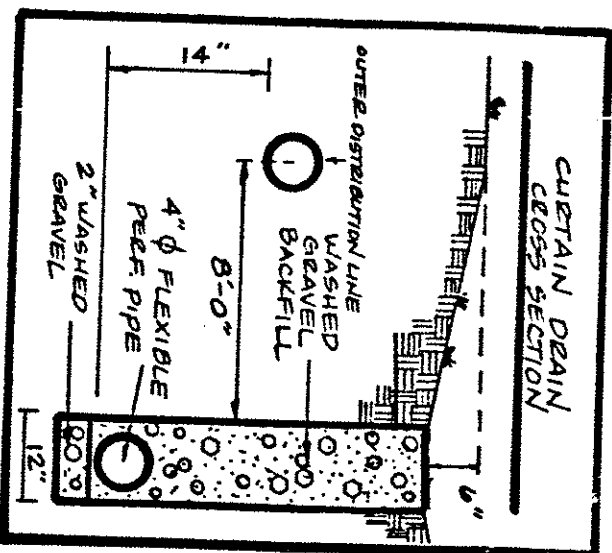

Name	Reg. No.
John J. Jones	12345

"I, the undersigned, hereby certify that this topographic map, created by 6", 1" or 2" contours, and the elevations shown hereon represent an actual field survey made by me on the 10th day of March, 1977 and that the elevations were taken at appropriate intervals and that as of that date they existed as indicated hereon."