

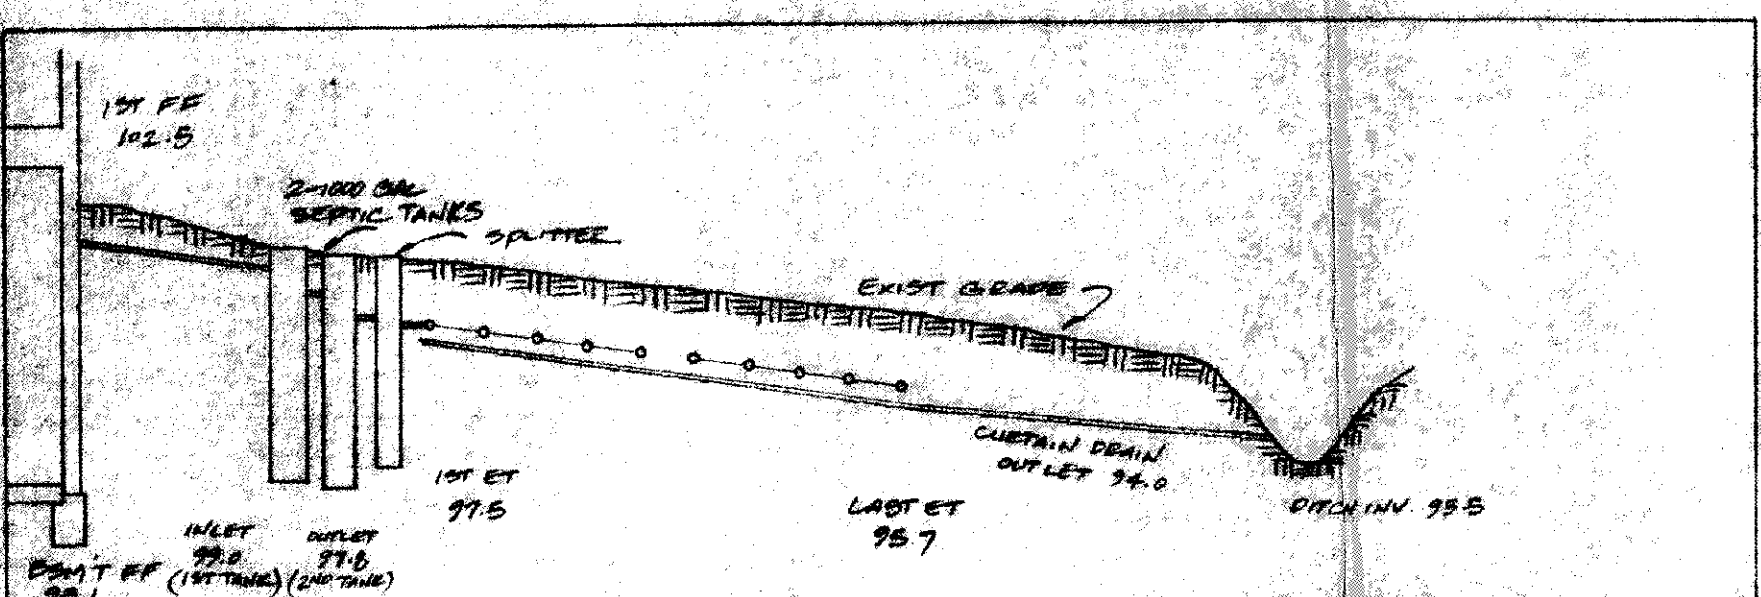
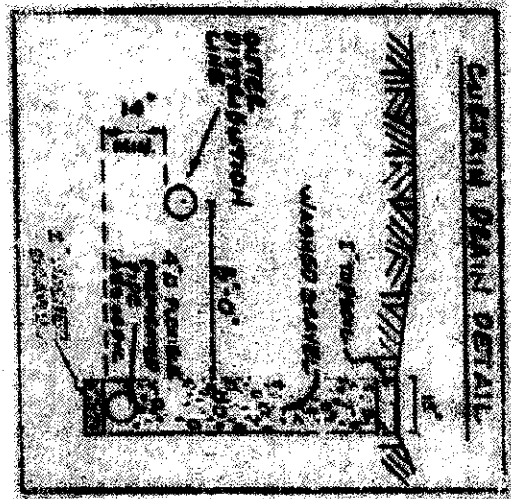
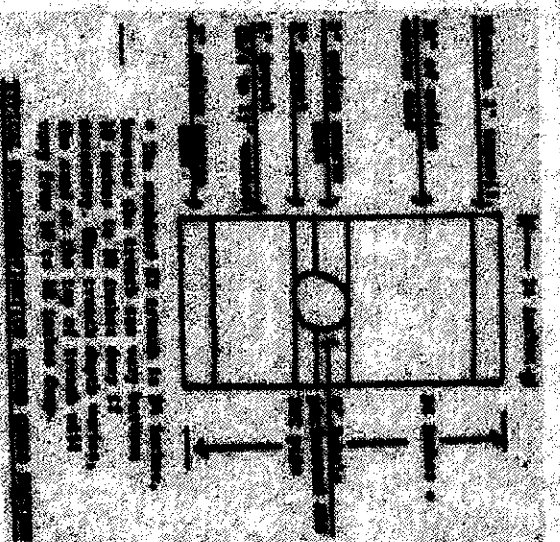


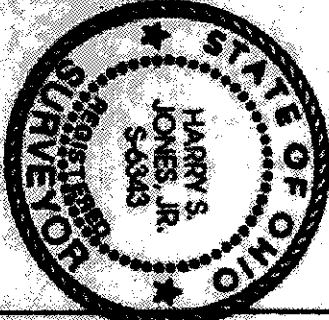

HYDRAULIC PROFILE
SCALE: HORIZ. 1"=50', VERT. 1"=5'

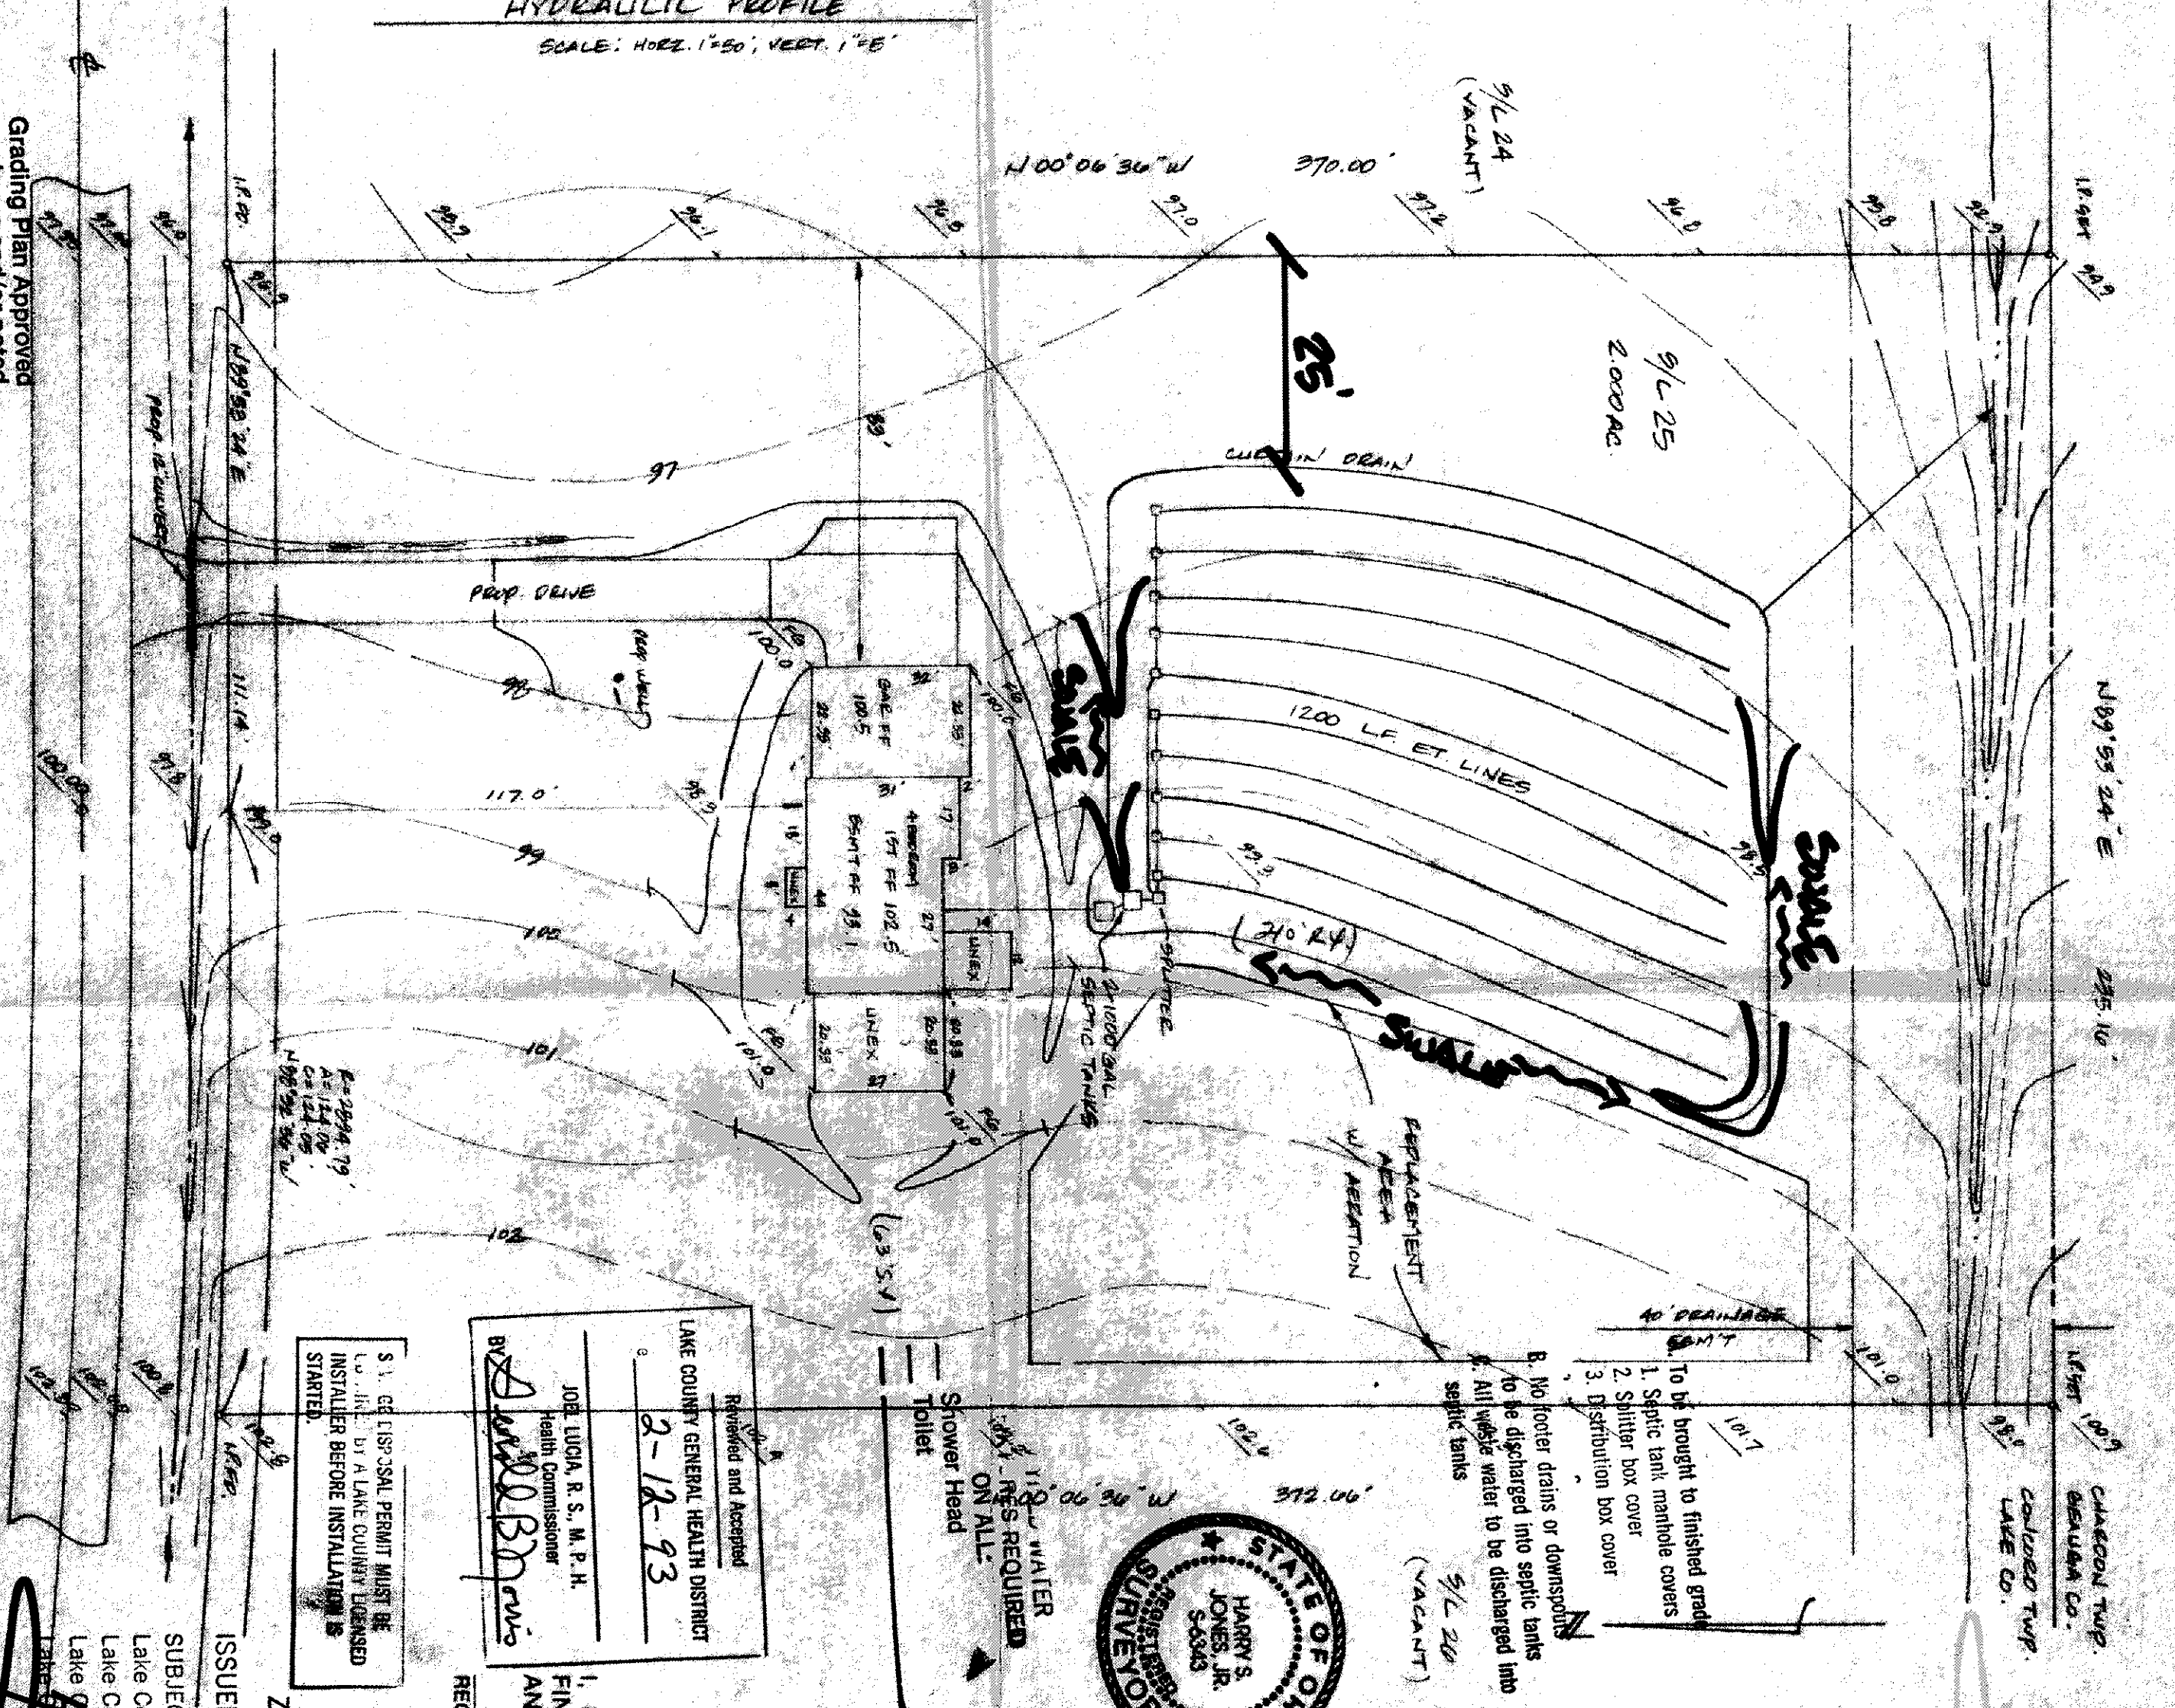

Reviewed and Accepted
JOE LUGA, R. S., M. P. H.
Health Commissioner
2-18-93
BY: [Signature]

S. J. LESSMAN
REGISTERED SURVEYOR
INSTALLED BEFORE INSTALLATION
STARTED

REVISIONS		PLAN PREPARED BY:	
NO.	DATE	BY	DATE
1			
2			
3			
4			
5			

CHECK LIST	
NO. OF BEDROOMS	WATER MAIN SIZE, LOCATION
NO. OF BATHS	SEWER SIZE, LOCATION
NO. OF KITCHENS	STORM SEWER SIZE, LOCATION
NO. OF GARAGES	STORM SEWER SIZE, LOCATION
NO. OF PORCHES	STORM SEWER SIZE, LOCATION
NO. OF DRIVEWAYS	STORM SEWER SIZE, LOCATION
NO. OF PATIO'S	STORM SEWER SIZE, LOCATION
NO. OF DECKS	STORM SEWER SIZE, LOCATION
NO. OF STAIRS	STORM SEWER SIZE, LOCATION
NO. OF ELEVATORS	STORM SEWER SIZE, LOCATION
NO. OF HALLS	STORM SEWER SIZE, LOCATION
NO. OF CLOSETS	STORM SEWER SIZE, LOCATION
NO. OF BUILT IN APPLIANCES	STORM SEWER SIZE, LOCATION
NO. OF OTHER FEATURES	STORM SEWER SIZE, LOCATION

DESIGN CERTIFICATION
THIS PLAN WAS PREPARED BY ME, AND IS CORRECT
TO THE BEST OF MY KNOWLEDGE AND BELIEF.
NAME: [Signature]
SURVEYOR REGISTRATION NO. 54343

REMARKS
ALL BOUNDARY DATA SHOWN WAS OBTAINED FROM IDEEDS, RECORDED
SUBDIVISION PLAT OR OTHER PUBLIC RECORDS
LOCATIONS AS SHOWN OF ADJACENT WELLS AND SEPTIC TANKS OBTAINED FROM
LAKE COUNTY HEALTH DEPARTMENT

LEGEND	
WATER VALVE (GAS)	WATER METER (GAS)
AS BUILT ELEVATION	INDICATES DIRECTION OF SURFACE DRAINAGE
EXISTING CONTOURS	
PROPOSED CONTOURS	
EXIST. ELEV.	
PROJ. ELEV.	

HAUTHEALE LUGA SUB.	
SUBDIVISION	15-44
VOLUME	15-44
FILED NO.	15-44
FILED DATE	15-44
FILED BY	15-44
FILED AT	15-44

7/15/93 SITE PLAN
CONCEDED TWP., LAKE COUNTY, OHIO
FOR: COVETLAND BUILDERS
CLIENT: [Signature]
OWNER: [Signature]

Grading Plan Approved
as shown and/or noted
THOMAS P. GILLES, P.E.
Lake County Engineer
By: [Signature] Date: 2/19/93
15' CMP REQUIRED

OAKHURST AVENUE - 60'

S. J. LESSMAN
REGISTERED SURVEYOR
2/12/93
ZONING PERMIT
#0293-7323
ELEV. = 100.00
SUBJECT TO APPROVAL BY:
Lake County Sanitary Eng. [Signature]
Lake County Eng. Dept. [Signature]
Lake County Building Dept. [Signature]
APPROVED
NOTED
Name: [Signature] Reg. No. [Signature]