


SCALE 1"=20'

EXIST. EROSION
PROG. EROSION

NOTE: END OF
EXISTING DRIVE
CONSTRUCTION.

RAISED HOUSE FOUNDATION
R/S 7-24-84

RAILROAD
R/W 21' MIN.
ELEV. 778.20

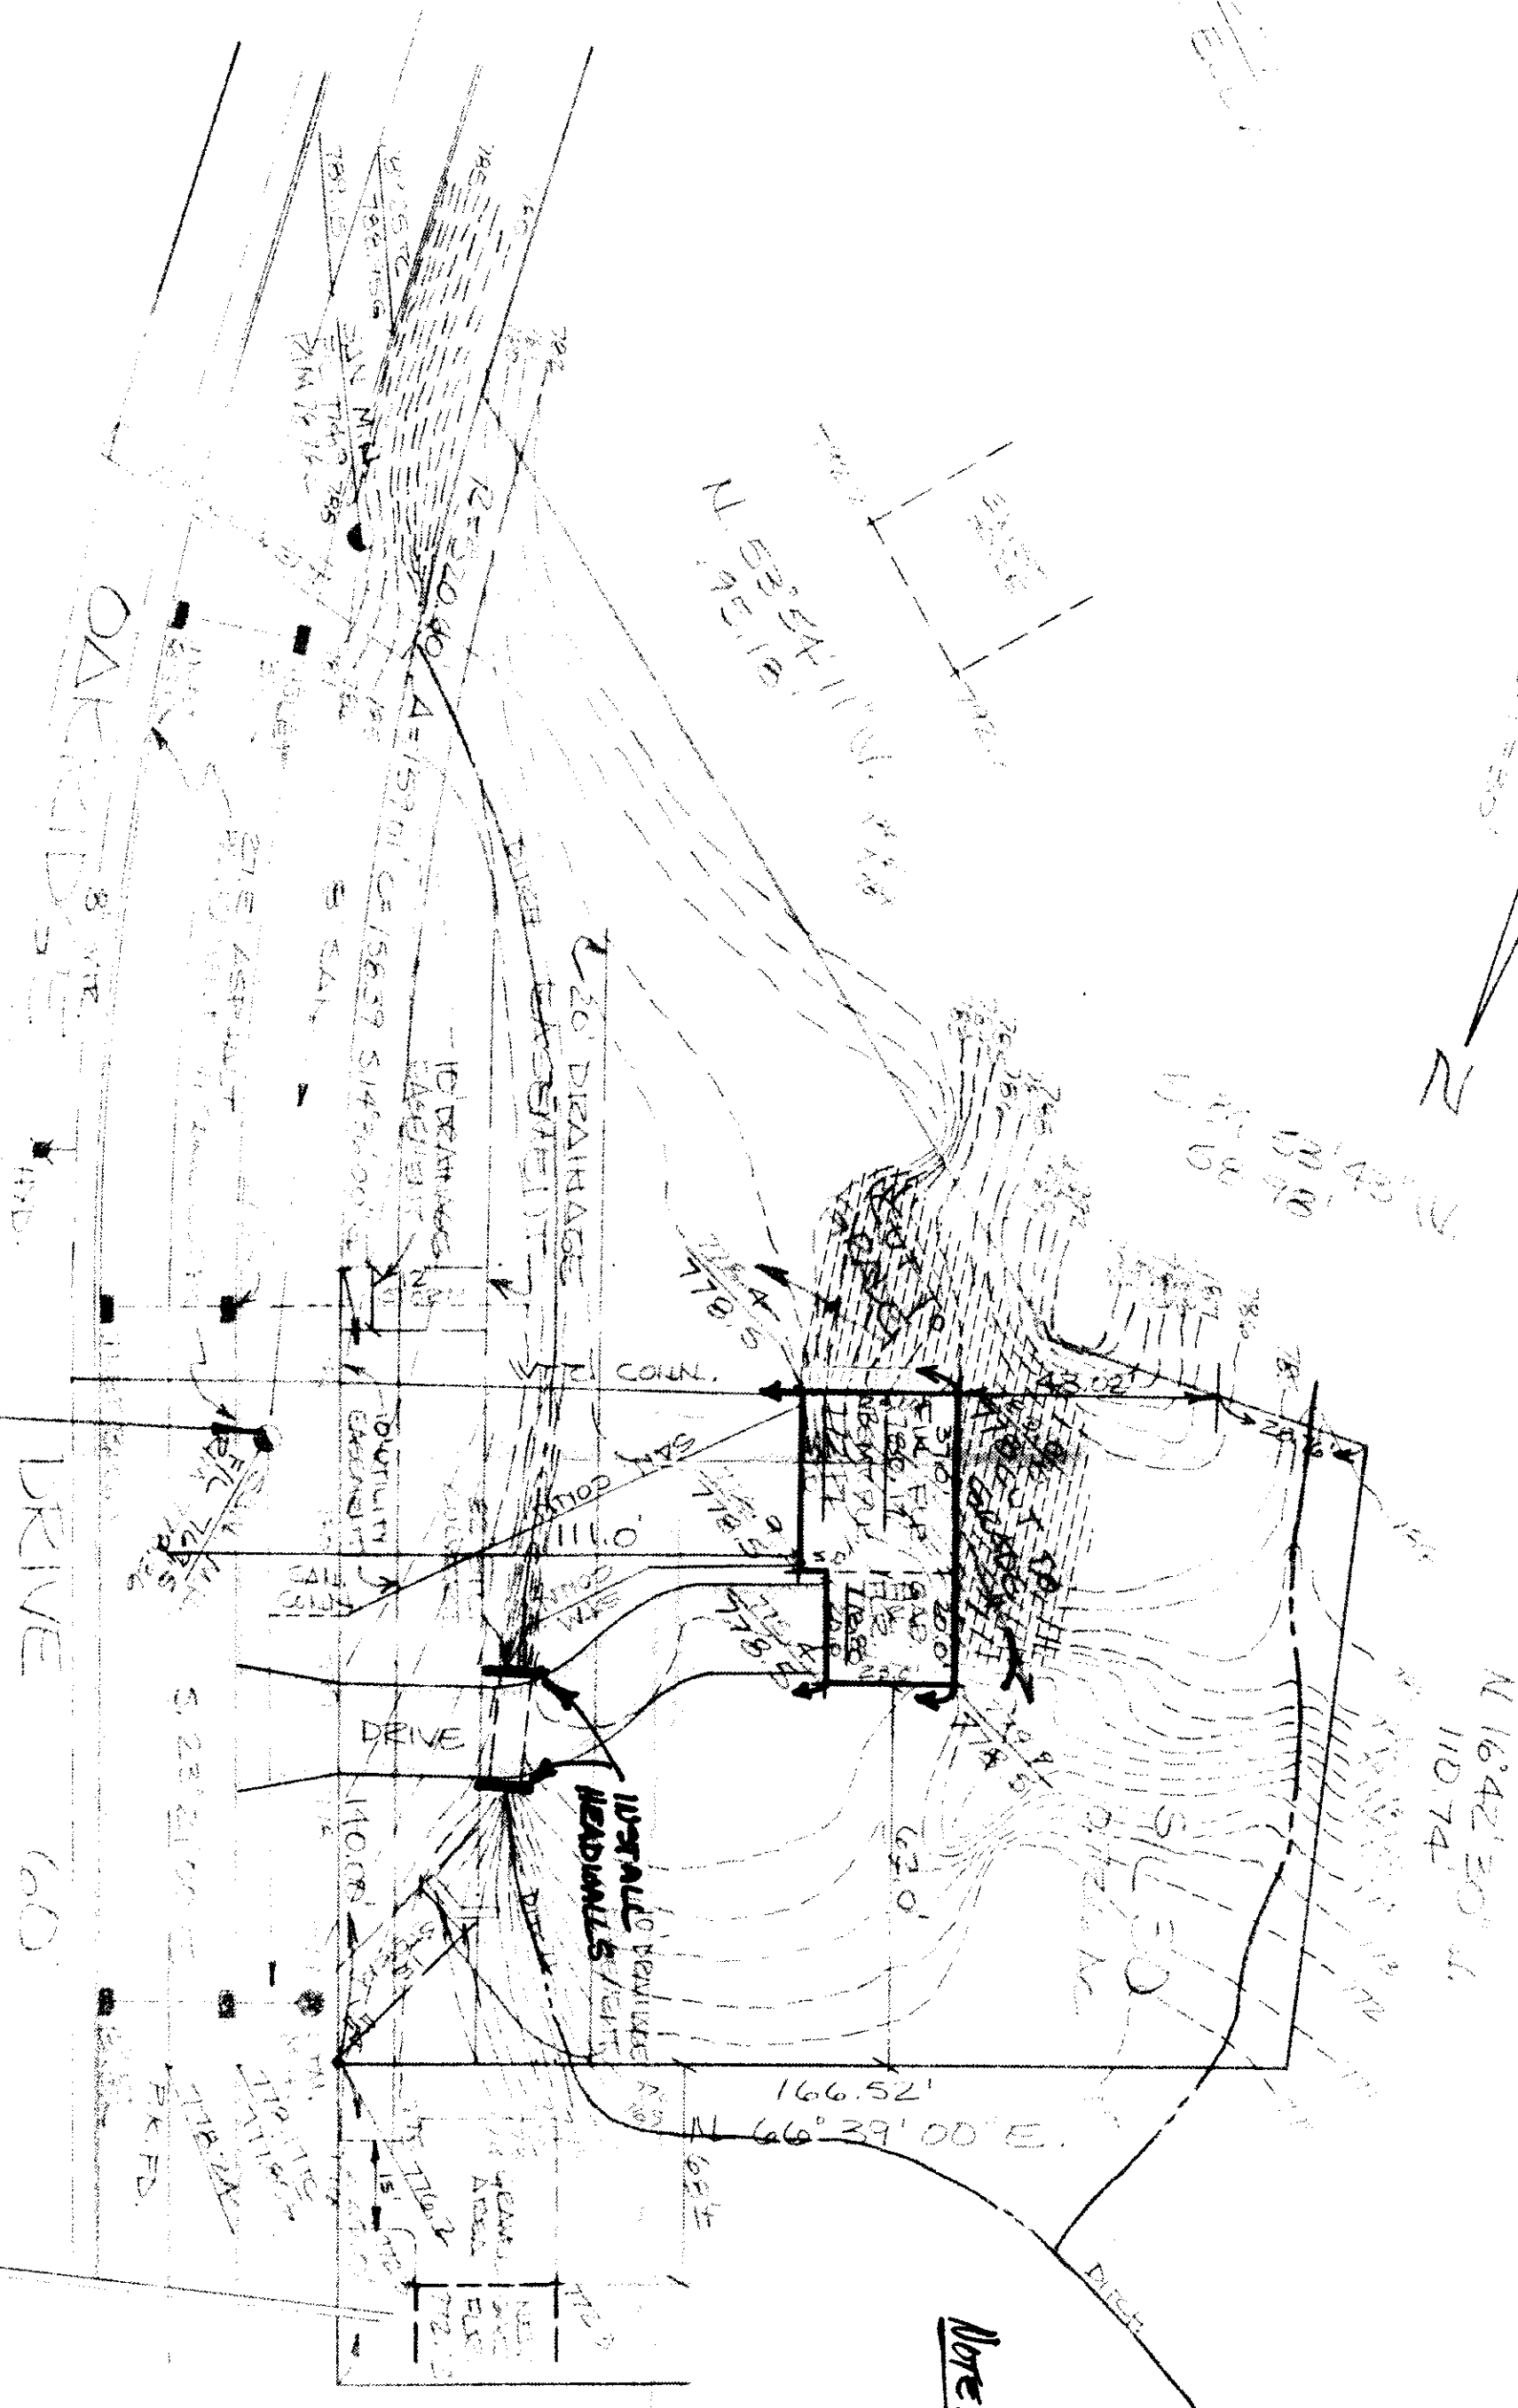


Note: Drive spouts to be directed
toward Oakridge Dr.

HOOSE ROAD

Grading Plan Approved
as shown and/or noted
THOMAS P. GILLES, P.E.
Lake County Engineer
By Tom J. Marano
Date 22 JUL 84

ZONING PERMIT #4889
ISSUED 7-22-84
SUBJECT TO APPROVAL BY:
Lake County Sanitary Eng. ☐
Lake County Eng. Dept. ☒
Lake County Planning Comm. ☐
Lake County Bldg. Dept. ☒
Tom J. Marano

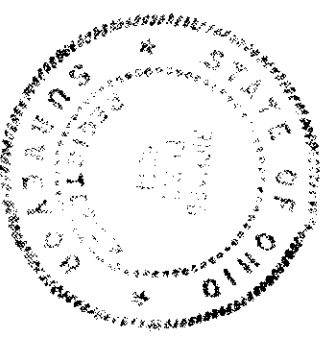

DESIGN CERTIFICATION
THIS PLAN WAS PREPARED BY ME
AND IS CORRECT TO THE BEST OF
MY KNOWLEDGE AND BELIEF.
Signature: Tom J. Marano
Date: 7-22-84

DATE 7-22-84		SCALE 1"=20'	
DRAWN BY <u>Tom J. Marano</u>		CHKD BY <u>Tom J. Marano</u>	
F&E NO. <u>5244</u>		SHEET 1 OF 1	
CONTRACT NO. <u>84-165</u>		CONTRACT NO. <u>84-165</u>	
COLPETZER WOODS CONSULTANTS, INC. MENTOR, OHIO 44060			