

SITE PLAN FOR:

RYAN HOMES
23600 MERCANTILE RD.
BEACHWOOD, OHIO

BEING SUBLT No. 67 IN THE MORLEY HILLS
ESTATES SUBDIVISION No. 2 LOCATED IN CONCORD TWP.,
OHIO.

PREPARED BY:



WM. R. GRAY ASSOC. INC.
7547 MENTOR AVE.
MENTOR, OHIO

DATE: MAY 14, 1975 SCALE: 1" = 20'
REV'D: MAY 29, 1975
REVISED: DEC. 14, 1975



CERTIFICATION:

I HEREBY CERTIFY THAT THIS PLAN
IS CORRECT TO THE BEST OF MY KNOWLEDGE.

By: Donald O. Brewster
WM. R. GRAY REG. SURV. # 27
OR DONALD O. BREWSTER R.S. 5273

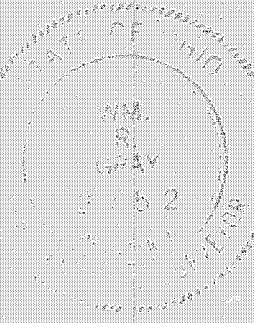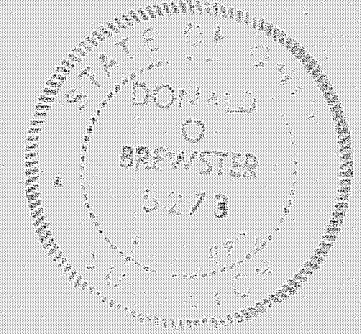

X 700.0 EXIST ELEVATIONS
X 700.0 PROPOSED ELEVATIONS
X 700.0 AS-BUILT ELEVATIONS

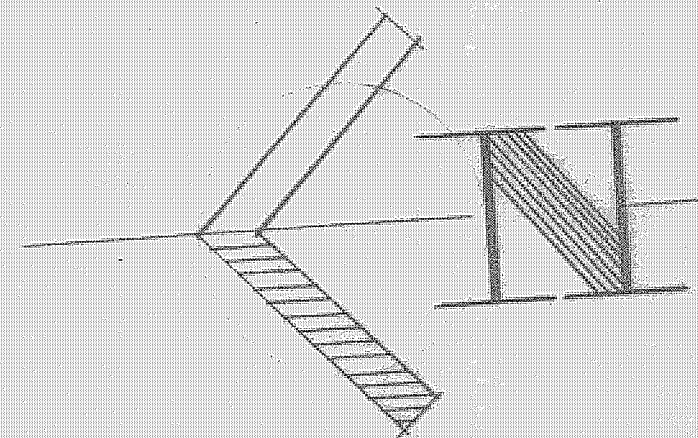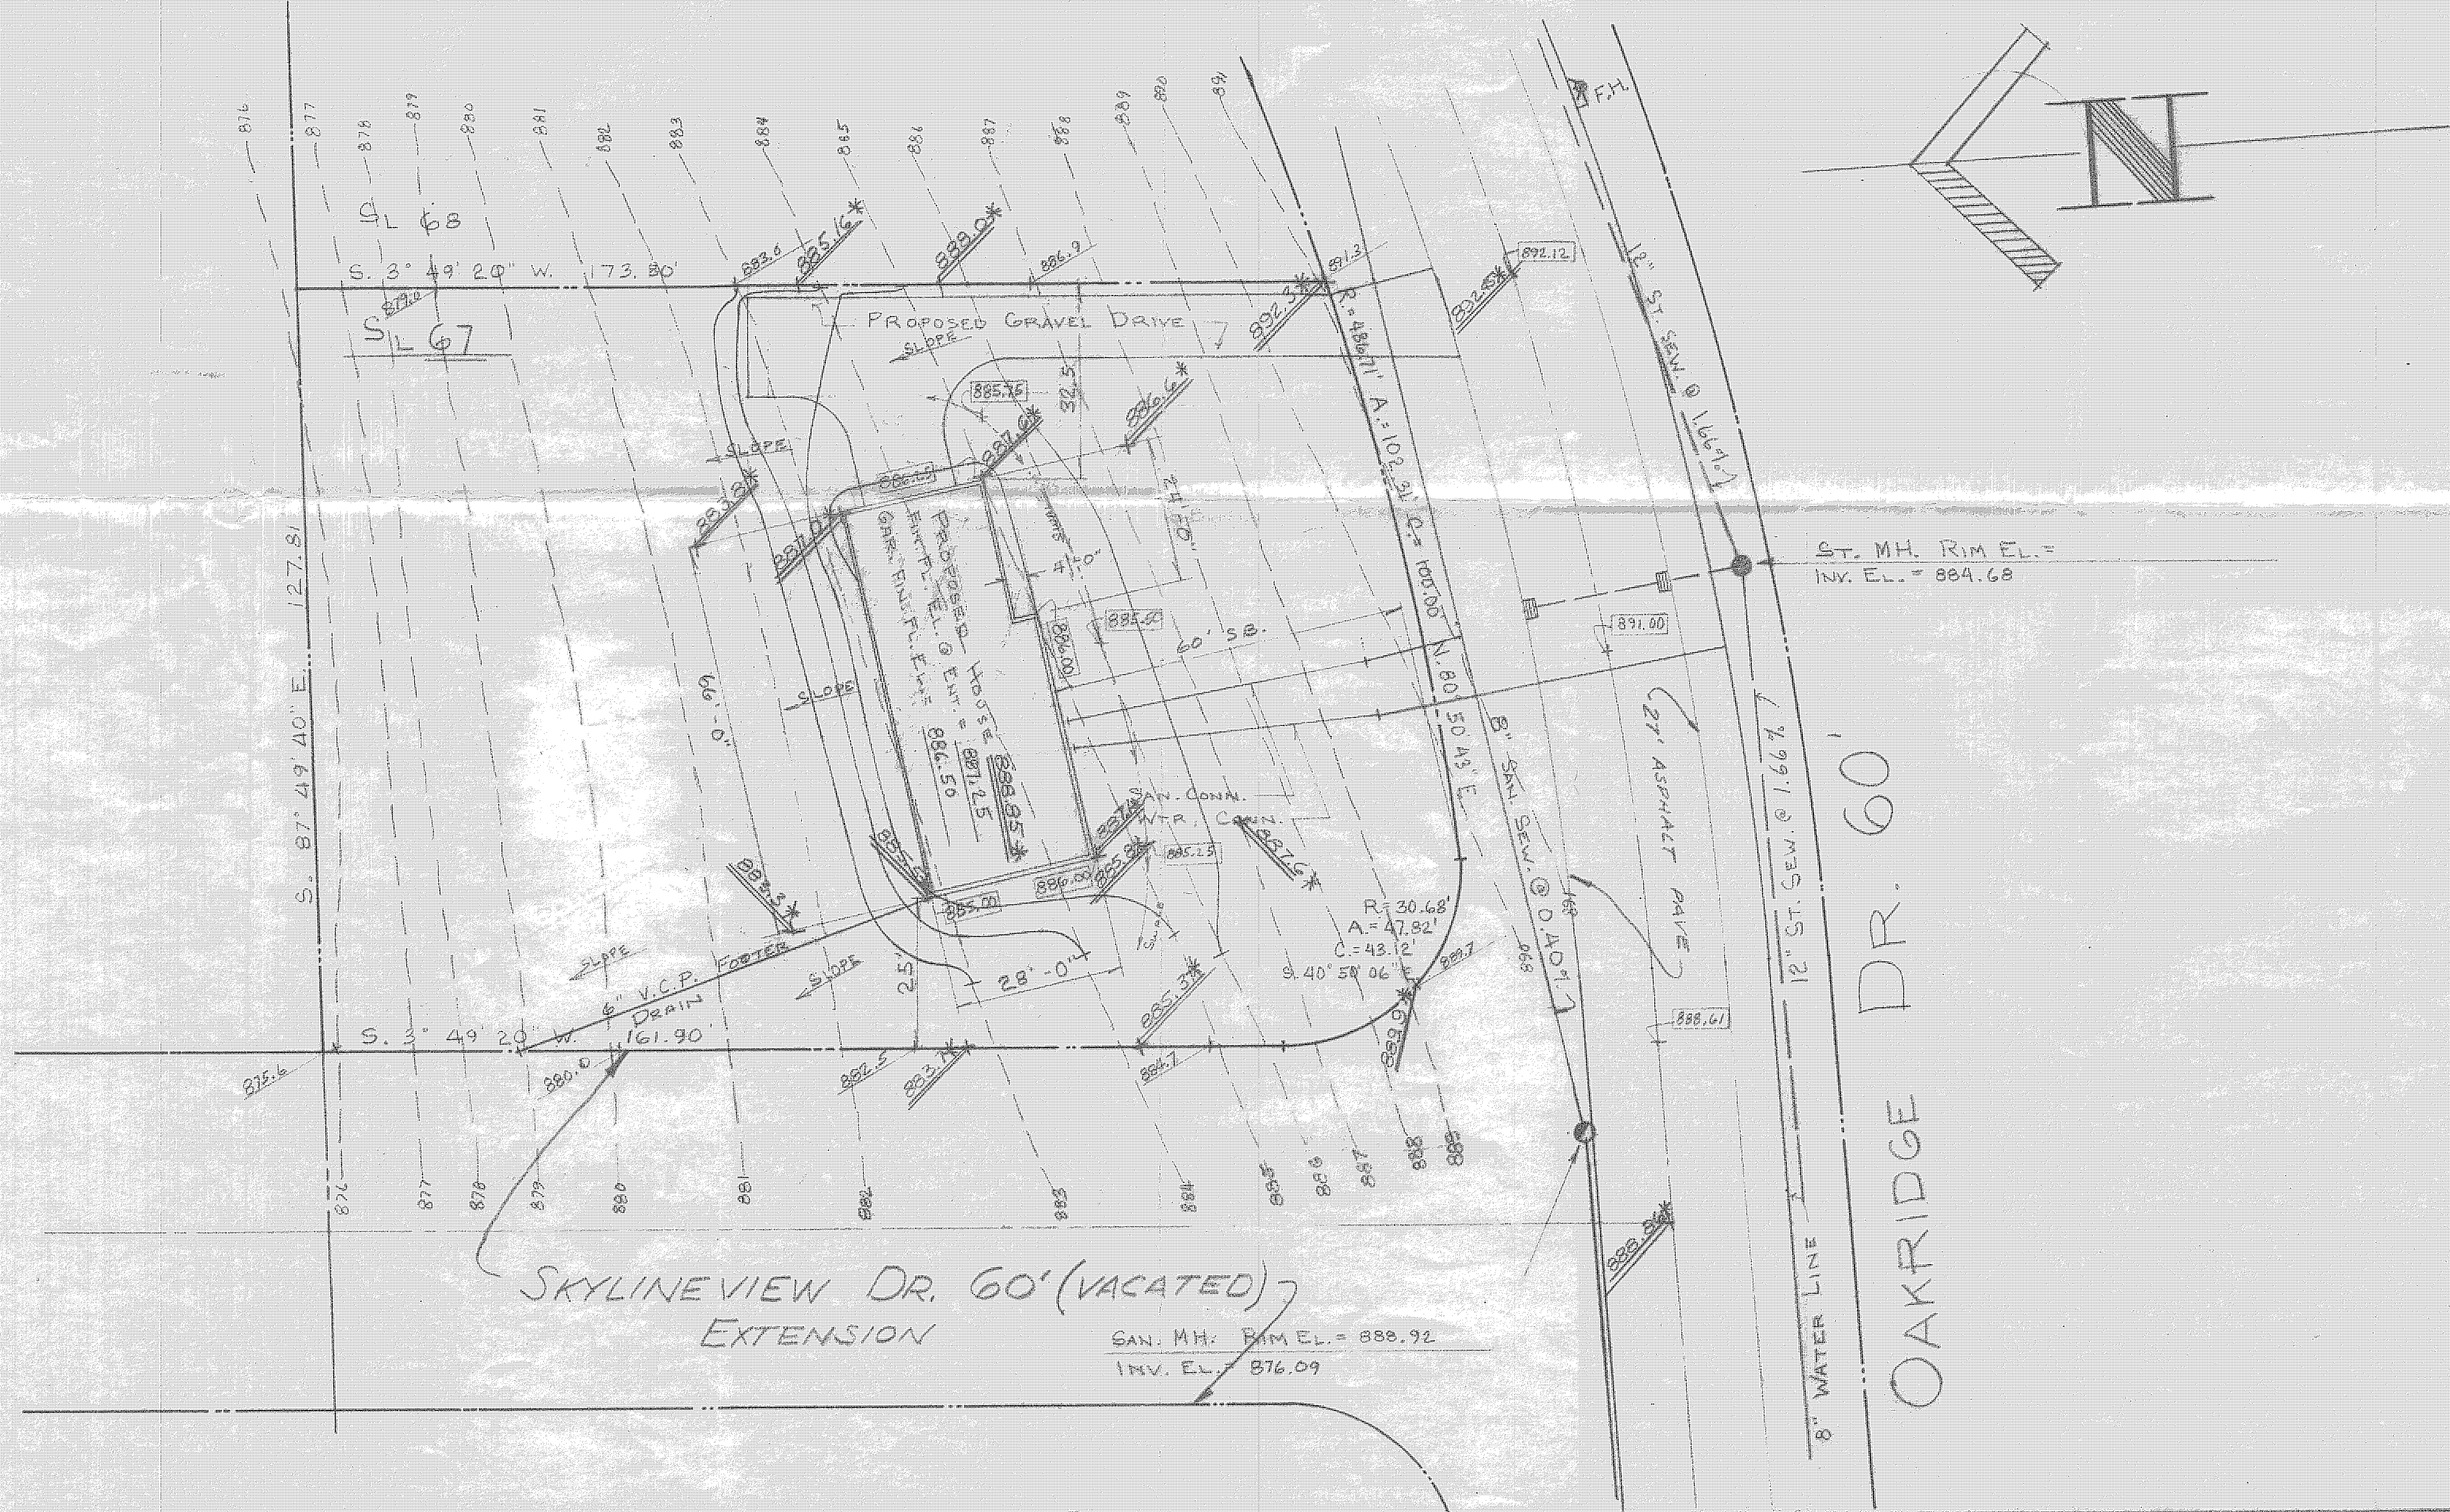

ST. MH. RIM EL. =
INV. EL. = 884.68

SKYLINEVIEW DR. 60' (VACATED)
EXTENSION

SAN. MH. RIM EL. = 880.92
INV. EL. = 876.09

12" ST. SEW. @ 1.66%

OAKRIDGE DR. 60'

8" WATER LINE