

SITE PLAN FOR GEORGE HUSS


HACH DEVELOPMENT CORP.
VOL. 841-R-634

EAST
PRD.

**ZONING PERMIT
ISSUED 9-19-86
#5362**

SUBJECT TO APPROVAL BY:
☐ Lake County Sanitary Eng.
☒ Lake County Planning Comm.
☒ Lake County Bldg. Dept.

Low 1. Maximum

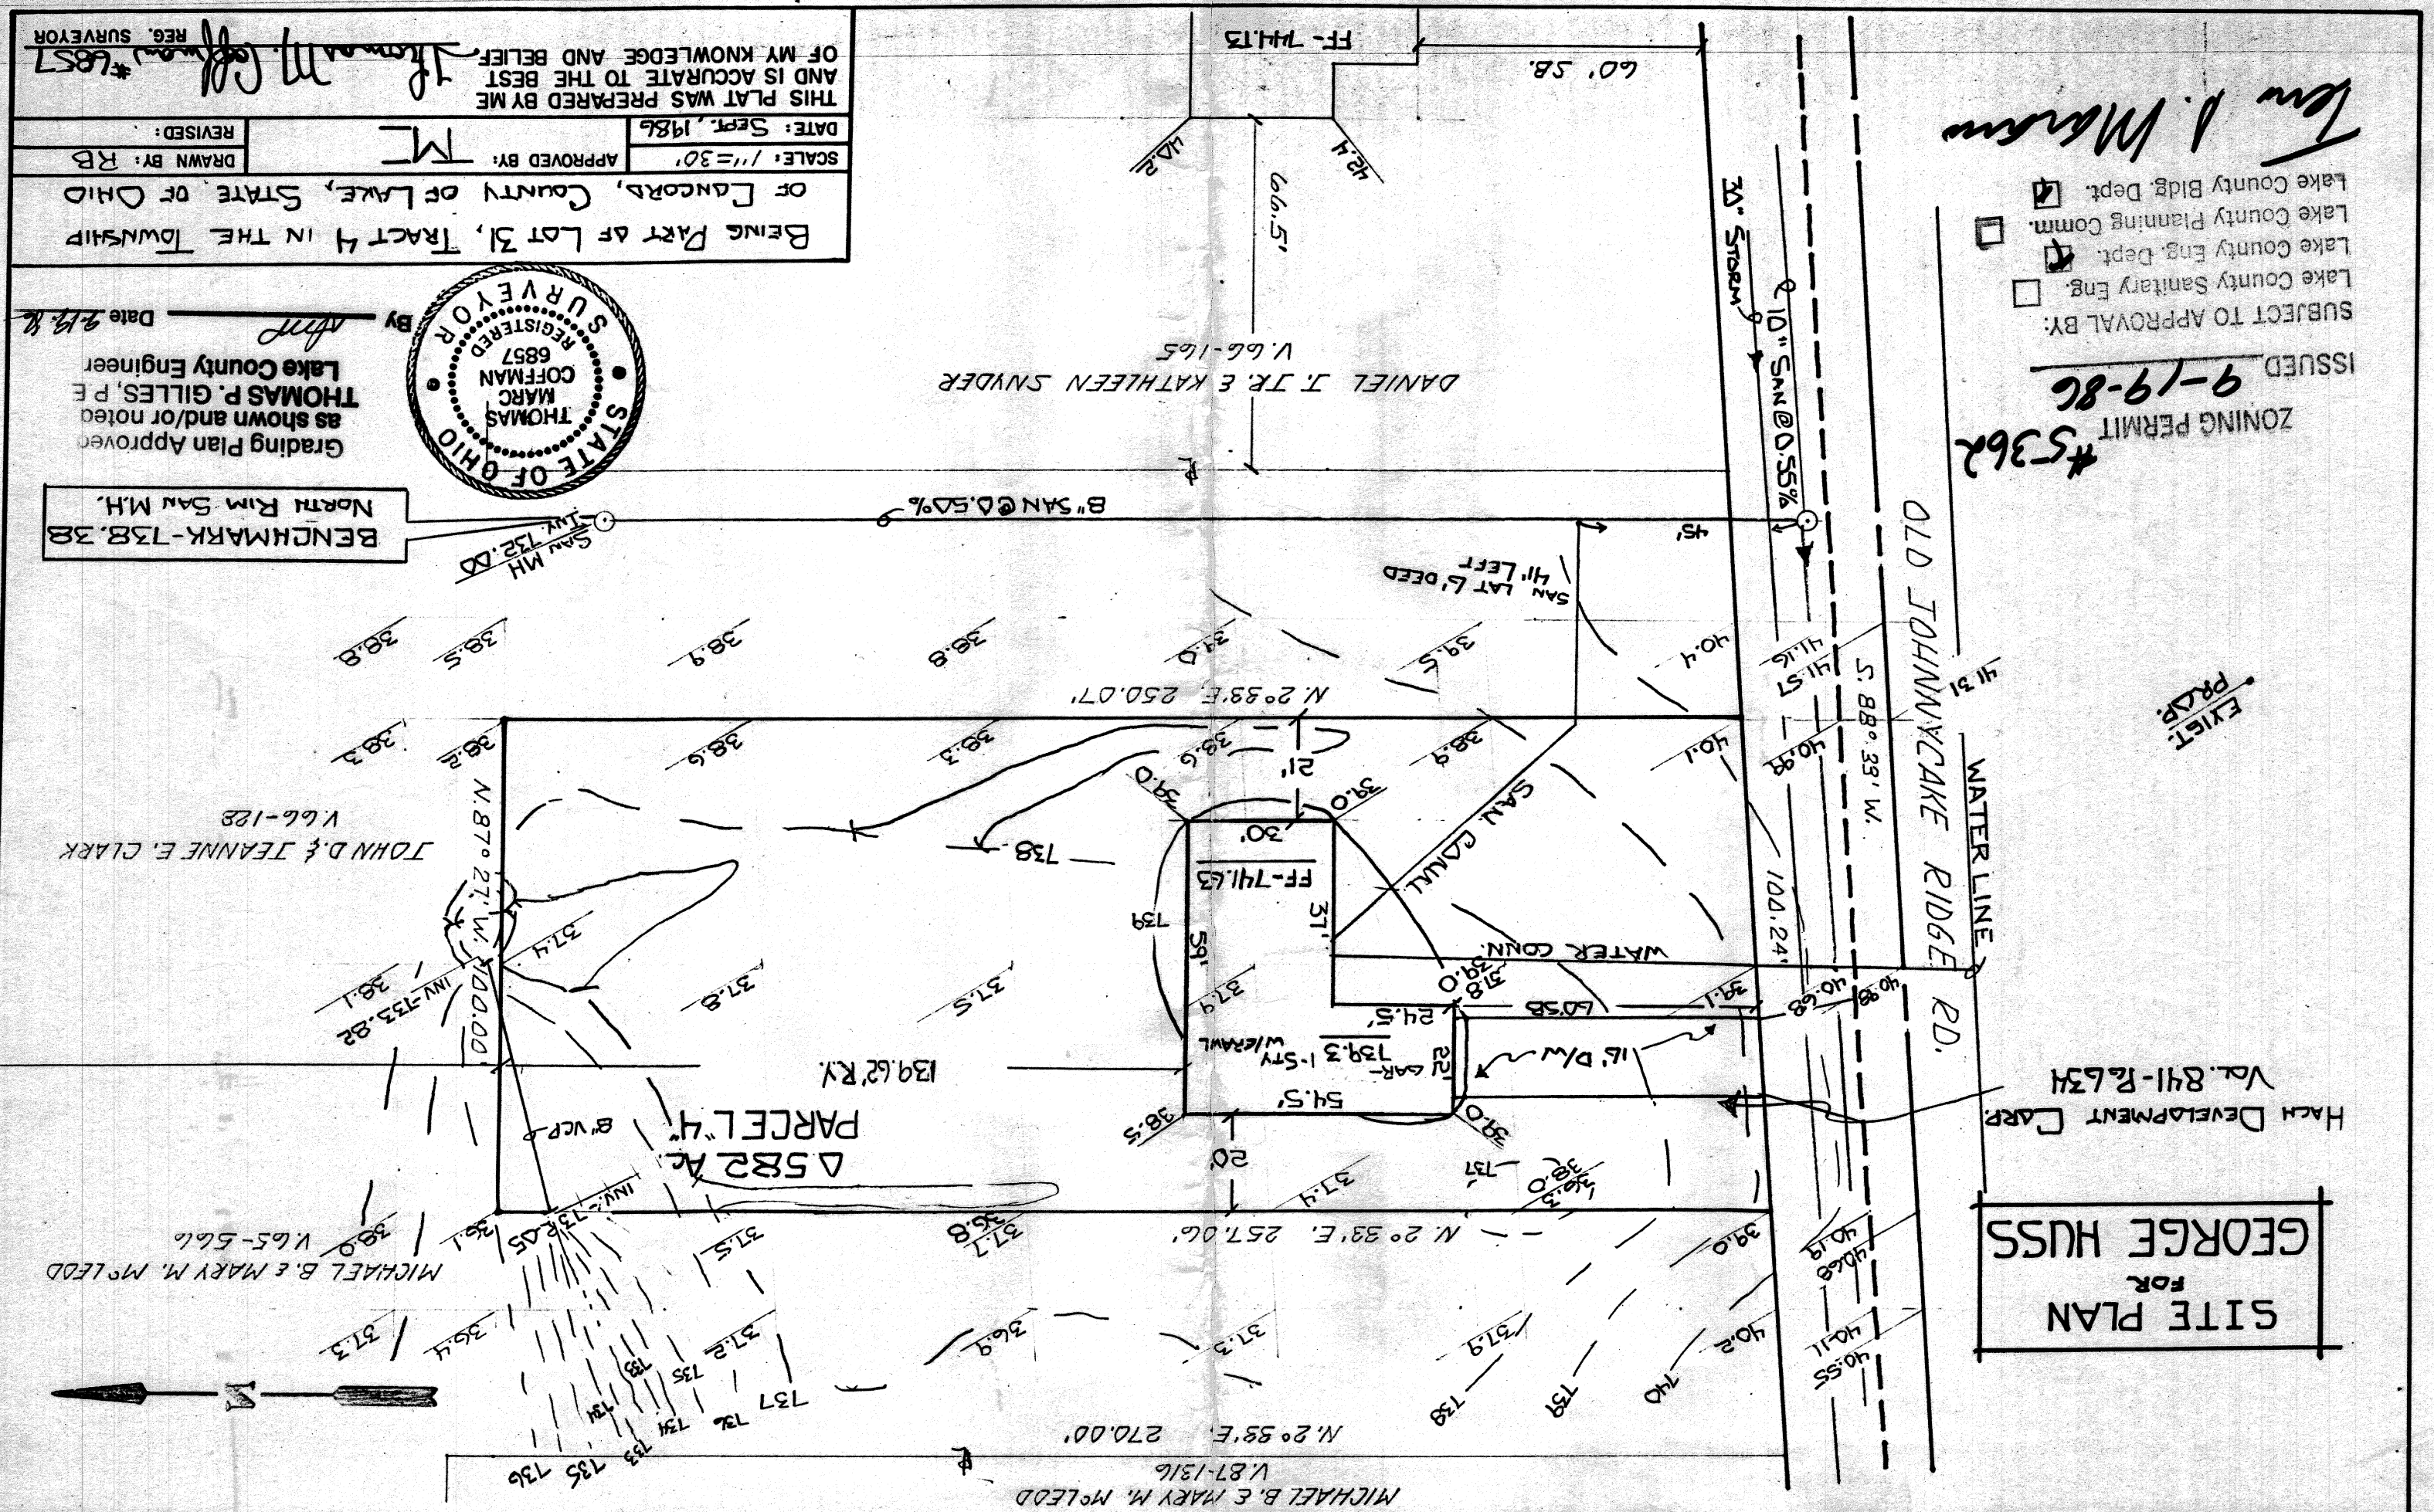


BEING PART OF LOT 31, TRACT 4 IN THE TOWNSHIP
OF LANGCORS, COUNTY OF LAKE, STATE OF OHIO

DATE: Sept. 1986
SCALE: 1"=30'

APPROVED BY: *M*
DRAWN BY: RB
REVISED:

THIS PLAT WAS PREPARED BY ME
AND IS ACCURATE TO THE BEST
OF MY KNOWLEDGE AND BELIEF

REG. SURVEYOR
#6857

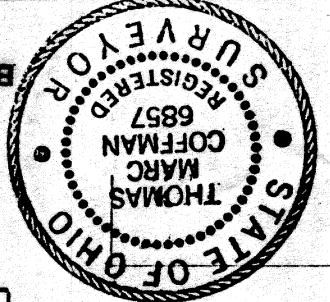

Grading Plan Approved
as shown and/or noted
THOMAS P. GILLES, P.E.
Lake County Engineer

By *TPG*
Date 9-19-86

BENCHMARK-738.38
NORTH RIM SAN M.H.