


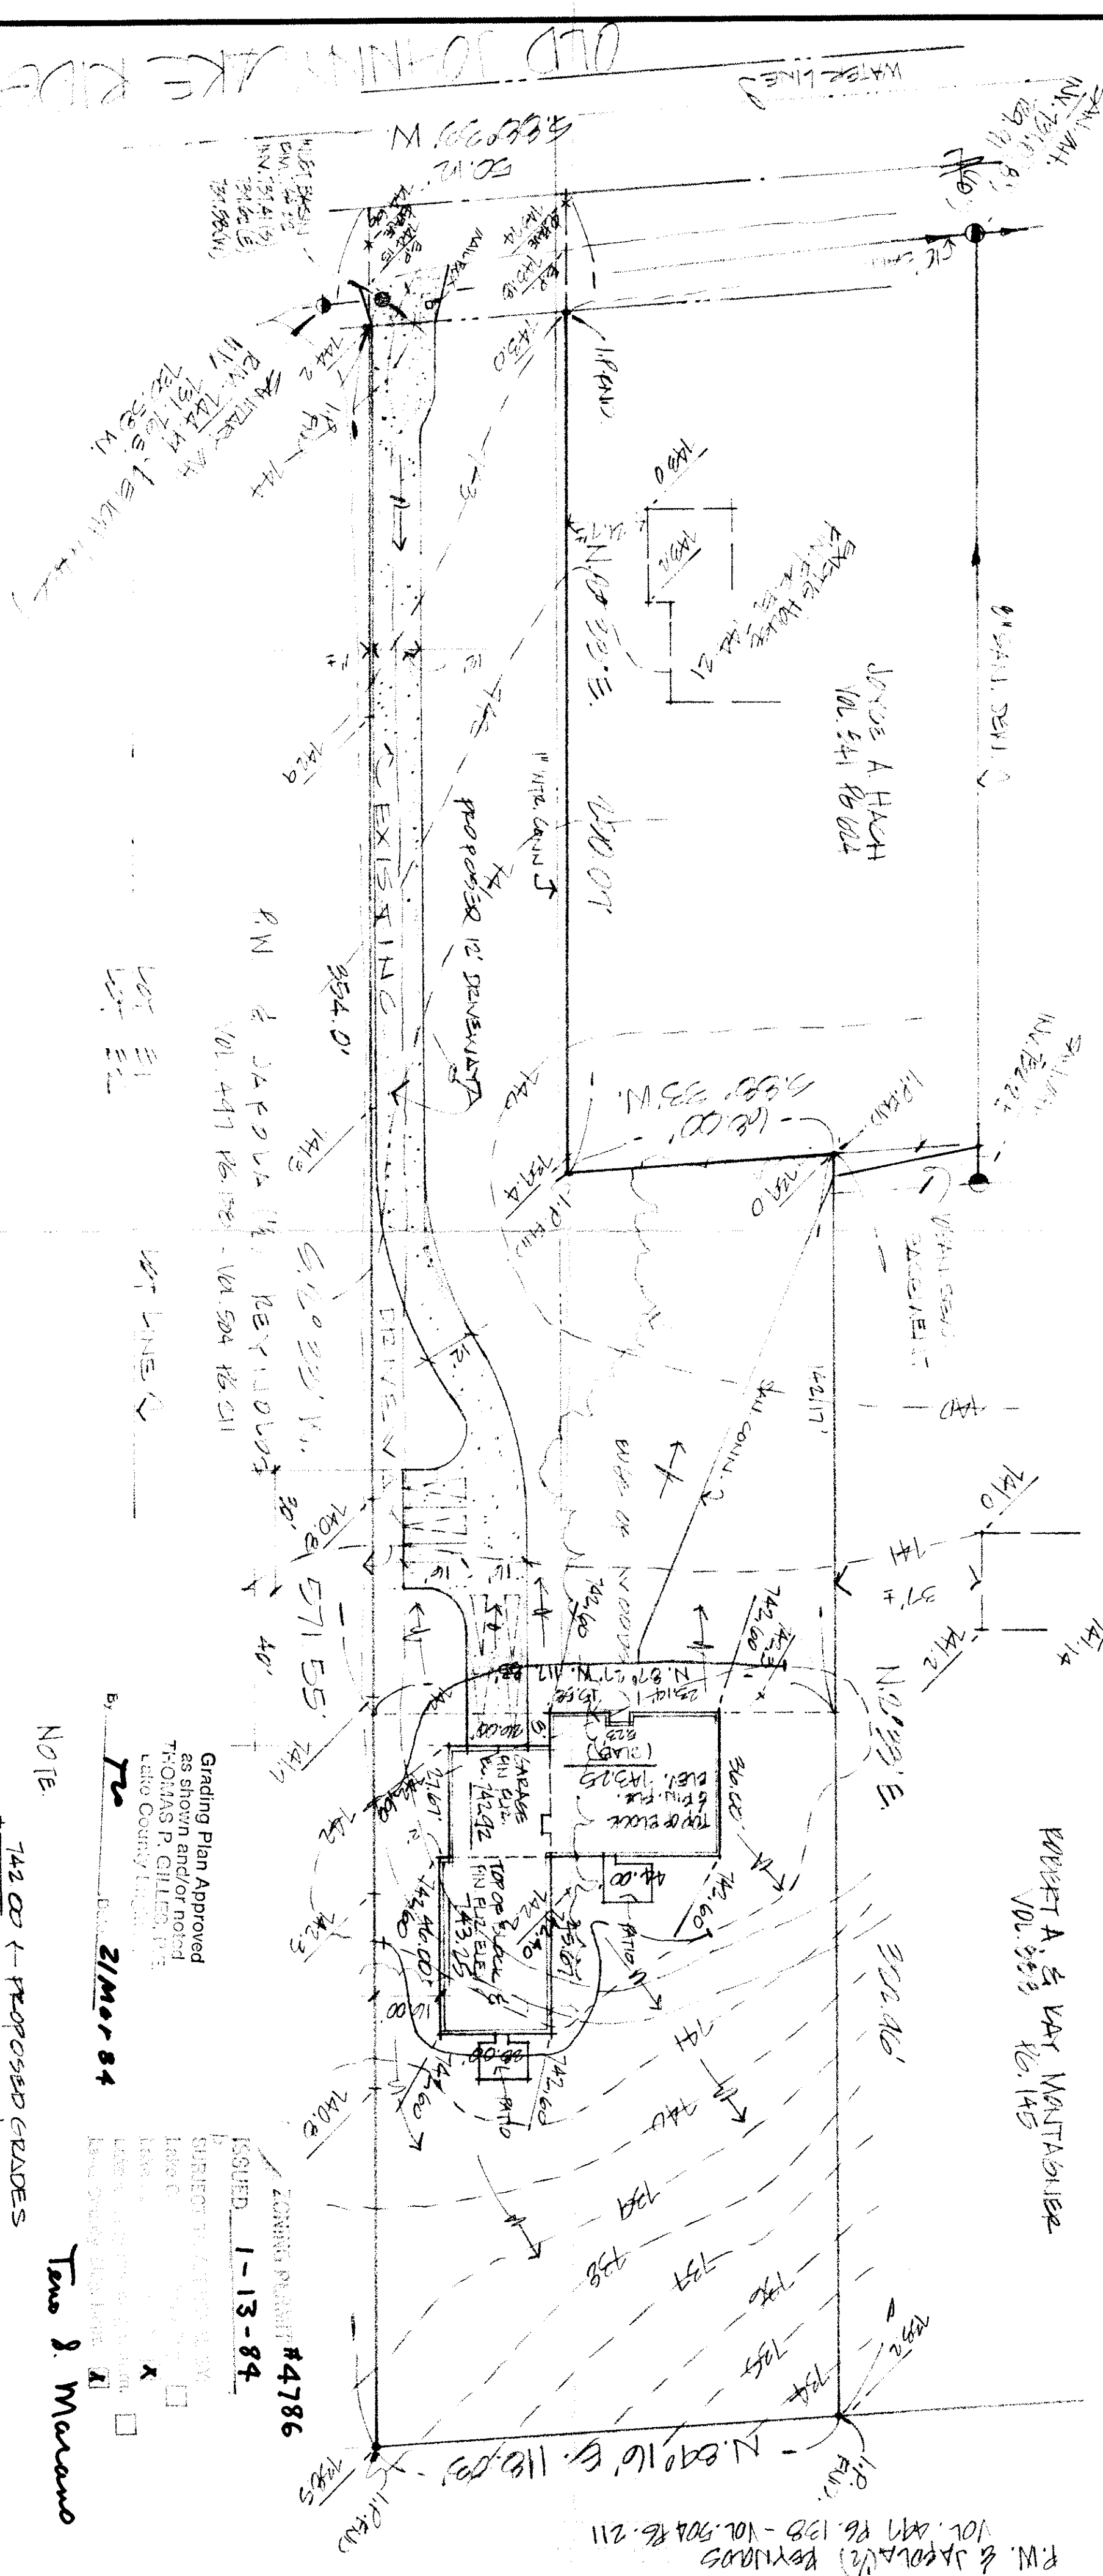

Tens 8. Marand

[illegible]

DEPT. OF LOT NO. 31, TRACT NO. 4 IN THE TOWNSHIP OF
COLUMBIA, LAKE COUNTY, OHIO.

LOT 20.31, EXACT NO. 4

DESIGN CERTIFICATION

THIS PLAT WAS PREPARED BY ME
AND IS CORRECT TO THE BEST OF
MY KNOWLEDGE AND BELIEF.

REG SURVEYOR NO 4785

DATE JAN. 9, 1984
SCALE 1"=30'
DRAWN BY L.D.P.
CHK'D BY
F.B.F. 4-19 PG. 34



MENTOR, OHIO 44060

CONTRACT NO.	1	1
SHEET	1	1