
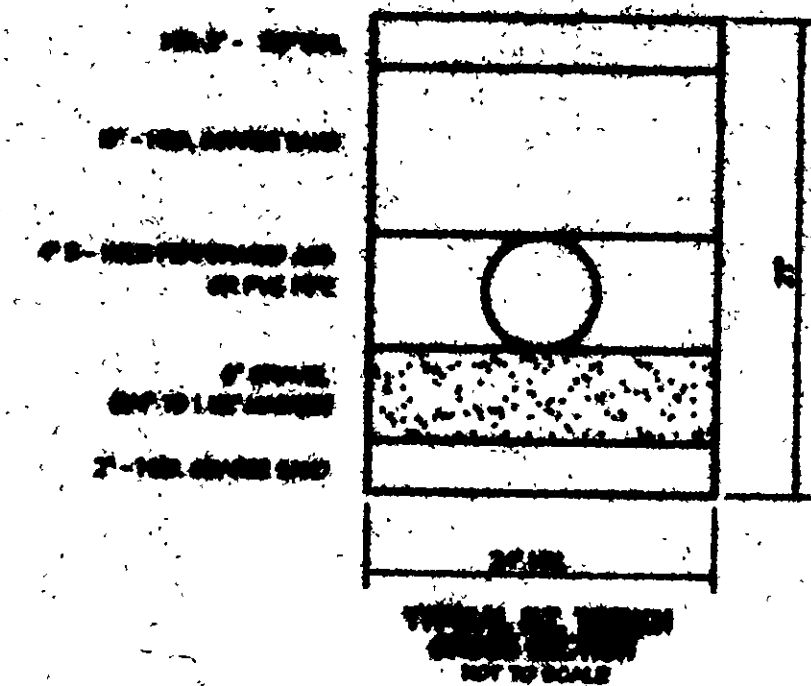


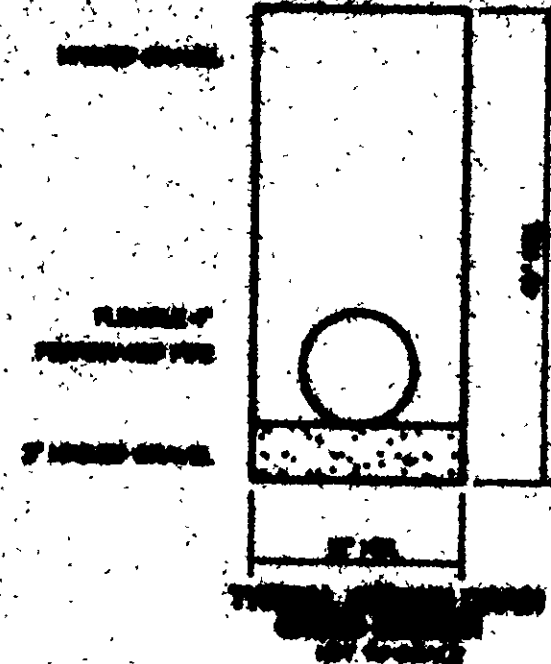


SITE PLAN

PROPERTY OF MR. & MRS. JAMES H. GILLESPIE
 1200 S. 10th Street, Concord, N.H.
 AS RECORDED IN VOL. 25, PAGE 12
 CONCORD TWP., LAKE COUNTY, N.H.

I, the undersigned, hereby certify that the
 information furnished herein is true and
 correct to the best of my knowledge and
 belief, and that I am not aware of any
 facts which would render the same
 misleading.




James H. Gillespie
 Owner

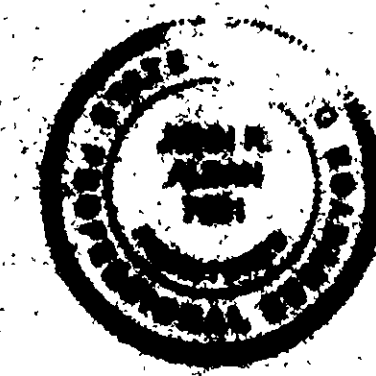

REVIEWED AND ACCEPTED
 LAKE COUNTY GENERAL
 HEALTH DISTRICT

Date: 5-19-98
David B. Jones
 Sanitary Engineer

SEWAGE DISPOSAL PERMIT MUST BE
 OBTAINED BY A LAKE COUNTY LICENSED
 INSTALLER BEFORE INSTALLATION
 STARTED.

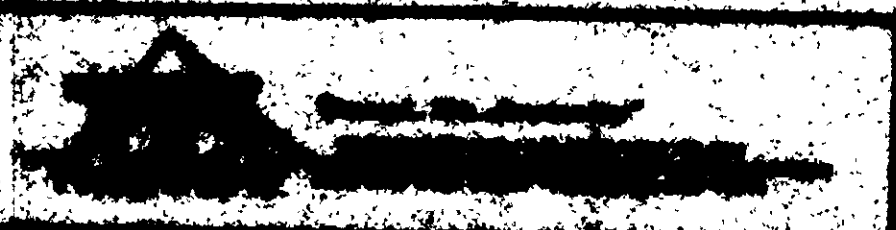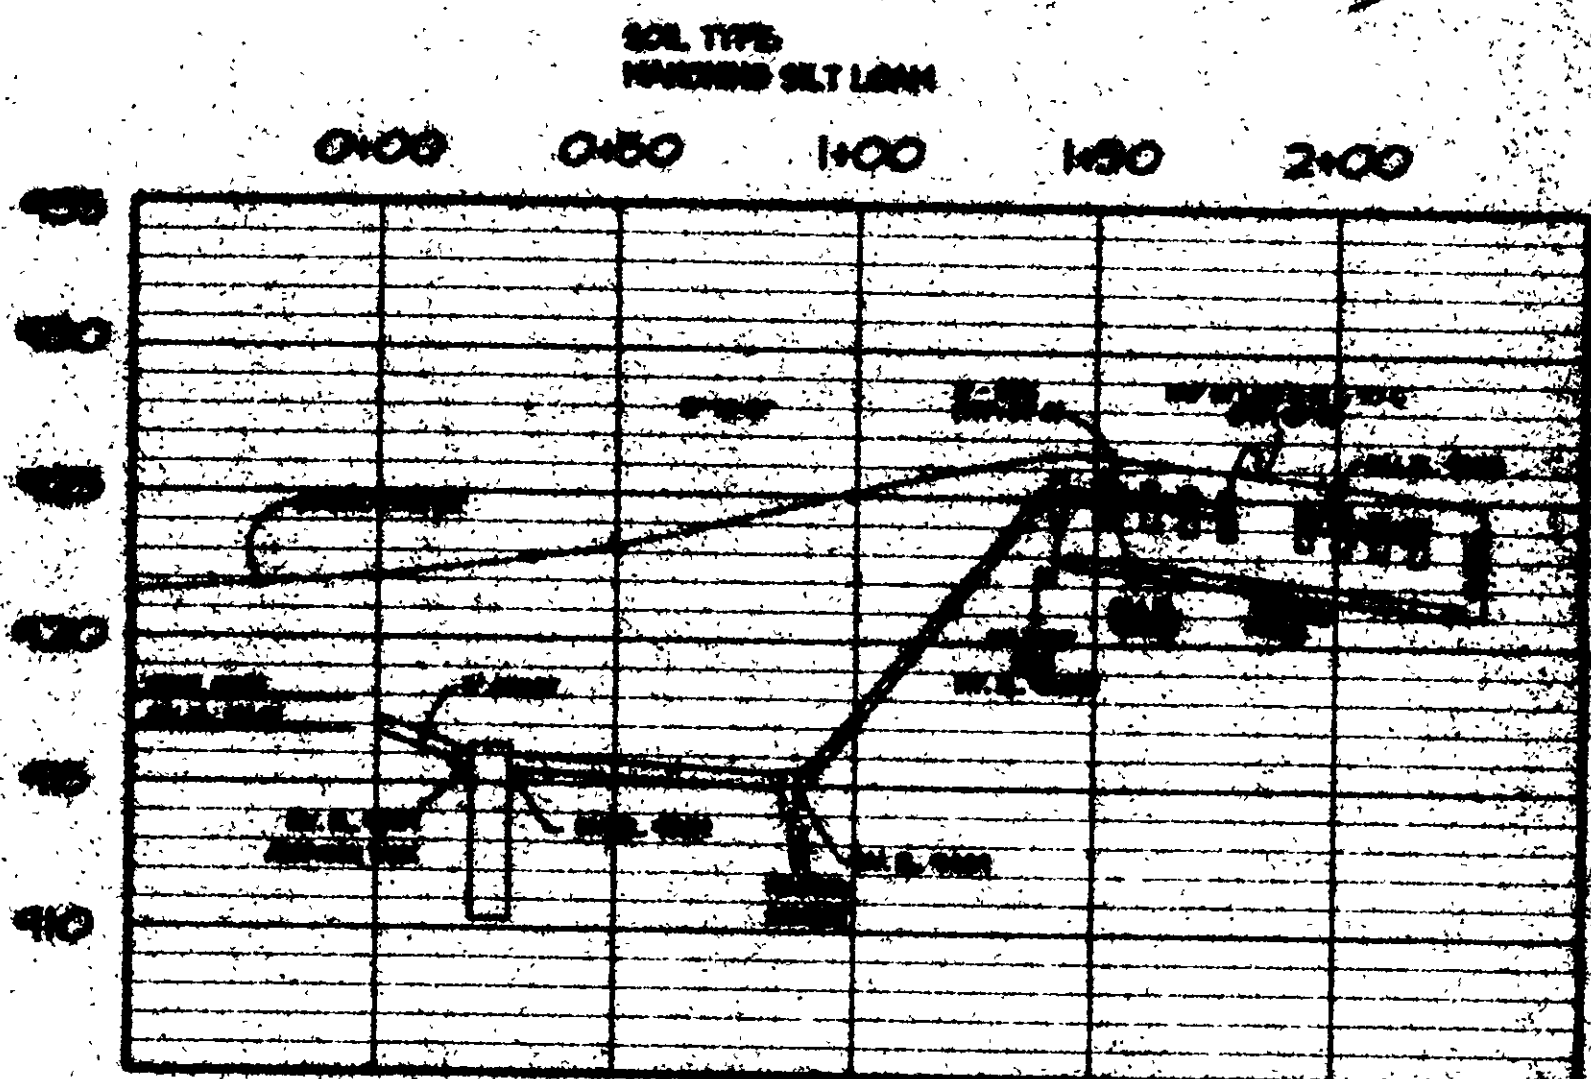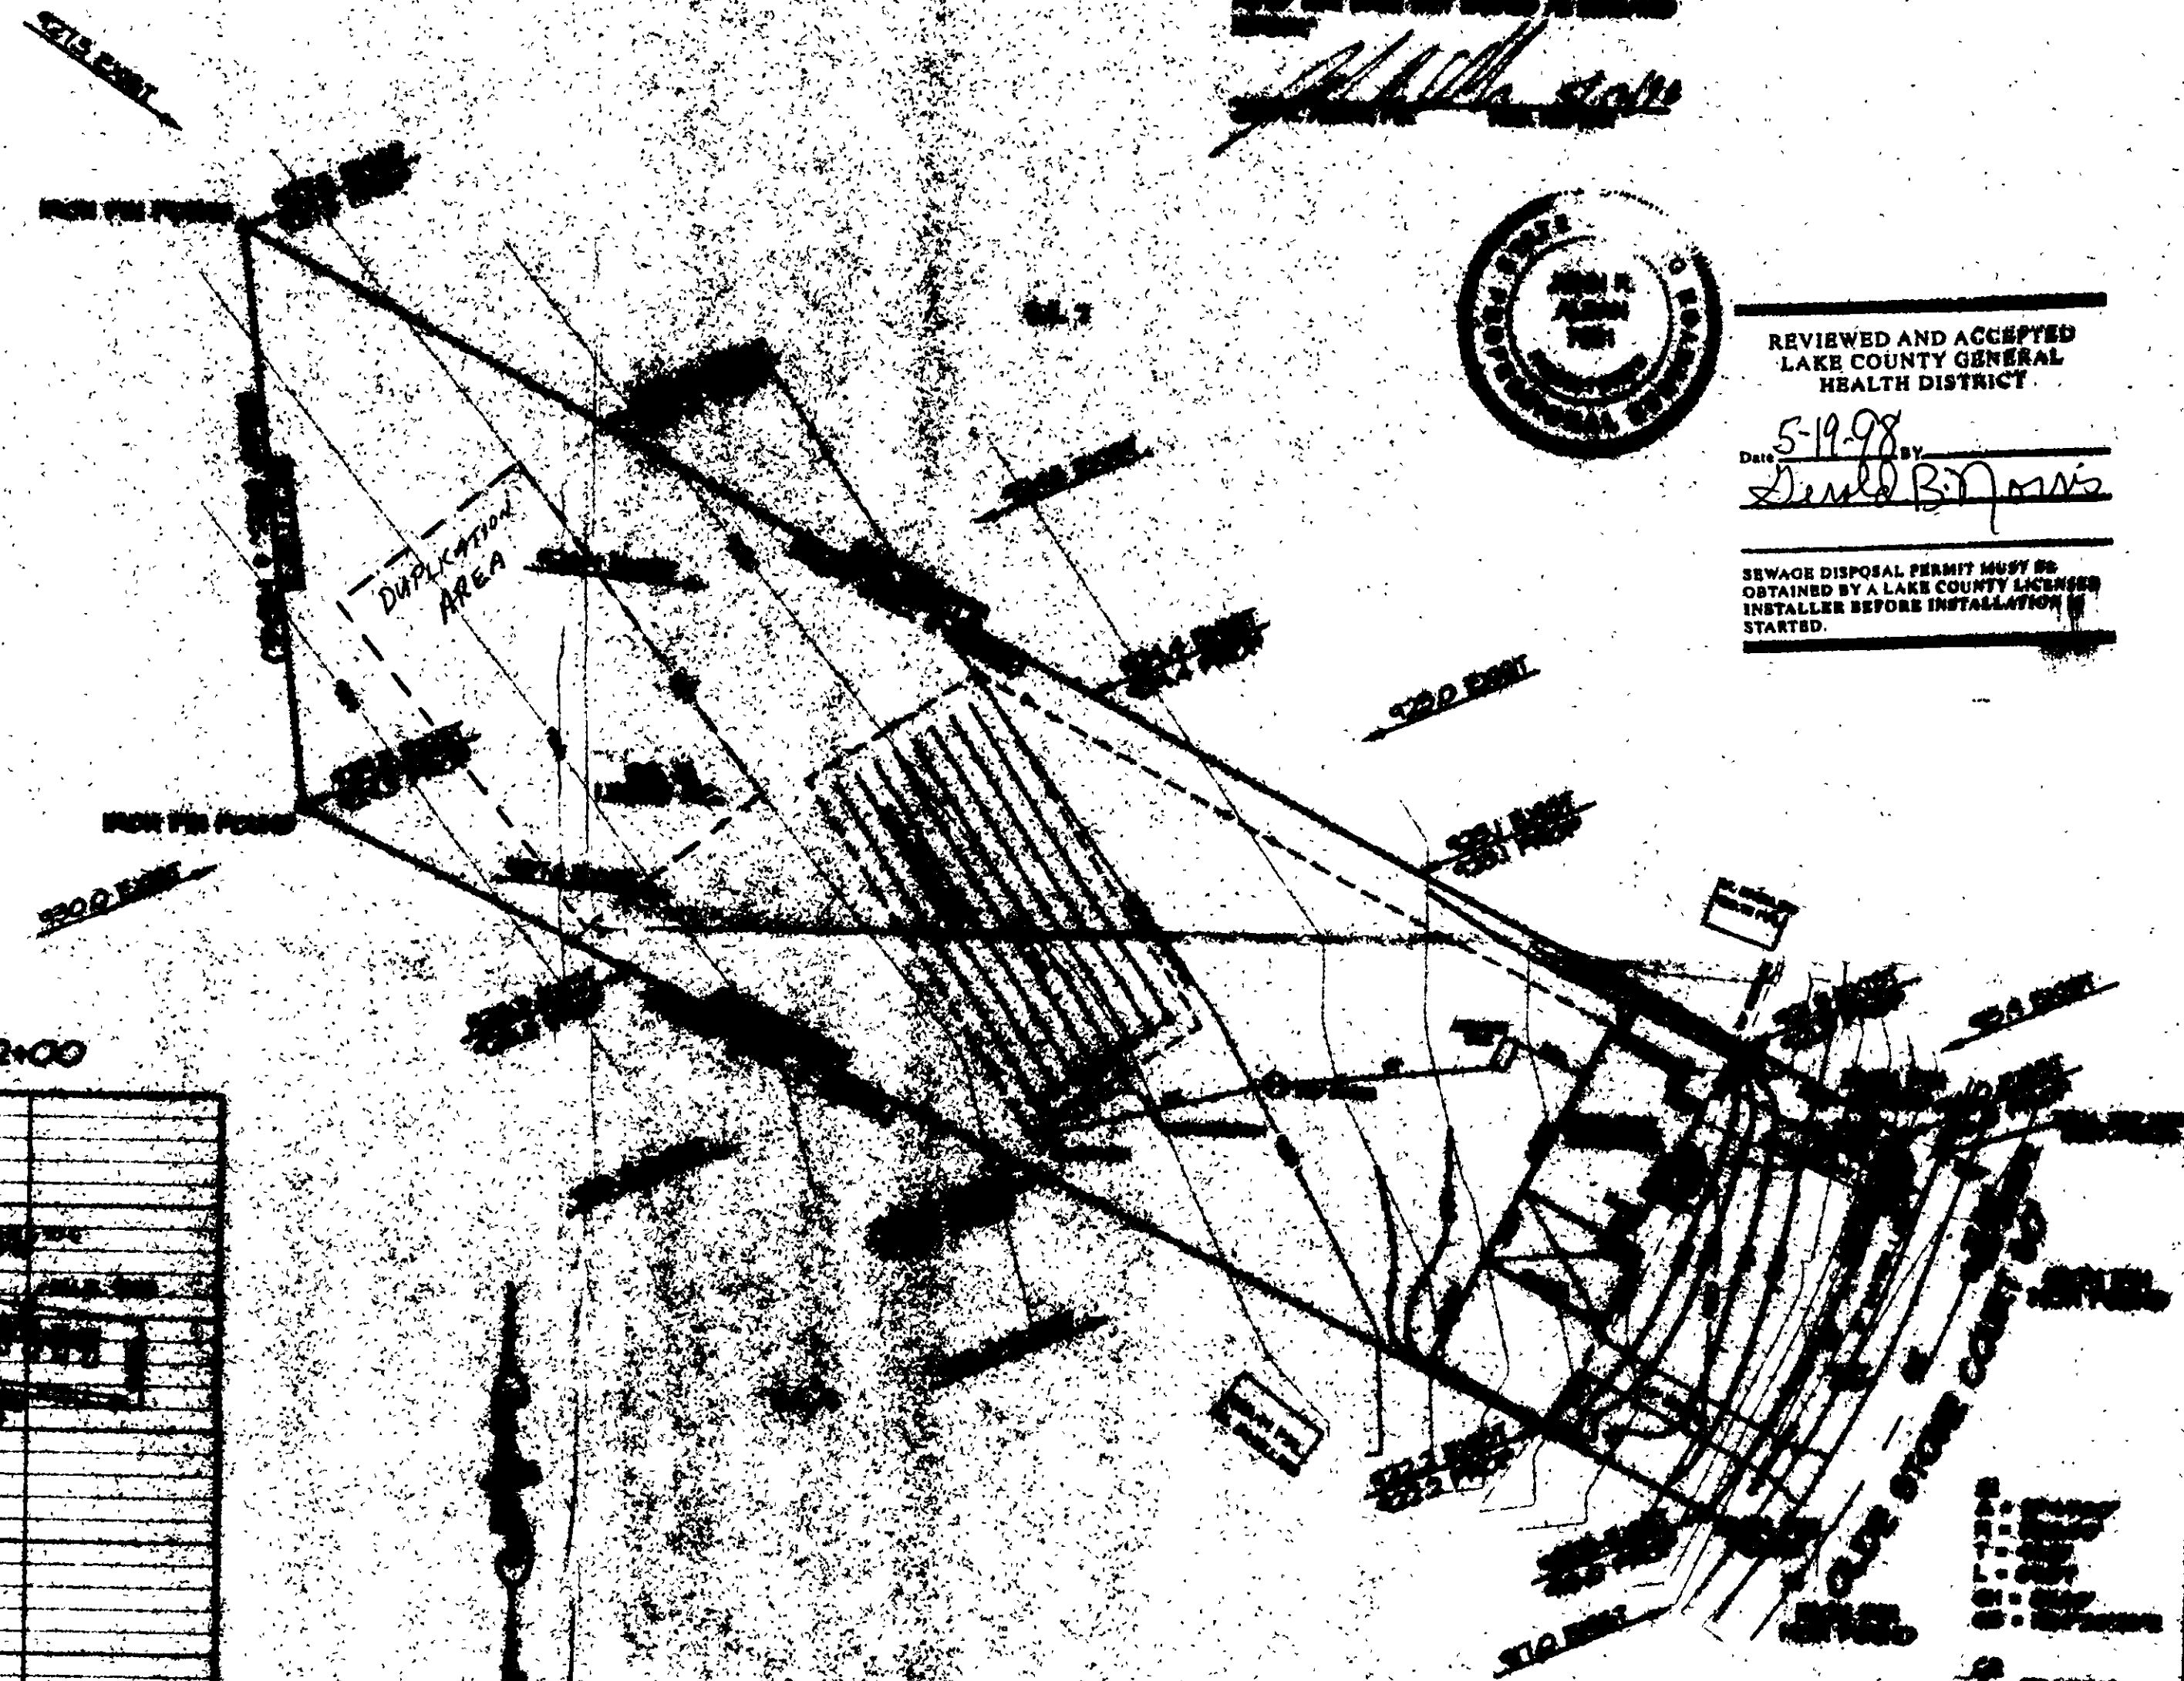

James H. Gillespie
 Owner

Grading Plan App.
 as shown and/or
 THOMAS P. GILLE
 Lake County Eng.

ZONING PERMIT #
 ISSUED 5/13/98

SUBJECT TO APPROVAL BY
 Lake County Sanitary Eng.
 Lake County Eng. Dept.
 Lake County Planning Com.
 Lake County Bldg. Dept.