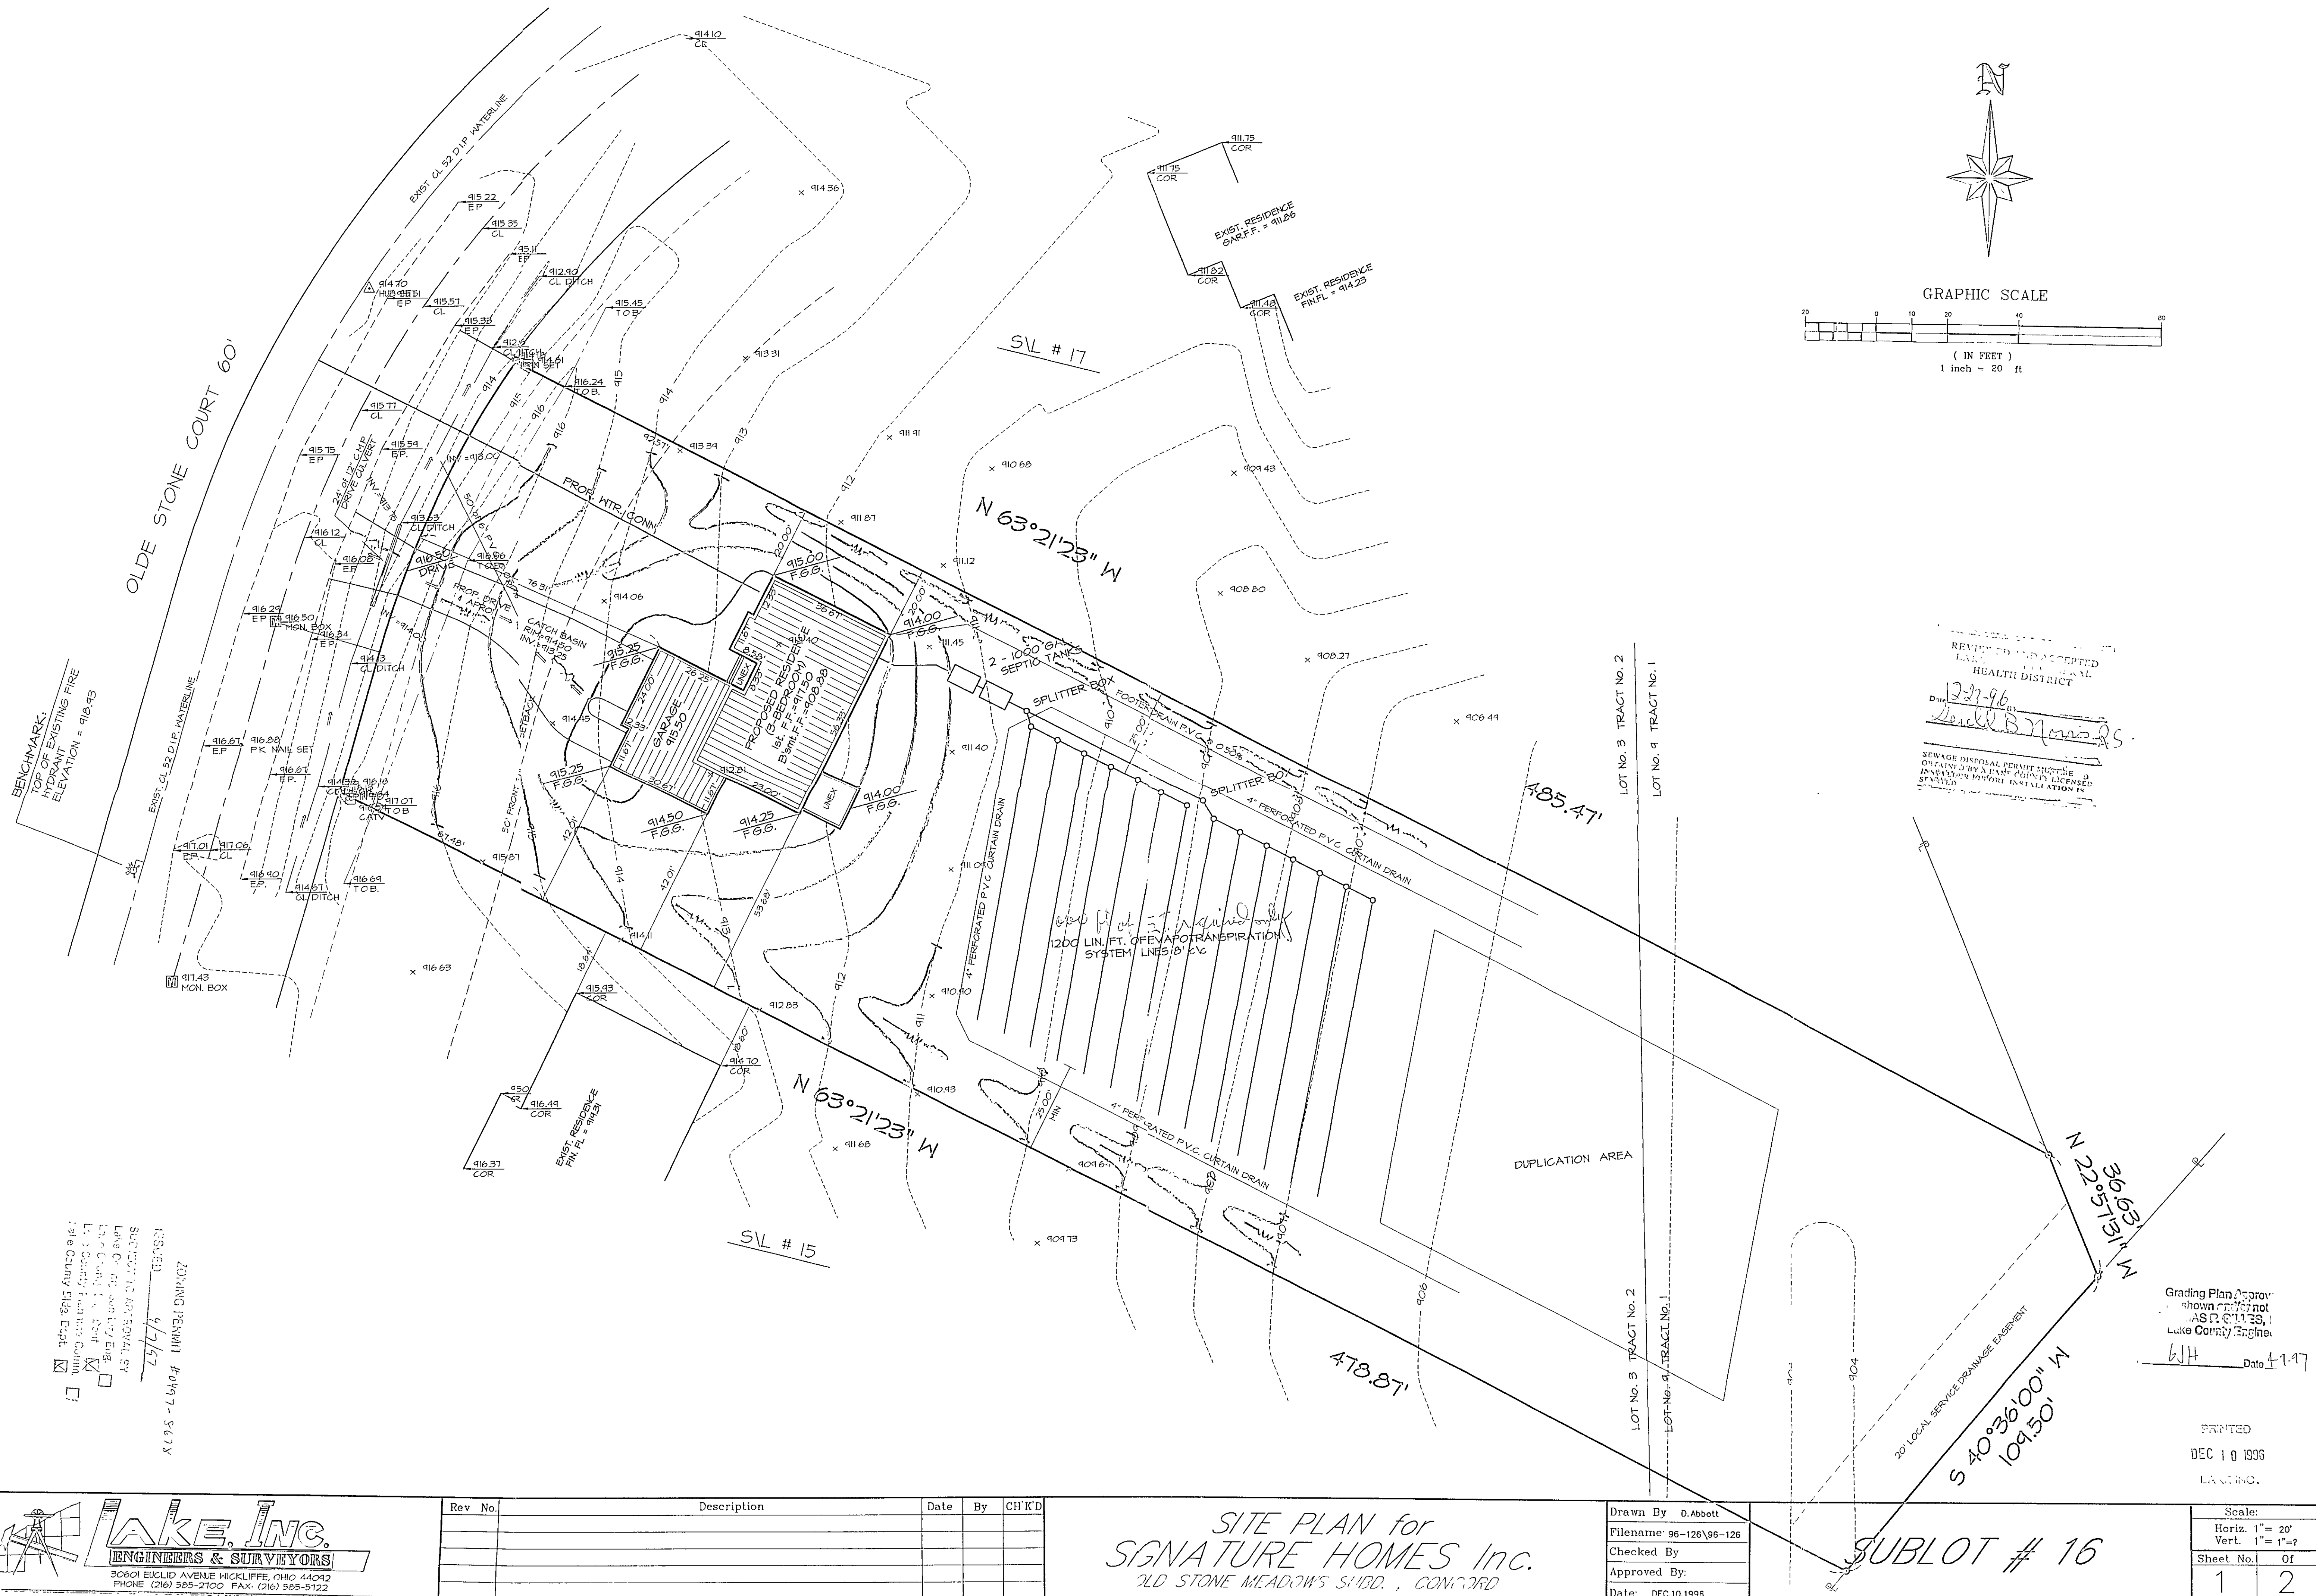
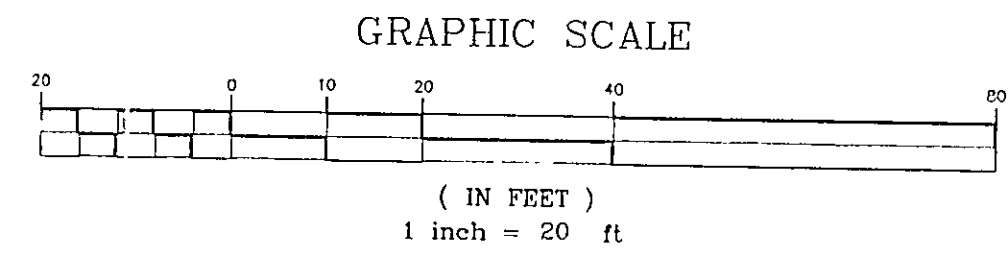
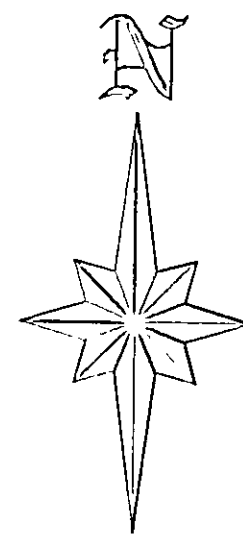


Rev No.	Description	Date	By	CHK'D

SITE PLAN for
SIGNATURE HOMES Inc.
OLD STONE MEADOWS SUBD., CONCORD

Drawn By	D. Abbott
Filename	96-126\96-126
Checked By	
Approved By	
Date	DEC.10,1996

SUBLOT # 16

Scale:	
Horiz. 1"= 20'	
Vert. 1"= 1'-2"	
Sheet No.	Of
1	2

