

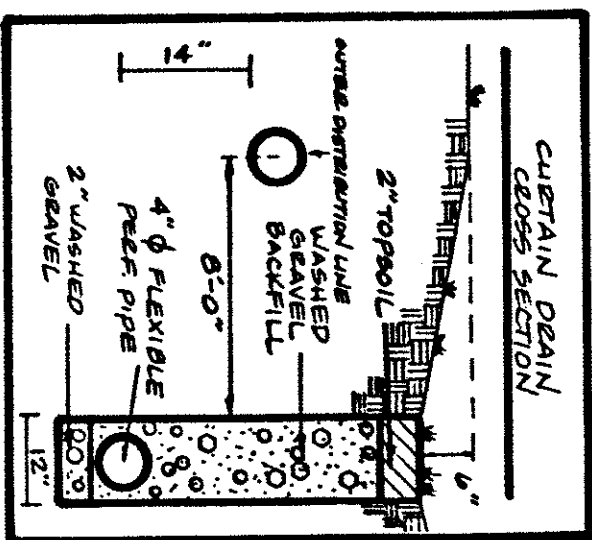


EVAPORATION - TRANSPIRATION
TRENCH CROSS SECTION

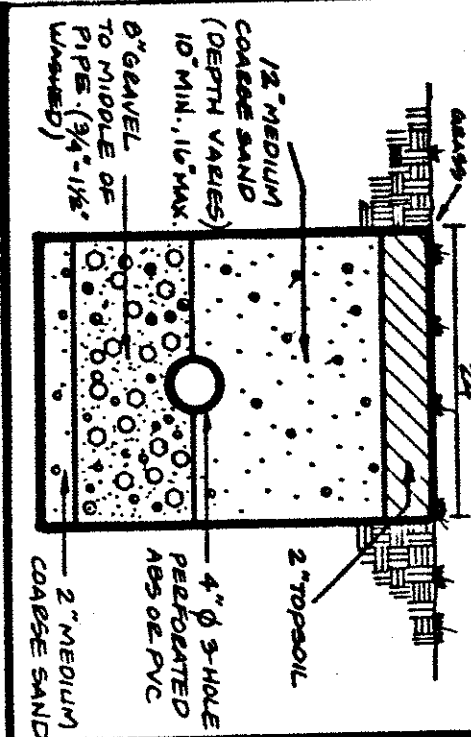



S/L 12
VACANT

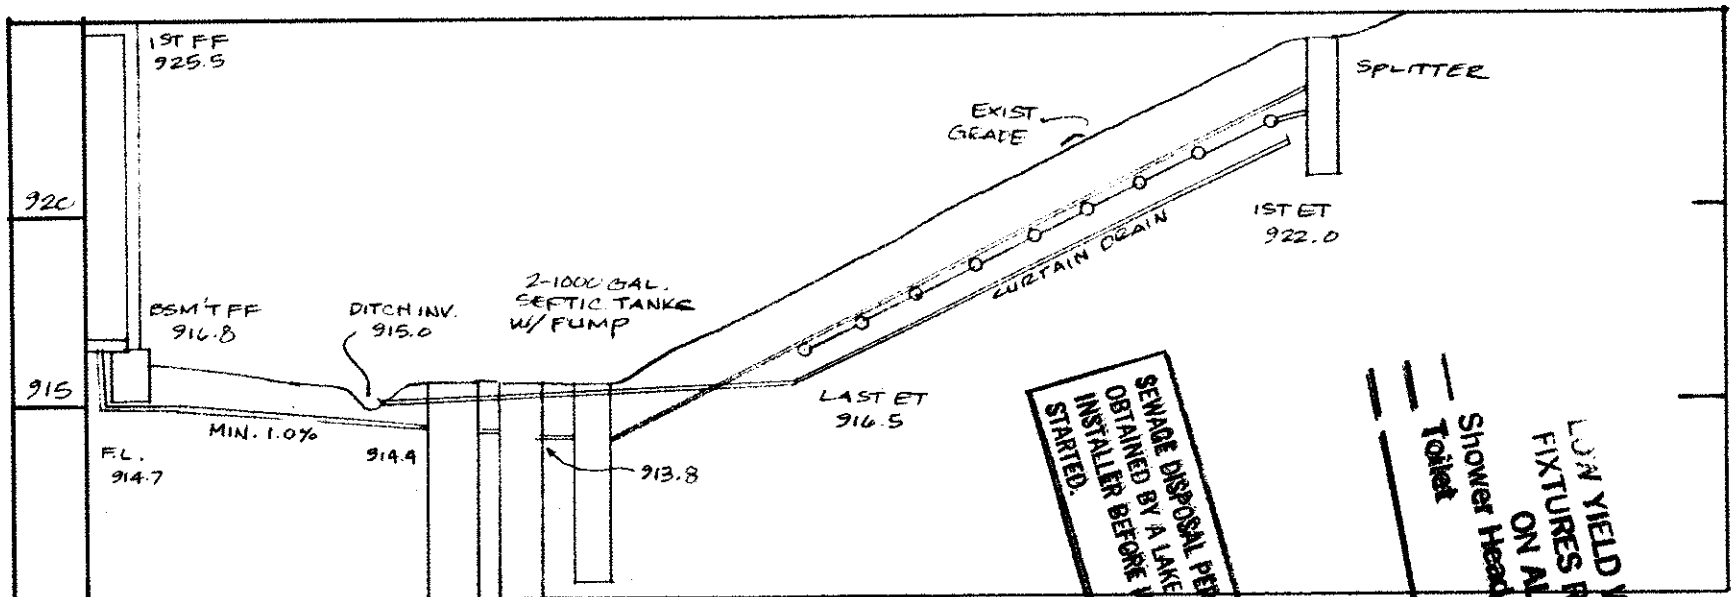

SEWAGE DISPOSAL PERMIT MUST BE OBTAINED BY A LAKE COUNTY LICENSED INSTALLER BEFORE INSTALLATION IS STARTED.

NO YIELD WATER
FIXTURES REQUIRED
ON ALL
Shower Head
Toilet

Reviewed and Accepted
LAKE COUNTY GENERAL HEALTH DISTRICT
Date 3-24-94
Supervision Area
JOEL LUCKA, R.S., M.P.H.
Health Commissioner
[Signature]

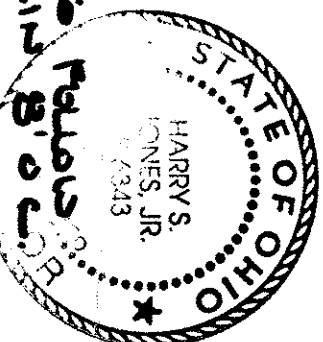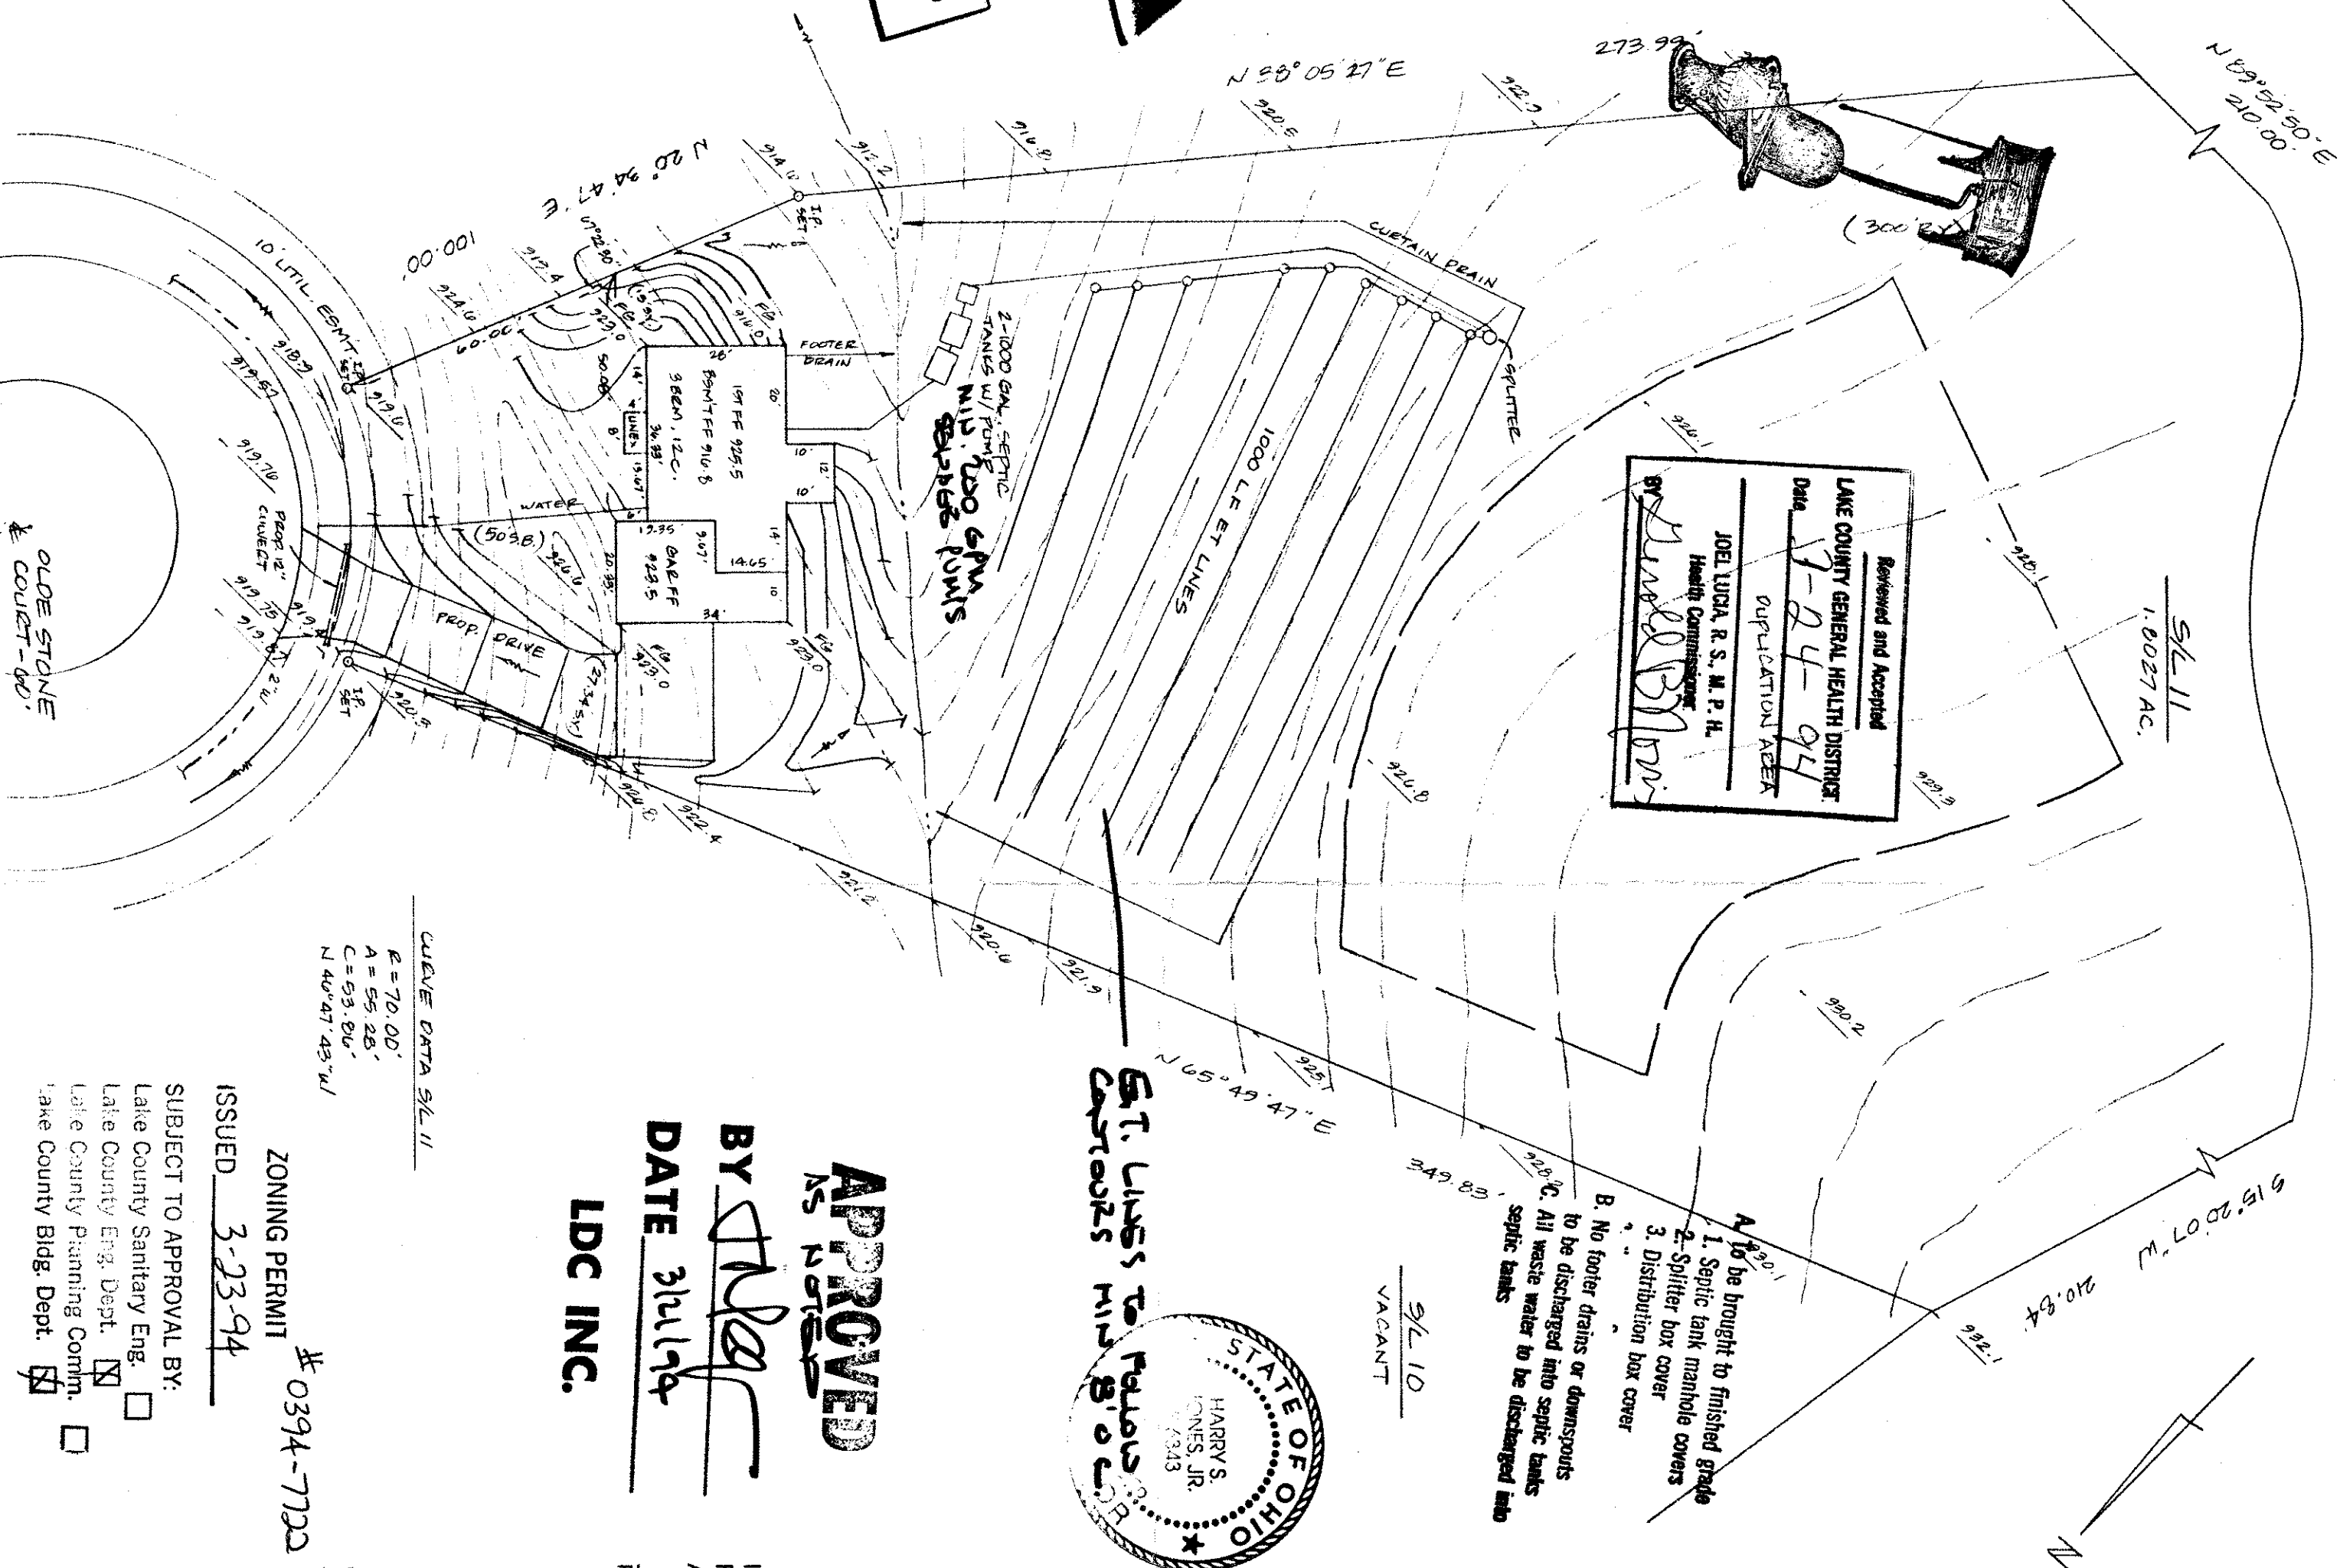

ST. LINES TO PAVEMENT
CUTSORS MIN 8' 0\"/>

APPROVED
BY *[Signature]*
DATE 3/14/94
LDC INC.

CURVE DATA S/L 11
E = 70.00'
A = 55.28'
C = 53.80'
N 40° 47' 43\"/>

ZONING PERMIT # 0394-7720
ISSUED 3-23-94
SUBJECT TO APPROVAL BY:
☐ Lake County Sanitary Eng.
☒ Lake County Eng. Dept.
☐ Lake County Planning Comm.
☒ Lake County Bldg. Dept.

SITE PLAN

CONCORD TWP., LAKE COUNTY, OHIO

for: E.L. MOORE HOMES

CLIENT 11520 Old Stone Ct.
ADDRESS Old Stone Ct. CITY Stone Ct. ZIP

OLD STONE MEADOWS SUB	LOT	TRACT
SUBDIVISION <u>20-12</u> NAME <u>OLD STONE CT.</u>	VOLUME <u></u>	PAGE <u></u>
SUBLOT NO. <u>11</u> STREET <u>OLD STONE CT.</u>	PERM. PARCEL NO. <u></u>	STREET <u></u>

LEGEND	INDICATES
SANITARY MANHOLE	WATER VALVE (GAS)
STORM MANHOLE	WATER METER (GAS)
INLET OR CATCH BASIN	AS BUILT ELEVATION
HYDRANT	INDICATES
EXISTING CONTOURS	DIRECTION OF
PROPOSED CONTOURS	SURFACE DRAINAGE
EXIST. ELEV. <u>1000</u> PROP. ELEV. <u>1000</u>	

REMARKS
ALL BOUNDARY DATA SHOWN WAS OBTAINED FROM IDEEDS, RECORDED
SUBDIVISION PLAT OR OTHER PUBLIC RECORDS
LOCATIONS AS SHOWN OF ADJACENT WELLS AND SEPTIC TANKS OBTAINED FROM
LAKE COUNTY HEALTH DEPARTMENT

DESIGN CERTIFICATION
THIS PLAT WAS PREPARED BY ME, AND IS CORRECT
TO THE BEST OF MY KNOWLEDGE AND BELIEF
NAME [Signature] SURVEYOR REGISTRATION NO. 10343

CHECK LIST	WATER MAIN SIZE, LOCATION
NO. OF BEDROOMS	SAN. SEWER SIZE % GR. LOC.
BEARINGS	SAN. MH. CAST. ELEV. INV. ELEV.
TIE TO NEAREST STREET	SAN. CONN. SIZE, LOC. DEPTH
SUBLOT NO. PARCEL NO.	STORM SEWER SIZE % GR. LOC.
SURROUNDING OWNERS	STORM MH. CAST ELEV. INV. ELEV.
BLDG. DIMENSIONS FIN. GR.	PAV. TYPE GRADE CURBS
BLDG. TIES FLR. GRADES	GAS LINE LOC. SIZE PRESSURE
APRON TYPE LOC. THICKNESS	SEPTIC TANK LOCATION & DUPLICATION AREA
SIDEWALK TYPE DIA. LENGTH	WELL LOCATION
ROCK OUTCROPPINGS	ISOLATION RADIUS FROM WELL

REVISIONS	PLAN PREPARED BY:
NO. DATE BY	BABCOCK • JONES & ASSOCIATES, INC.
1	PAINESVILLE, OHIO
2	DRAWN BY <u>[Signature]</u> SCALE 1" = 30'
3	CHK'D. <u>[Signature]</u> DATE 3-21-94 DRAWING NO. 357-1811
4	CREW <u>[Signature]</u> APP'D. <u>[Signature]</u> 93-137-11
5	CHIEF <u>[Signature]</u>

"AS BUILT" CERTIFICATION
I, HEREBY CERTIFY THAT THE CIRCLED GRADES ARE EXISTING
FINISH GRADES CHECKED IN THE FIELD ON 19
AND ARE CORRECT TO THE BEST OF MY KNOWLEDGE AND BELIEF.

REGISTERED SURVEYOR REG. NO. 921.840
BENCHMARK: TOP OF HYDRANT CUL-DE-SAC, ELEV. = 921.840

"I, the undersigned hereby certify that
this topography indicated by 6", 1" or 2"
contours, and elevations shown hereon
represent an actual field survey made by
me on the 14th day of March, 1994
and that the elevations were taken at
appropriate intervals and that as of that
date they existed as indicated hereon."

Name: [Signature] Reg. No. 6343
ROOF DRAINS
SHALL DISCHARGE
TO SPLASH BLOCKS.