



Rev. No.	Description	Date	By	CHK'D



SITE PLAN for
SIGNATURE HOMES Inc.

Drawn By: D. Abbott
Filename: 96-126/96-126
Checked By:
Approved By:

SUBLOT # 16

Scale:
HORIZ. 1" = 20'
VERT. 1" = 1'-0"
Sheet No.
1
2

ISSUED 4/7/97
ZONING PERMIT #0497-8678
SUBJECT TO APPROVAL BY:
Lake County Sanitary Eng.
Lake County Eng. Dept.
Lake County Planning Comm.
Lake County Bldg. Dept.

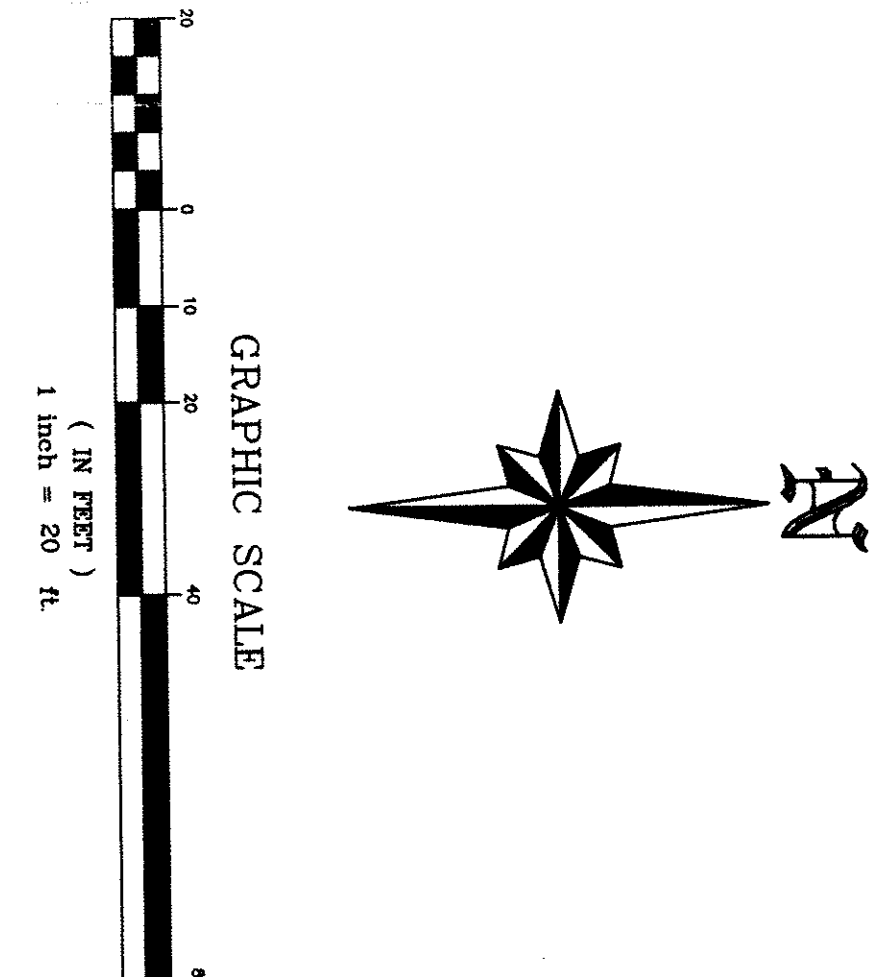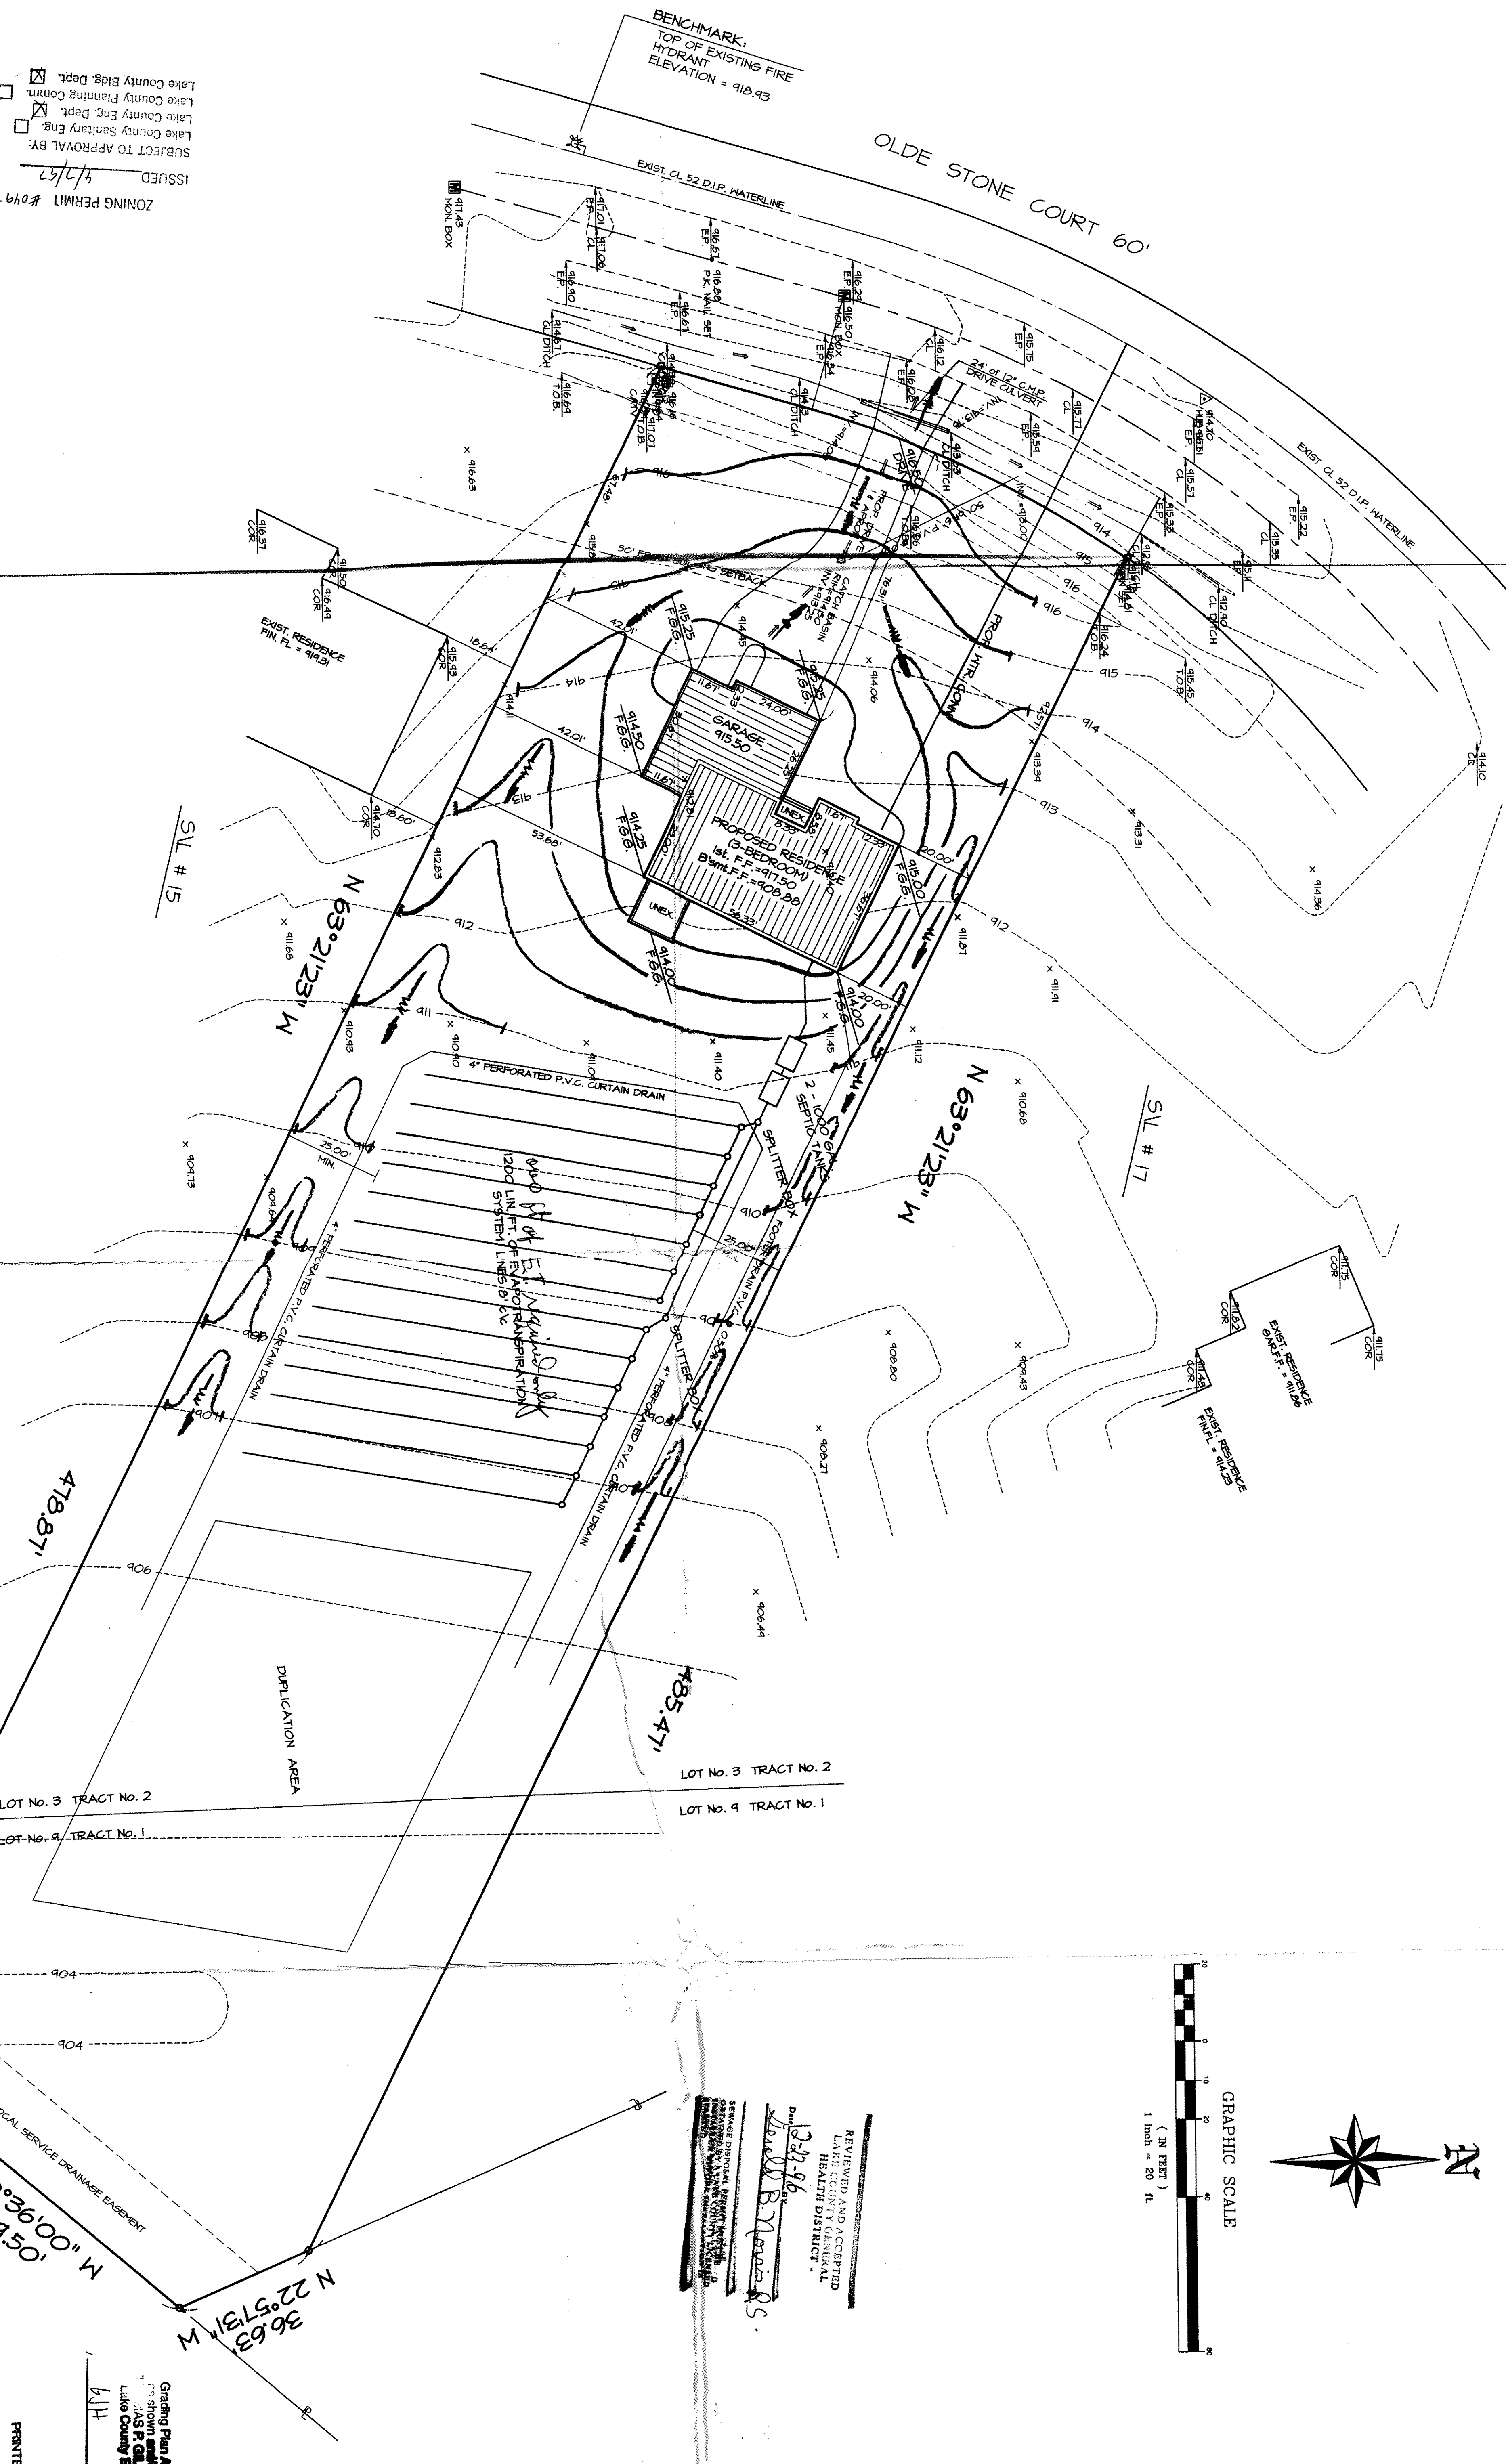

REVIEWED AND ACCEPTED
LAKE COUNTY GENERAL
HEALTH DISTRICT
DATE 12-3-96
J. B. Brown, Jr.

Grading Plan Approved
by S. P. G. G. G.
Lake County Engineer
Date 1-1-97

PRINTED
DEC 10 1996
LAKE INC.