
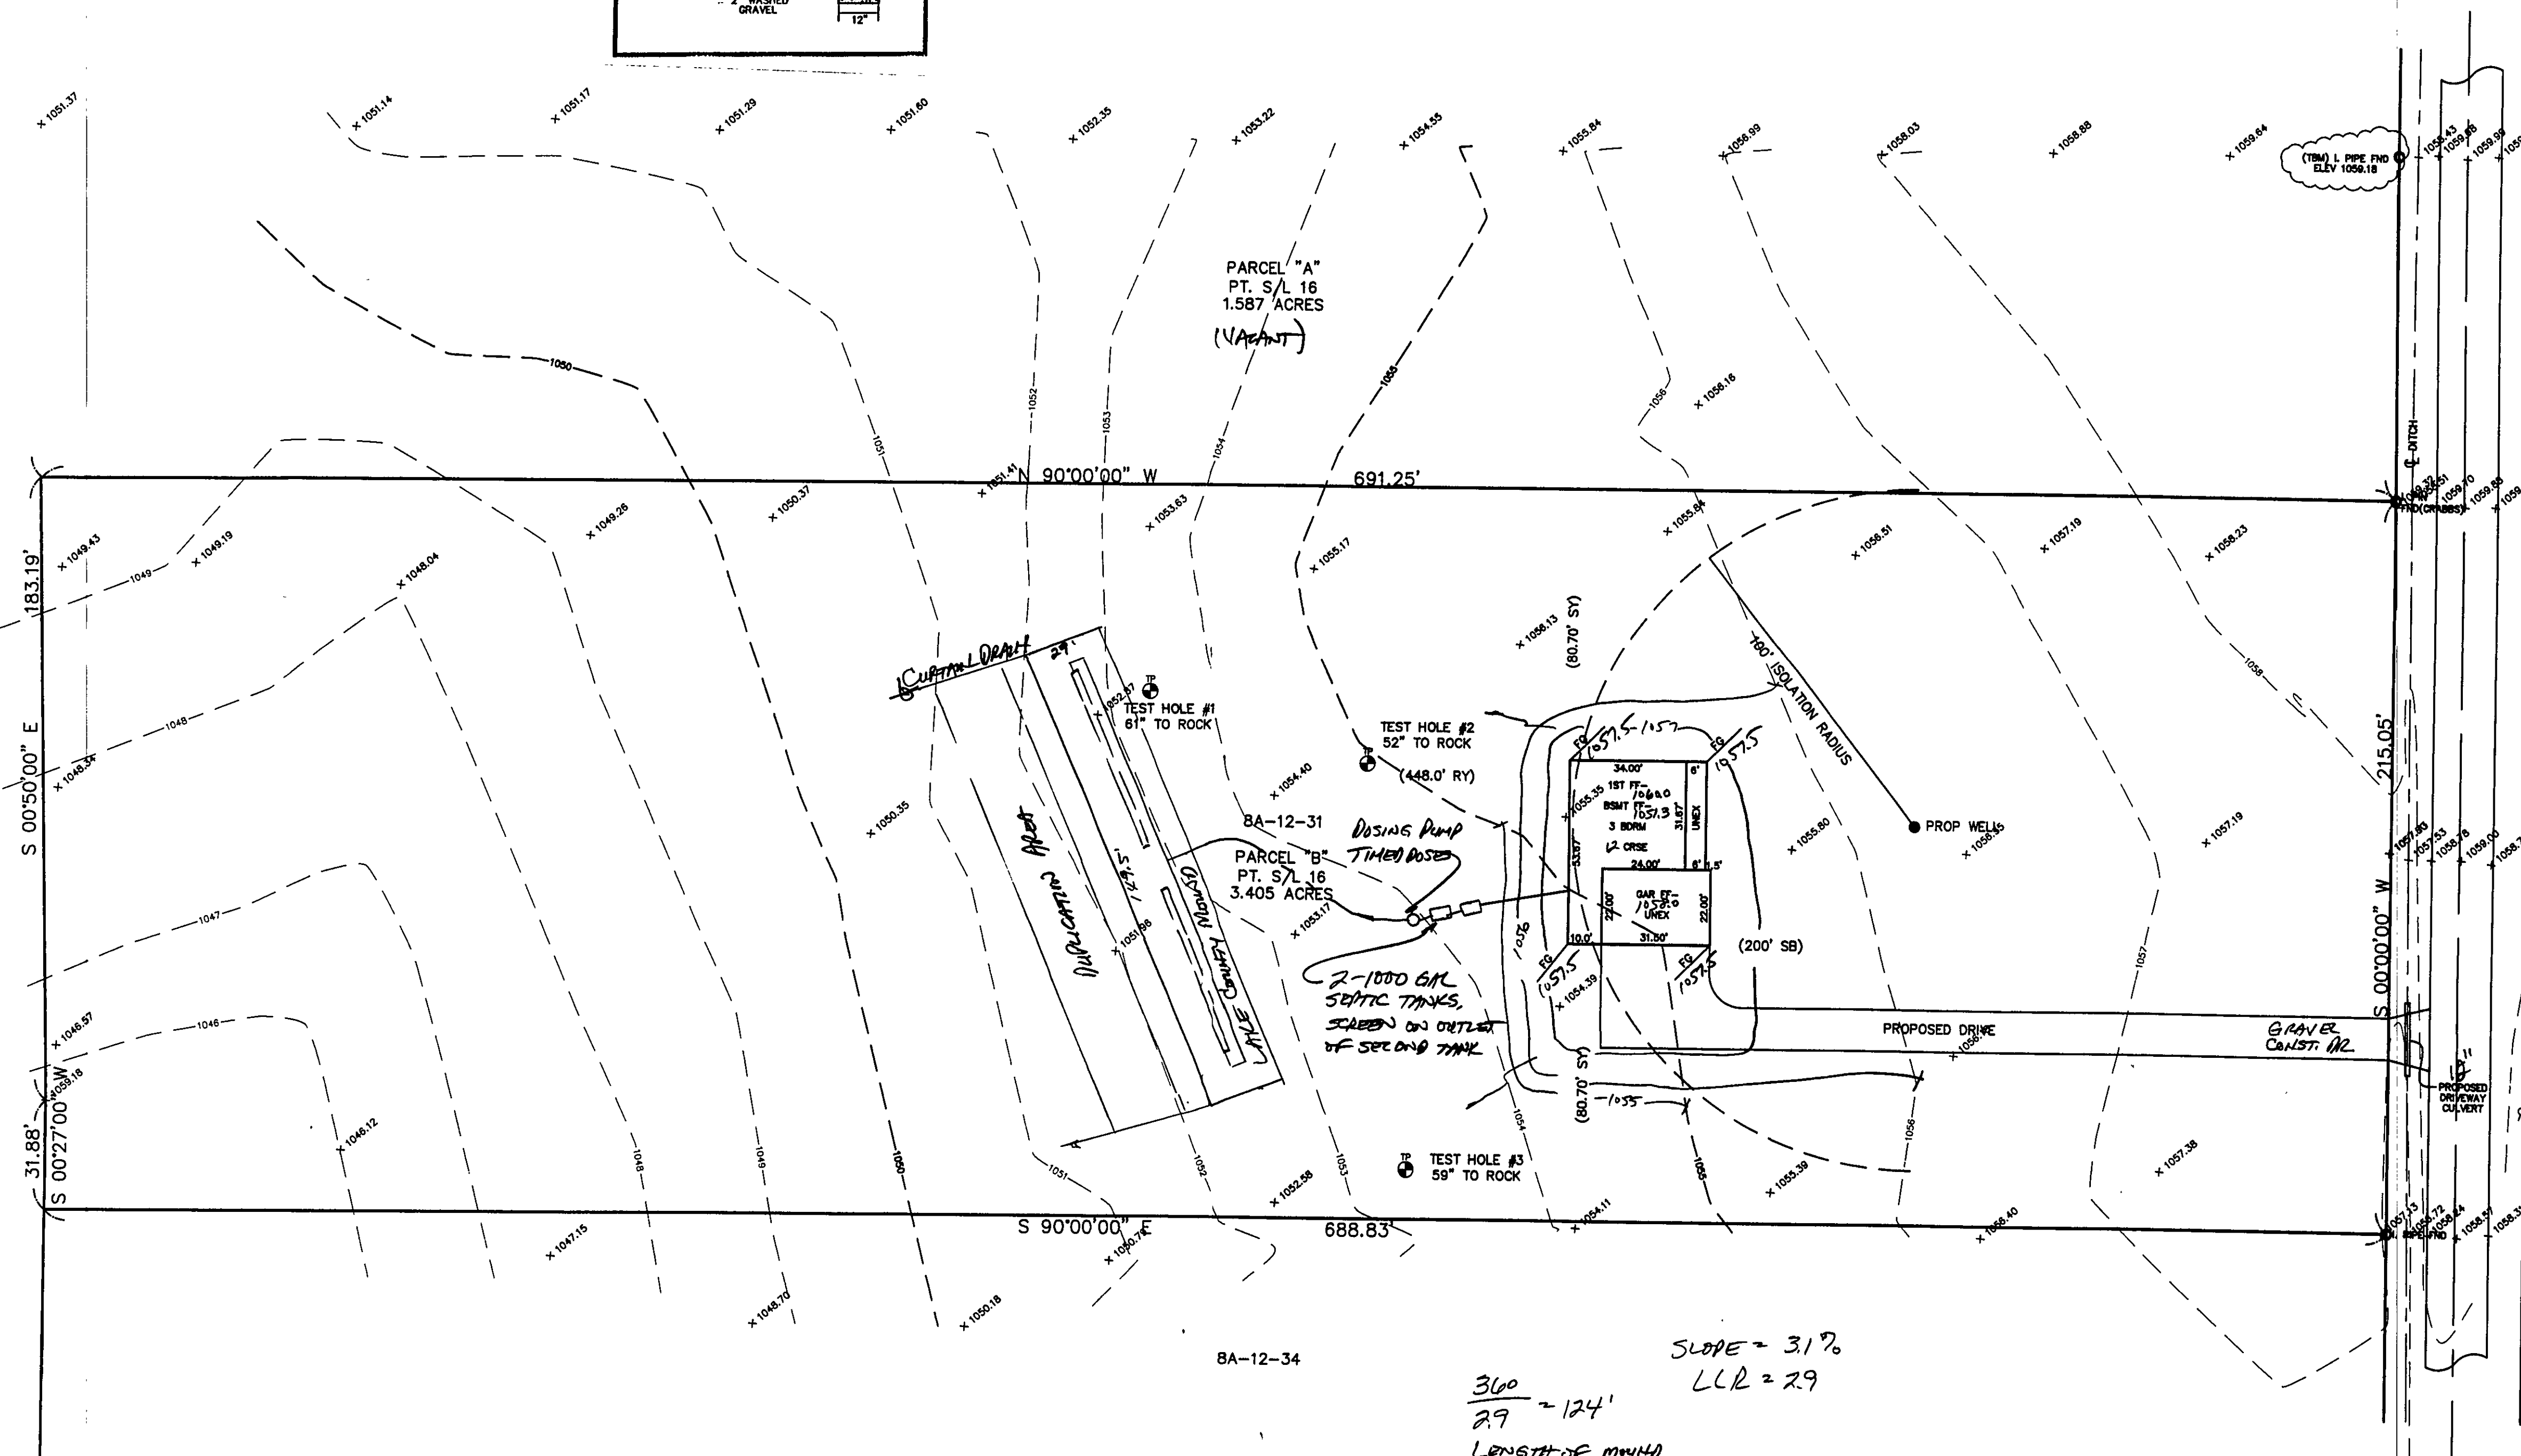


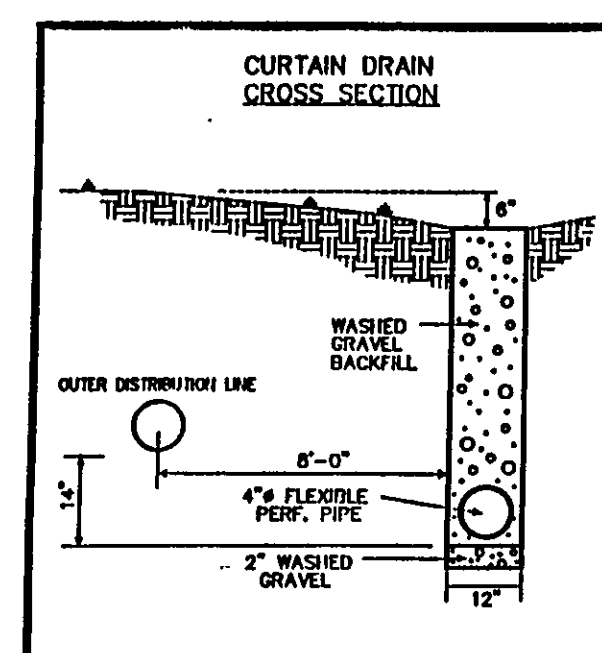

CONCORD TOWNSHIP ZONING OFFICE
ZONING PERMIT # 1003-113
ISSUED 10/14/03
SUBJECT TO APPROVAL BY:
☒ Mr. Co. Sanitary Engineer
☒ Mr. Co. Eng. Dept.
☐ Mr. Co. Planning Comm.
☐ Mr. Co. Building Dept.
☒ Mr. Co. Soil & Water Cons. Dist.

REVIEWED AND ACCEPTED
LAKE COUNTY GENERAL
HEALTH DISTRICT ☒

Date 10-20-53

SEWAGE DISPOSAL PERMIT MUST BE OBTAINED BY A LAKE COUNTY LICENSED INSTALLER BEFORE INSTALLATION IS STARTED.

"I, the undersigned hereby certify that this topography indicated by 6", 1", or 2" contours, and elevations shown hereon represent an actual field survey made by me on the 18th day of APRIL, 2003 and that the elevations were taken at appropriate intervals and that as of that date they existed as indicated hereon."


Name Henry Jones Reg. No. #6343

SOUTH ORCHARD ROAD - 40'

Stormwater Management Plan
Approved as shown and/or noted
JAMES R. GILLS, P.E.
County Drainage Engineer
By 6/1/16 Date 6/1/16

TBM- 2" IRON PIPE
ELEV- 1059.18

EXISTING UTILITIES NOTE:
THE SIZE AND LOCATION, BOTH HORIZONTAL AND VERTICAL
OF THE UNDERGROUND UTILITIES SHOWN HEREON, HAVE BEEN
OBTAINED BY A SEARCH OF AVAILABLE RECORDS.
VERIFICATION BY FIELD OBSERVATION HAS BEEN CONDUCTED
WHERE PRACTICAL. HOWEVER, BABCOCK, JONES AND ASSOCIATE
INC. DOES NOT GUARANTEE THE COMPLETENESS NOR ACCURACY
THEREOF.

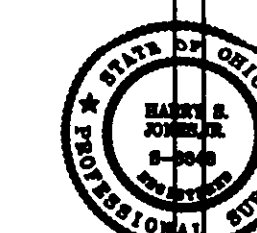

REV. NO.	DESCRIPTION	DATE	BY	CHK'D
1	ADDED TEST HOLES	4/24/03	H.J.	H.J.
2	REVISED CONTOURS	4/24/03	B.P.	H.J.
3	PUT HOUSE ON LOT	9/23/03	N.S.	H.J.
4	Revised SETBACK TO MOUND	9/30/03	HJ	HJ
5	Revised MOUND	10/9/03	HJ	HJ

bj BABCOCK, JONES AND ASSOCIATES, INC
CIVIL ENGINEERS - SURVEYORS - LAND PLANNERS
PAINESVILLE OHIO 44077

DATE	4/21/03
DESIGN BY	HJ
DRAWN BY	NS
APPROVED BY	HJ

SITE PLAN
FOR
SCOTT & TINA SALMINEN

CONCORD TOWNSHIP LAKE COUNTY STATE OF OHIO

SCALE	1"=30'	
JOB NO.	03-058-A	
SHEET	/	OF
1		2