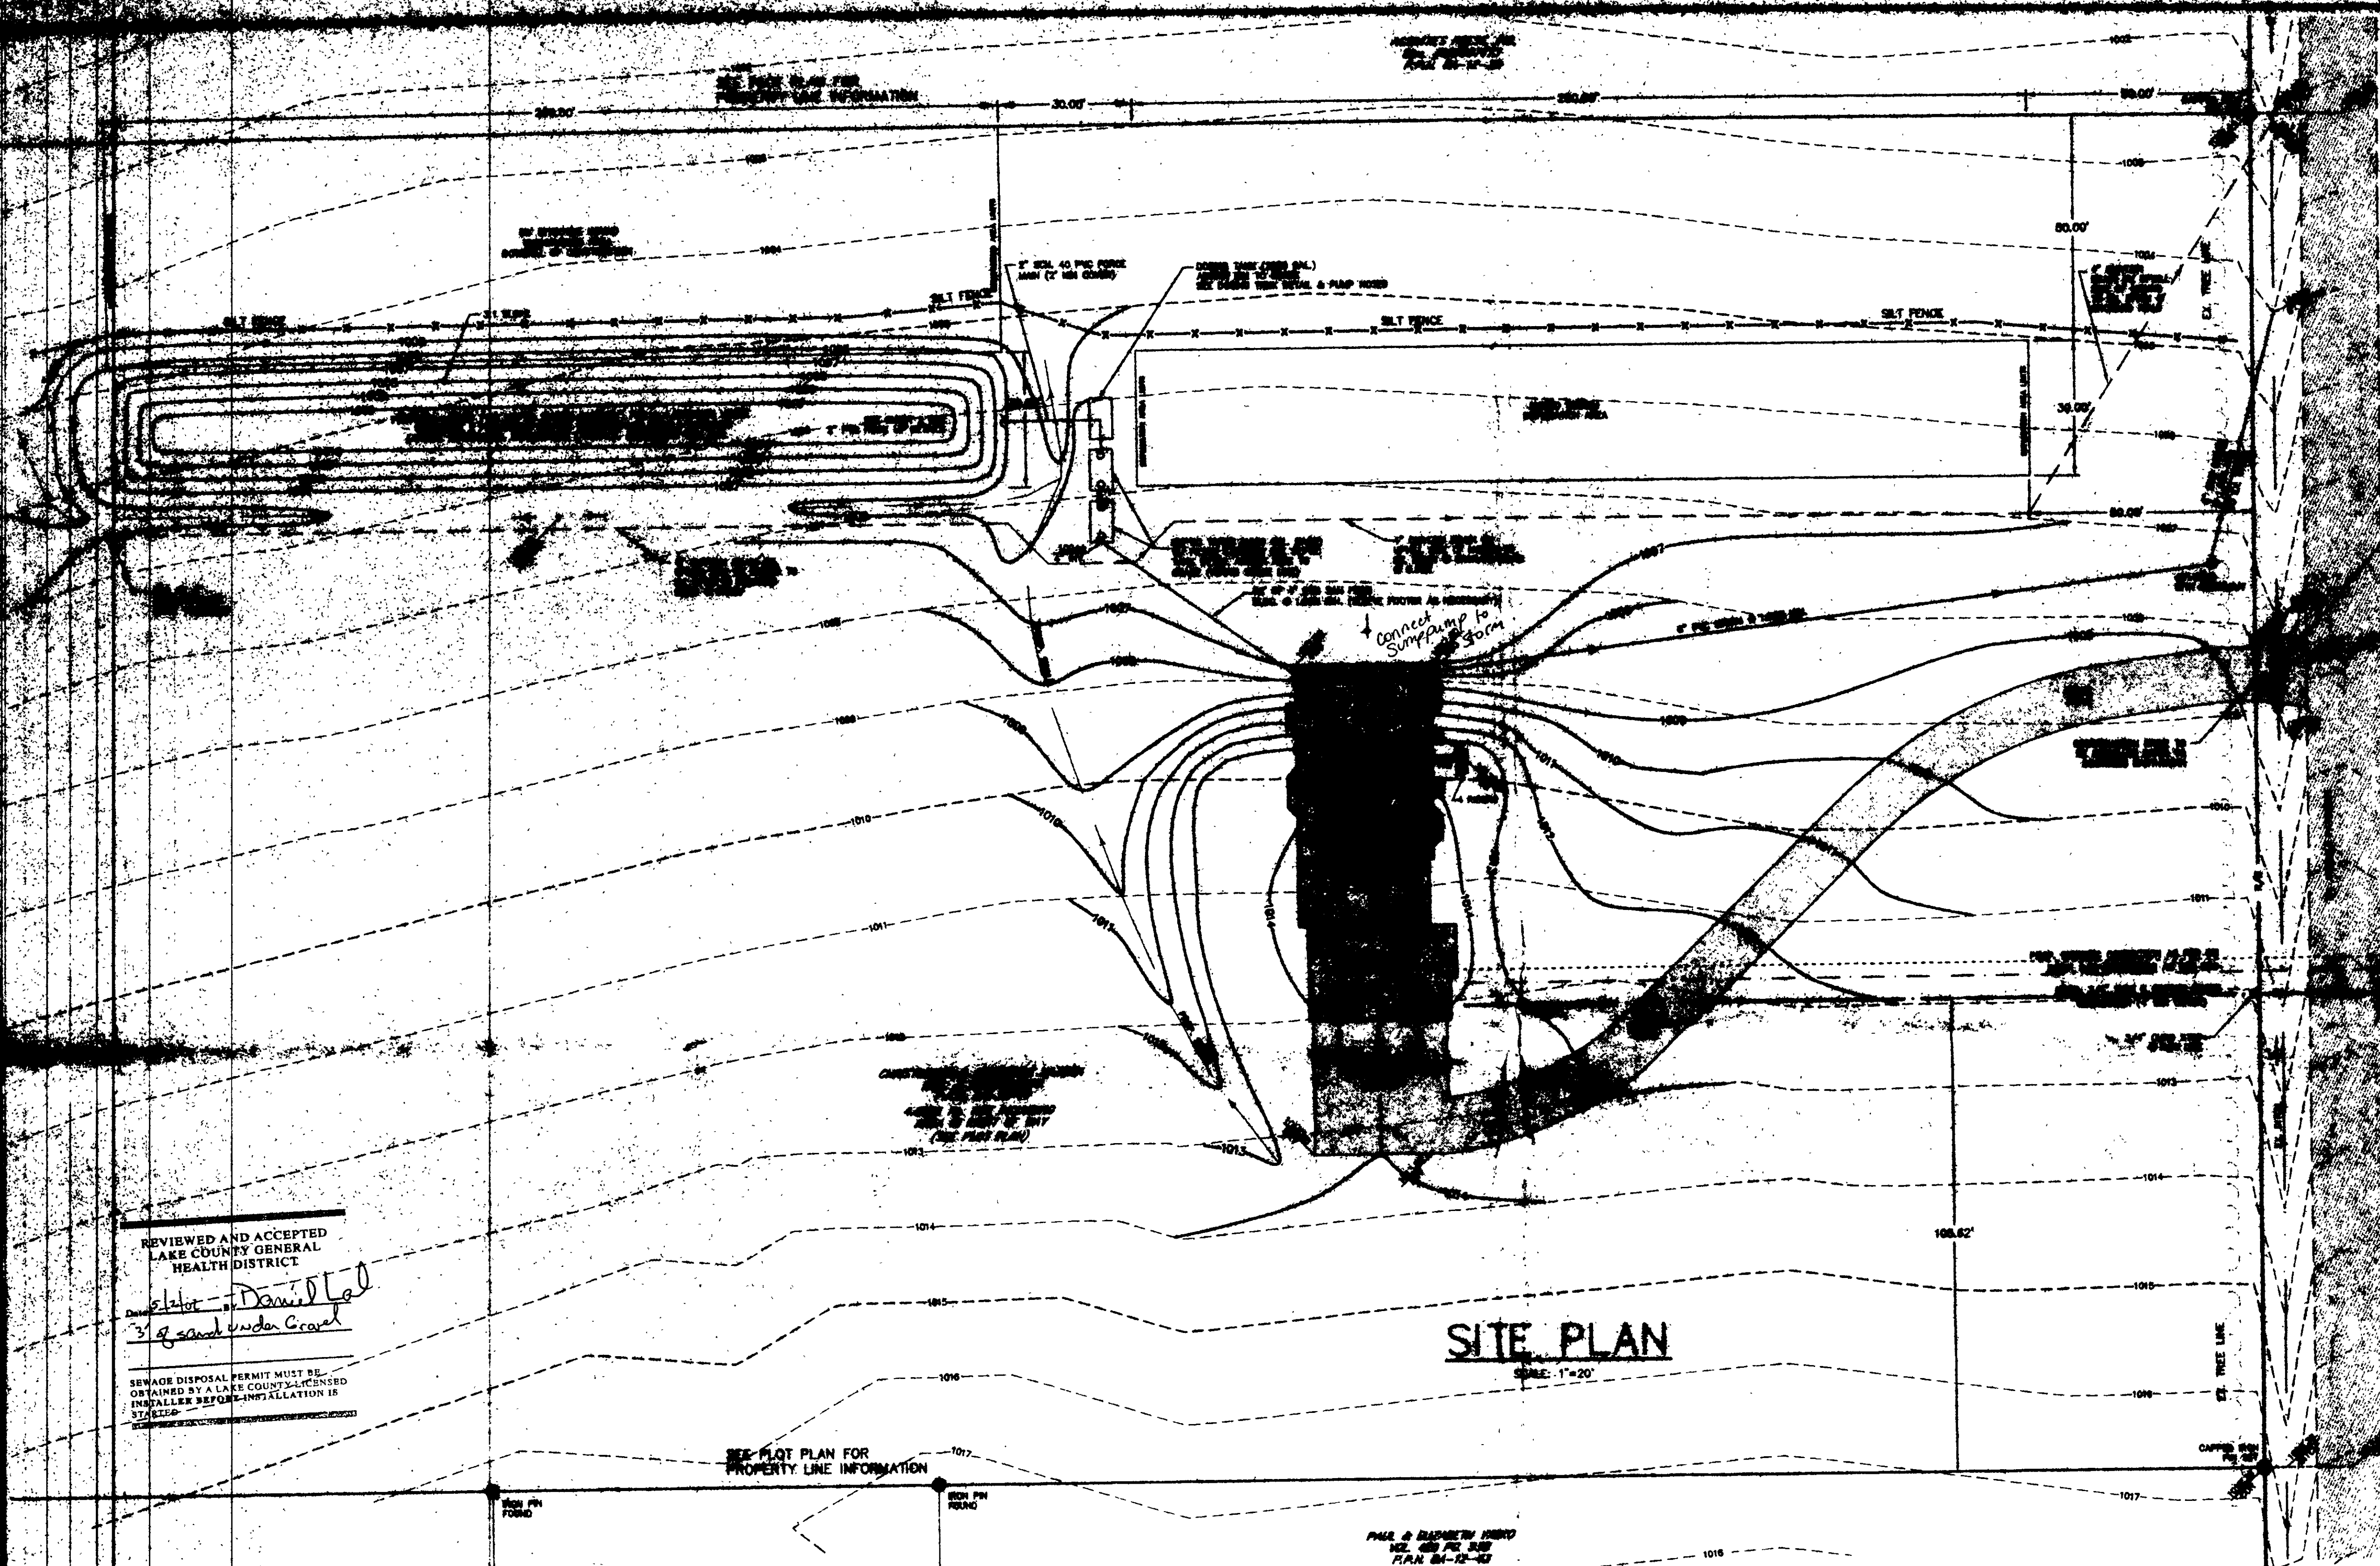




CONCORD TOWNSHIP ZONING OFFICE
ZONING PERMIT # 0502-10
ISSUED 5/3/02
SUBJECT TO APPROVAL BY:
☐ Lata Co. Sanitary Engineer
☒ Lata Co. Eng. Dept.
☐ Lata Co. Planning Comm.
☒ Lata Co. Building Dept.
☒ Lata Co. Soil & Water Cons. Dist.

Grading Plan Approved
as shown and/or noted
JAMES R. GILLS, P.E.
Lake County Engineer

By LMJ Date 5/7/02

AS NOTED

ORCHARD ROAD (40' WIDE)

REVIEWED AND ACCEPTED
LAKE COUNTY GENERAL
HEALTH DISTRICT

5/2/01 Daniel La
3 of sand under gravel

SEWAGE DISPOSAL PERMIT MUST BE
OBTAINED BY A LAKE COUNTY LICENSED
INSTALLER BEFORE INSTALLATION IS
STARTED

BENCHMARK:
NAIL IN SOUTH SIDE OF UTILITY POLE @ NE
CORNER OF CIRCLED ROAD & ORCHARD ROAD
ELEV: 1025.60

SITE PLAN CERTIFICATION

"I, THE UNDERSIGNED, HEREBY CERTIFY THAT THIS TOPOGRAPHY INDICATED BY '1' TO '10' CONTOURS AND ELEVATIONS SHOWN HEREON REPRESENTS AN ACTUAL FIELD SURVEY MADE BY OVERLAND CONSULTING, INC., UNDER MY SUPERVISION ON THE 22ND OF NOVEMBER 1980 AND THAT THE ELEVATIONS WERE TAKEN AT APPROPRIATE INTERVALS AND THAT AS OF THAT DATE THEY EXISTED AS INDICATED HEREON."

4/28/02
JOHN KURBANICK REGISTERED ENGINEER No. 68506 DATE

SHEET INDEX

*1	SITE PLAN
2	SEPTIC MOUND DETAILS

CONFIDENTIAL - SECURITY INFORMATION

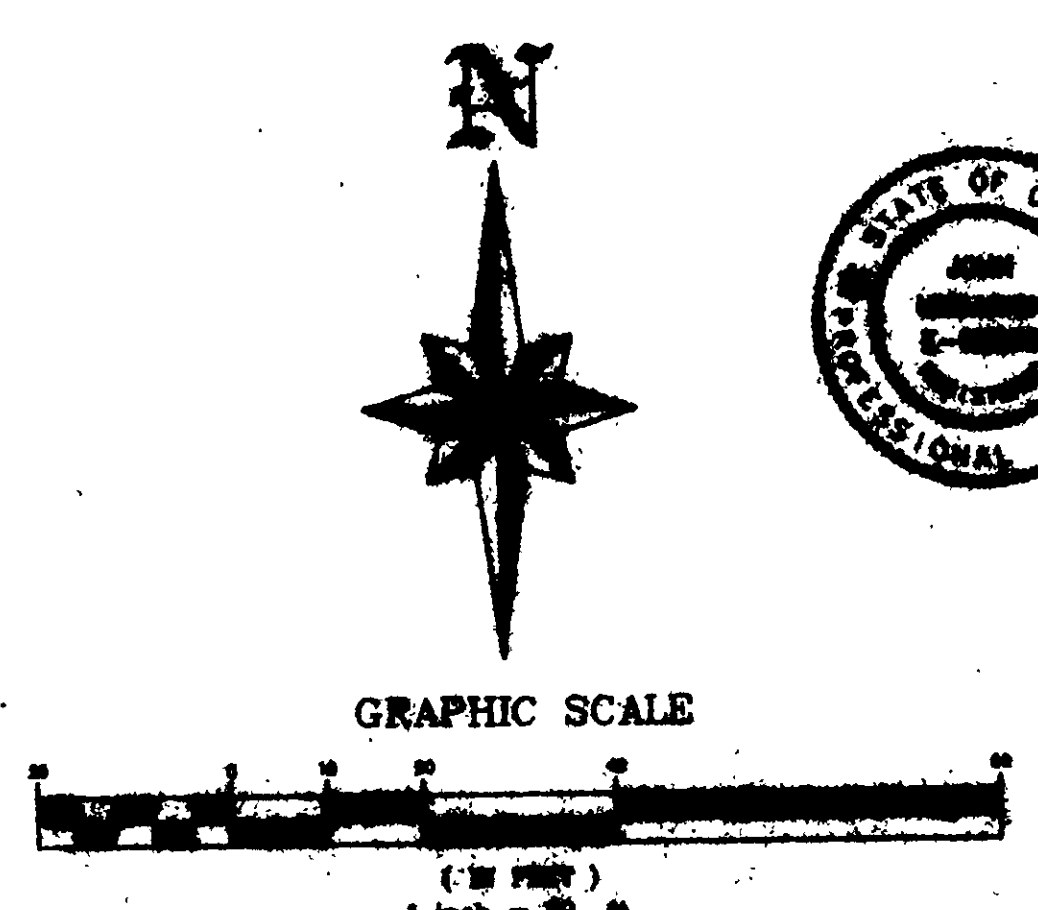
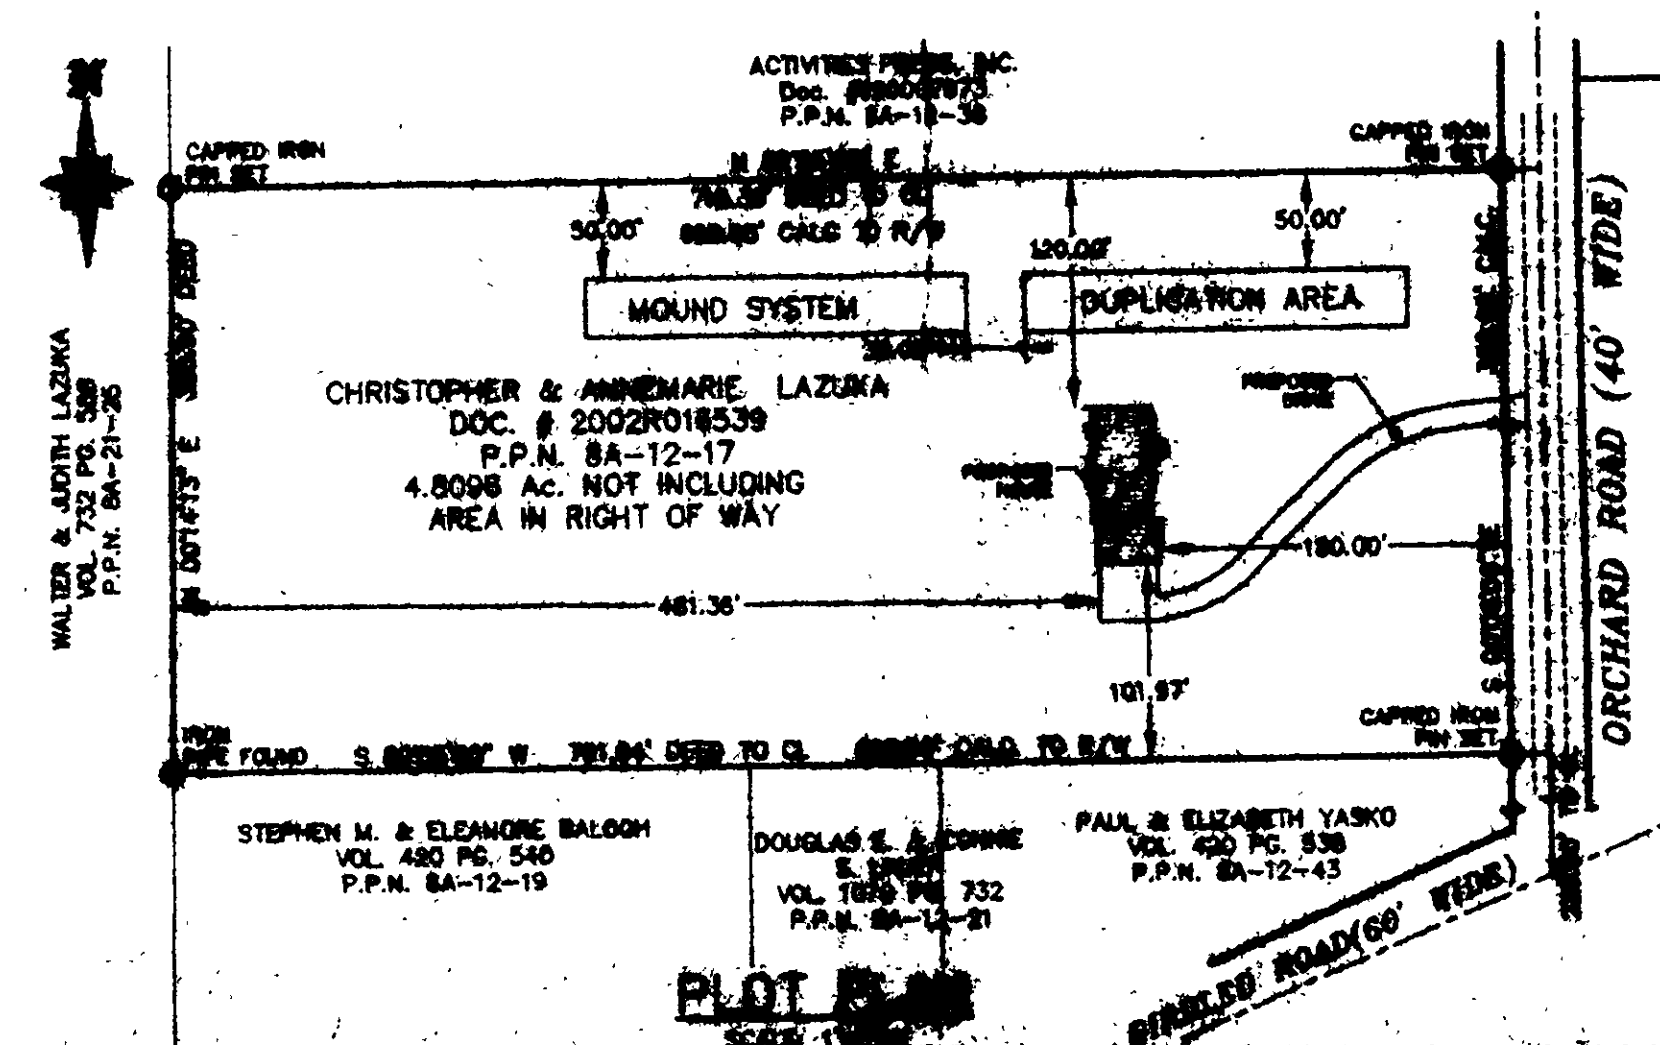
[illegible]

EMISSION CONTROL NOTES

1. ~~IMMEDIATELY~~ ~~REMOVE~~ ~~TRAILING~~ ~~PLANTS~~ ~~REQUIRED~~ ~~BEFORE~~ ~~THE~~ ~~AREA~~ ~~IS~~ ~~TO~~ ~~BE~~ ~~RE-SEEDING~~ ~~IN~~ ~~THE~~ ~~DISBURSED~~ ~~AREAS~~ ~~ARE~~ ~~RESEEDING~~
2. ~~IMMEDIATELY~~ ~~REMOVE~~ ~~ALL~~ ~~TRAILING~~ ~~PLANTS~~ ~~APPLIED~~ ~~WITHIN~~ ~~SIX~~ ~~HOURS~~ ~~AFTER~~ ~~THE~~ ~~DISBURSAL~~ ~~FOR~~ ~~MORE~~ ~~THAN~~ ~~THIRTY~~ ~~DAYS~~
3. ~~WITHIN~~ ~~THIRTY~~ ~~DAYS~~ ~~OF~~ ~~DISBURSAL~~ ~~ON~~ ~~FILL~~ ~~AND~~ ~~FINISHED~~ ~~GRADING~~ ~~THE~~ ~~DISBURSAL~~ ~~MUST~~ ~~BE~~ ~~APPLIED~~ ~~WITHIN~~ ~~SIXTY~~ ~~DAYS~~
5. ~~SEEDS~~ ~~AND~~ ~~SOIL~~ ~~MUST~~ ~~BE~~ ~~TEMPORARILY~~ ~~SEEDING~~ ~~IMMEDIATELY~~ ~~RE-SEEDING~~

DRIVING DUMB NOTE

1. PUMP 10-30 GPMES 0.40 HORSEPOWER
MODEL 30-311 WITH JIS SUPPLY OR MODEL
30-321 WITH ISO SUPPLY.
2. CONTACT HANK INDUSTRIES FOR VALVE AND
PUMP ORDERING INFORMATION @ 330 225

[illegible]