


GRIDDED ROAD 60'

DANIEL W. THIRION
VOL. 754 PG. 488
(1-18-42)

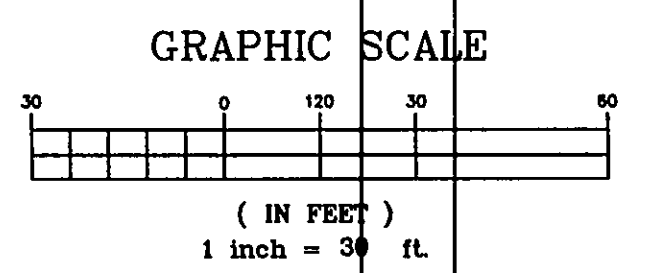

695.00' REC. & MSD.

315.00' REC. & MSD.

695.00' REC. & MSD.

REVIEWED AND ACCEPTED
LAKE COUNTY GENERAL
HEALTH DISTRICT
Date 9-16-98 by
David B. Norris
SEWAGE DISPOSAL PERMIT MUST BE
OBTAINED BY A LAKE COUNTY LICENSED
INSTALLER BEFORE INSTALLATION IS
STARTED

ZONING PERMIT #0998-9204
ISSUED 9/17/98
SUBJECT TO APPROVAL BY:
Lake County Sanitary Eng.
Lake County Eng. Dept.
Lake County Planning Comm.
Lake County Bldg. Dept.

Grading Plan as shown and/or noted by
THOMAS P. GILLES, P.E.
Lake County Engineer
By *TJA* Date 9.18.98
Sump pump must be splash blocked.

THEODORE & SUSANNE LYMAN
VOL. 165 PG. 464
(9-06-85)

PROPERTY KNOWN AS BEING THE NORTHERLY
315' OF SUBLOT No. 29 IN THE LAKE ERIE APPLE
ORCHARD CO. SECOND SUBDIVISION AS RECORDED
IN VOL. C PG. 14 & 41 PARTS OF LOTS 1 & 2 TRACT
No. 2 CONCORD TWP. LAKE COUNTY OHIO

PRINTED
SEP 15 1998
LAKE INC.



Rev. No.	Description	Date	By	CHK'D

SITE PLAN
MR & MRS PETERLIN
ORCHARD ROAD

Drawn By D.Abbott
Filename: 98-106/98-106
Checked By:
Approved By:
Date: SEPT.14,1998

Scale:	1"=30'
Sheet No.	1
Of	2

Z:\Projects\98-106\DWG\98-106 Tue Sep 15 09:30:23 1998