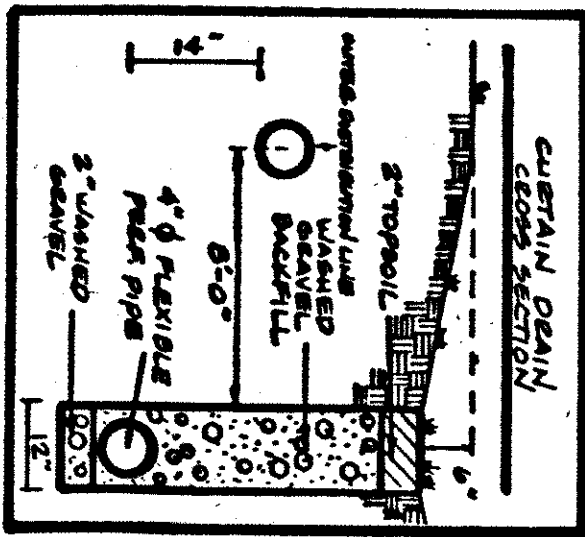


SEWAGE DISPOSAL PERMIT MUST BE
OBTAINED BY A LAKE COUNTY LICENSED
INSTALLER BEFORE INSTALLATION.

**LOW YIELD WATER,
FIXTURES REQUIRED
ON ALL
Shower Head
Toilet**

ISSUED 4-18-94 #0494-7759

ZONING PERMIT

SUBJECT TO APPROVAL BY:

Lake County Sanitary Eng. ☐

Lake County Eng. Dept. ☒


Lake County Planning Comm. ☐

Lake County Bldg. Dept. ☒

Creating Plan Approved
 as shown and/or noted
 THOMAS P. GILLES, P.E.
 Lake County Engineer
 Date 4/19/44
 By GH

"I, the undersigned hereby certify that the topography indicated by 6', 1' or 2' contours, and elevations shown hereon represent an actual field survey made by me on the 11th day of APRIL, 1964 and that the elevations were taken at appropriate intervals and that as of that date they existed as indicated hereon."

Name Wm. J. Jones #6345
 Reg. No.

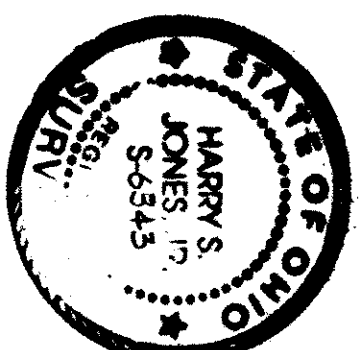

DESIGN BY	E-13-91	SITE PLAN FOR JIM CUMINSKY	JOB NO 98-0356
DRAWN BY	AL		
APPROVED BY	HA		
SHEET	1		

BABCOCK, JONES AND ASSOCIATES, INC.
CIVIL ENGINEERS - SURVEYORS - LAND PLANNERS
PAINESVILLE OHIO 44077

SITE PLAN FOR JIM COMINSKY