


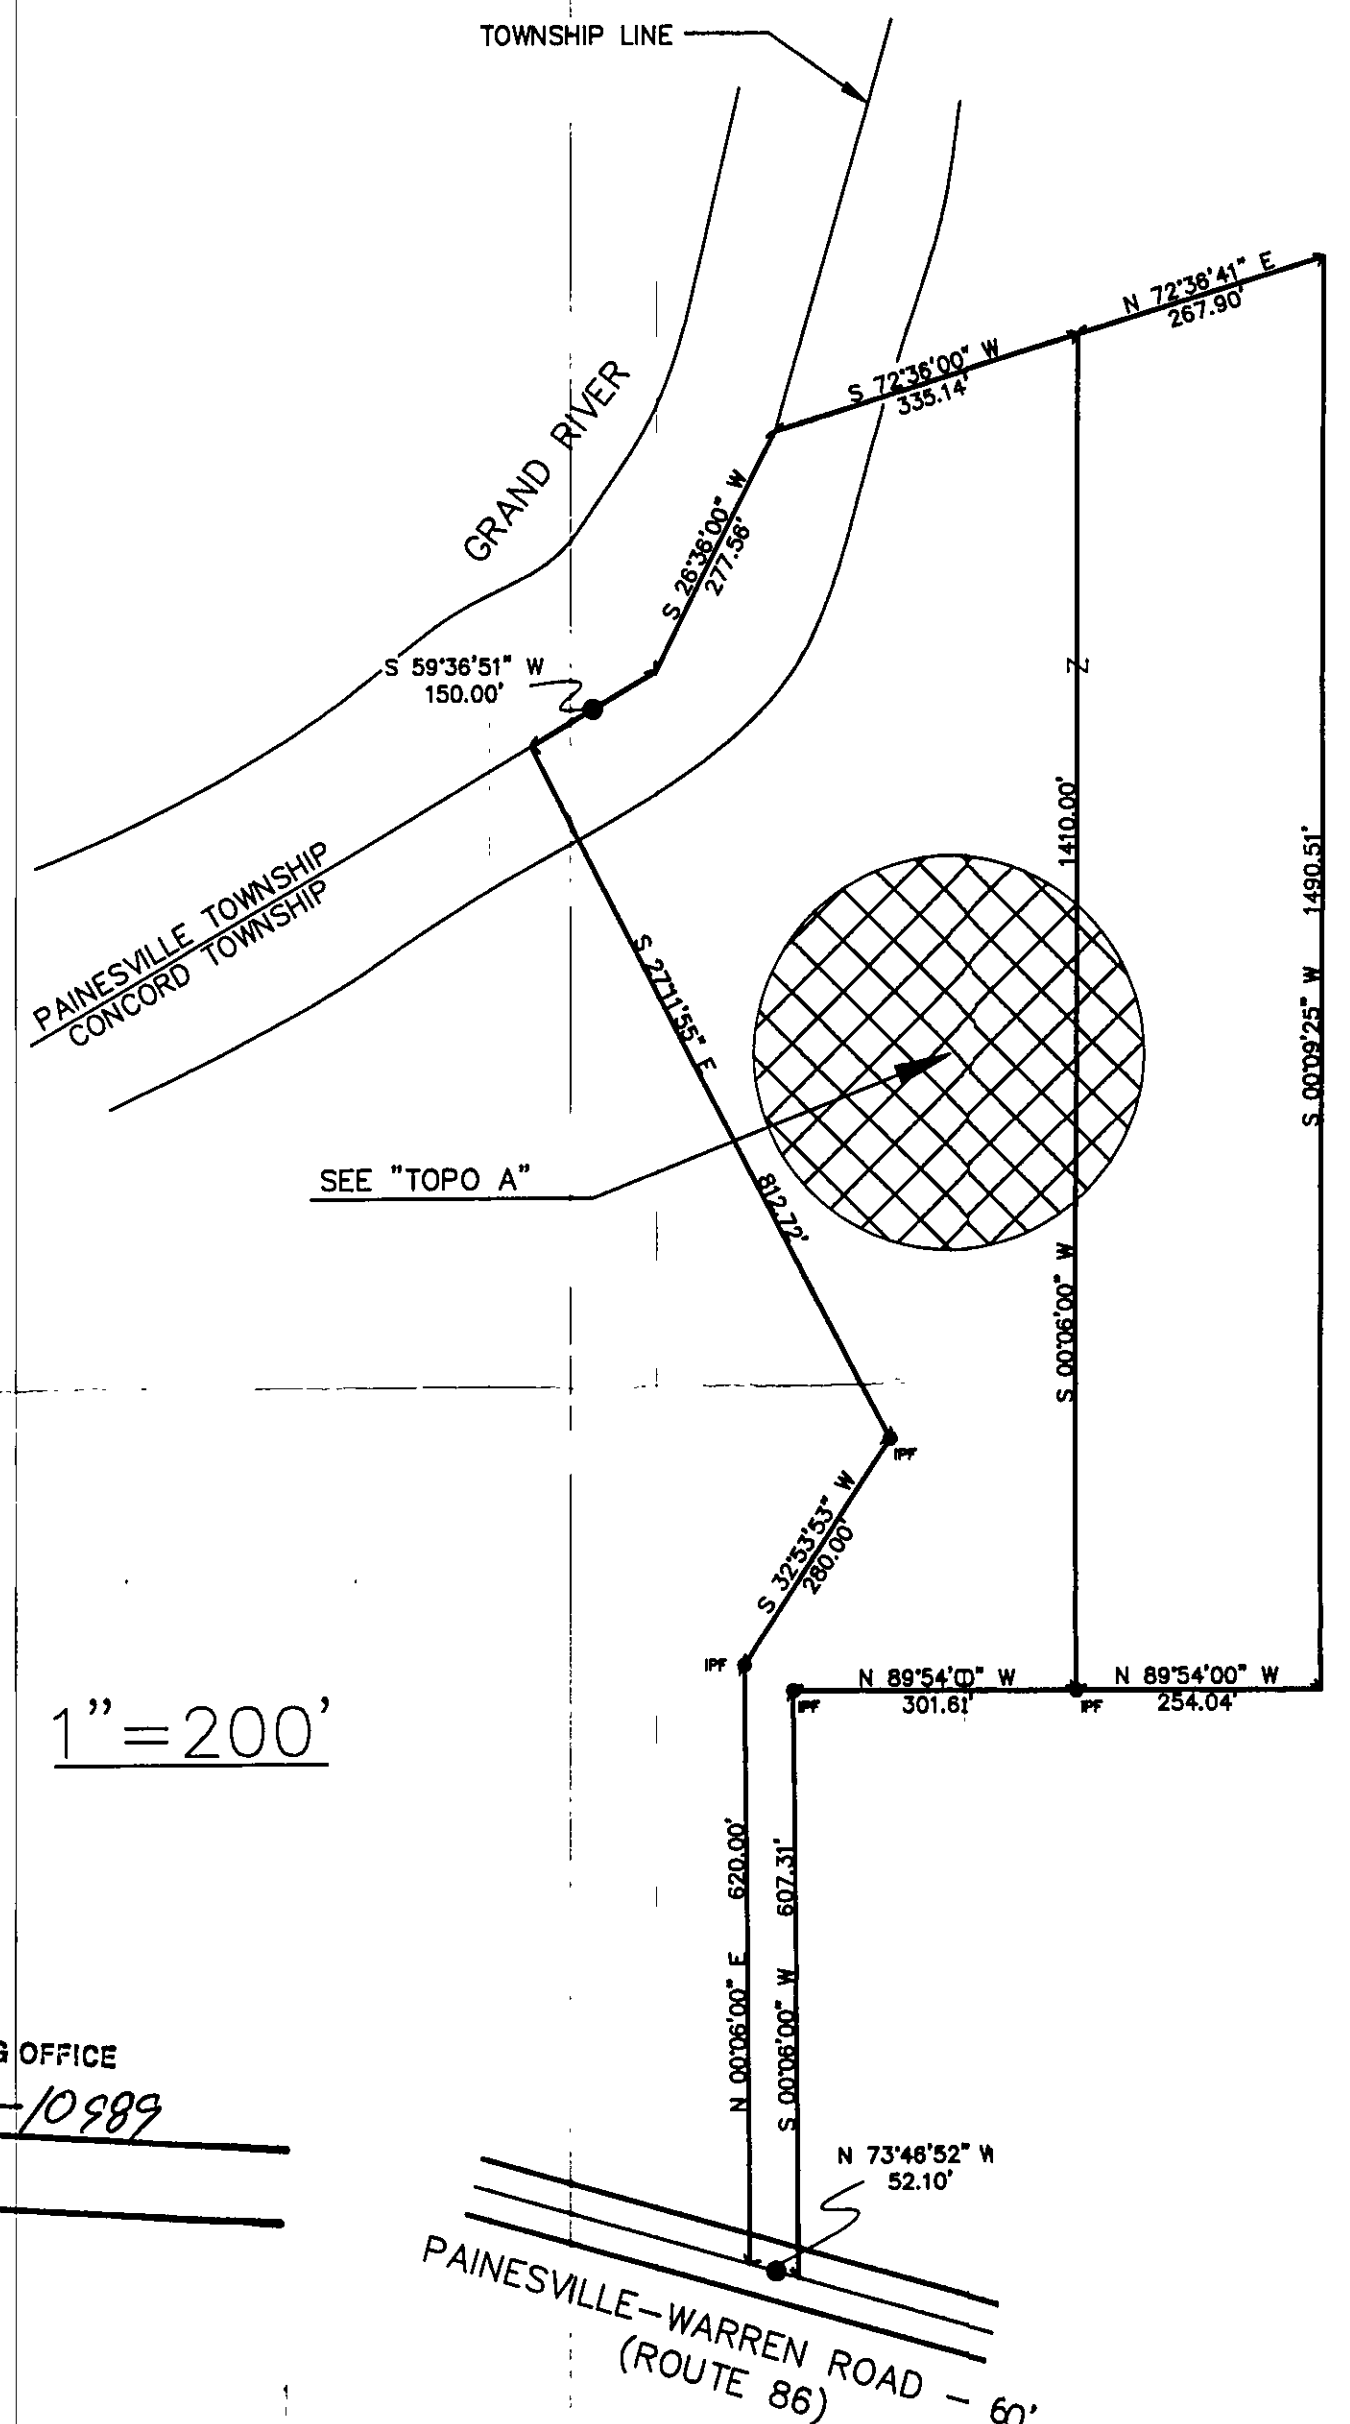



1"=200'

CONCORD TOWNSHIP ZONING OFFICE
ZONING PERMIT # 0903-10989
ISSUED 4/15/03
SUBJECT TO APPROVAL BY:
☒ Lake Co. Zoning Engineer
☒ Lake Co. Eng. Dept.
☒ Lake Co. Planning Comm.
☒ Lake Co. Building Dept.
☒ Lake Co. Soil & Water Cons. Dist.

PAINESVILLE-WARREN ROAD - 60'
(ROUTE 86)

Grading Plan Approved
as shown and/or noted
JAMES R. GILLS, P.E.
Lake County Engineer

By [Signature] Date 4/15/03

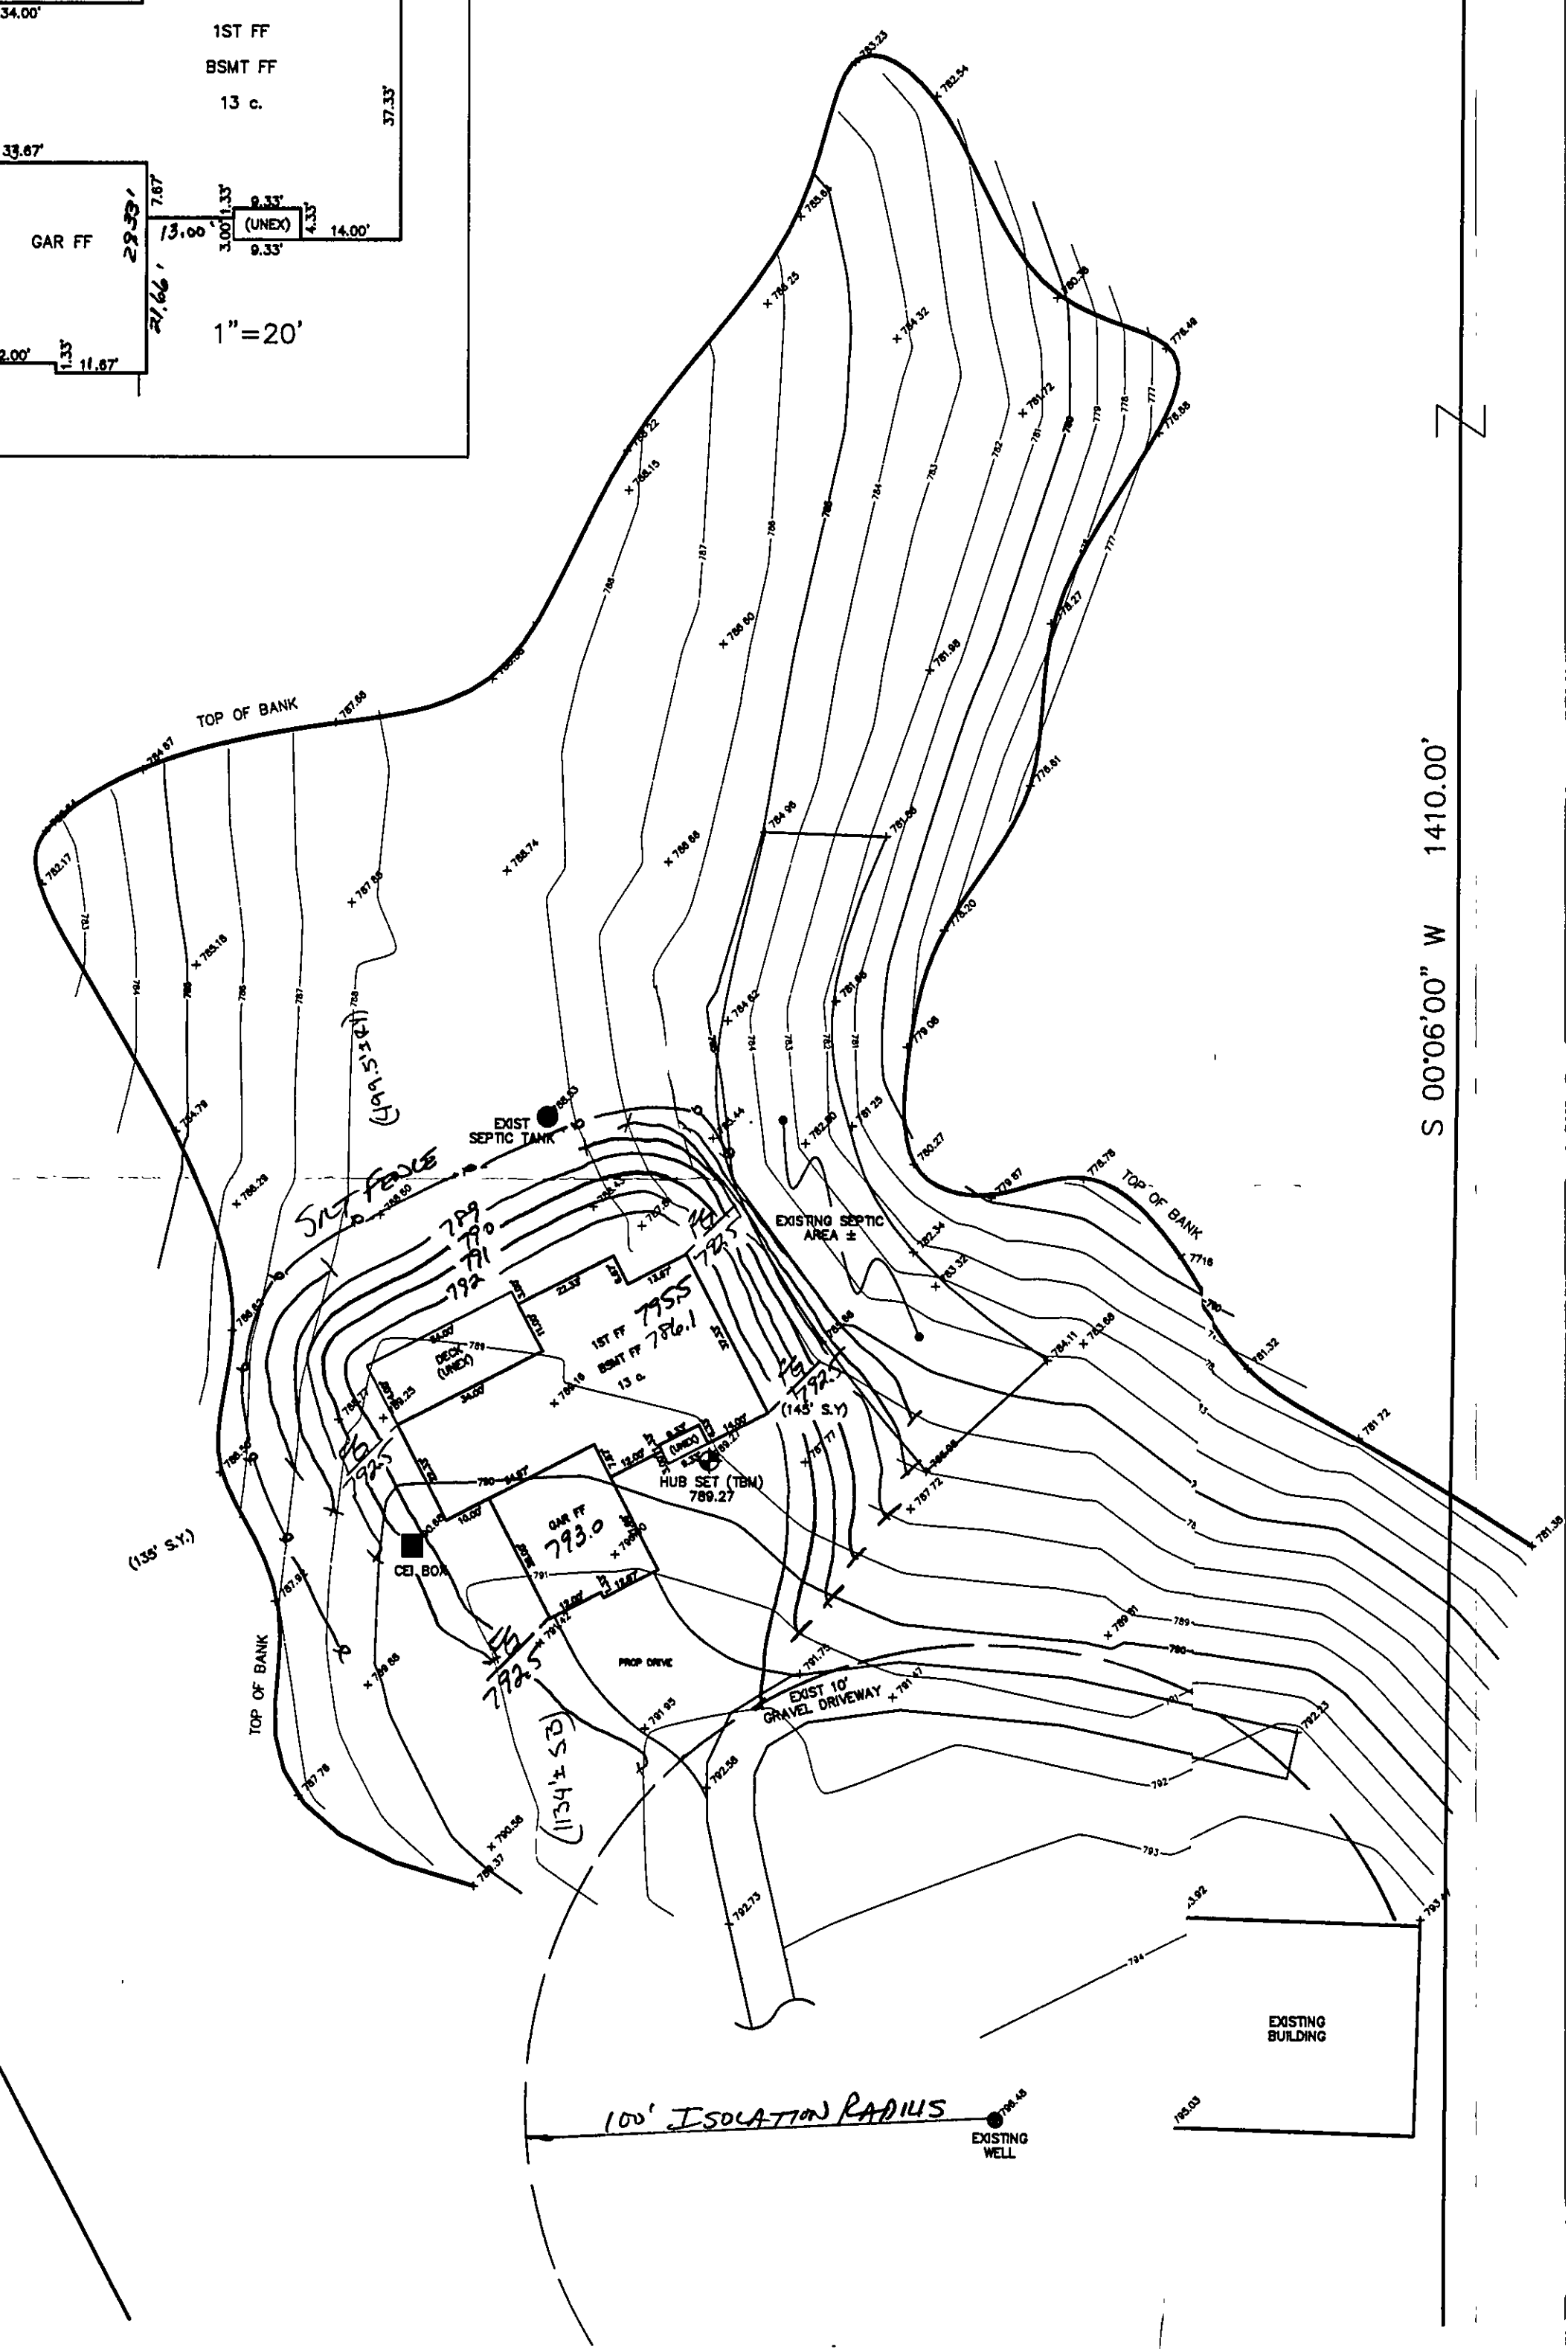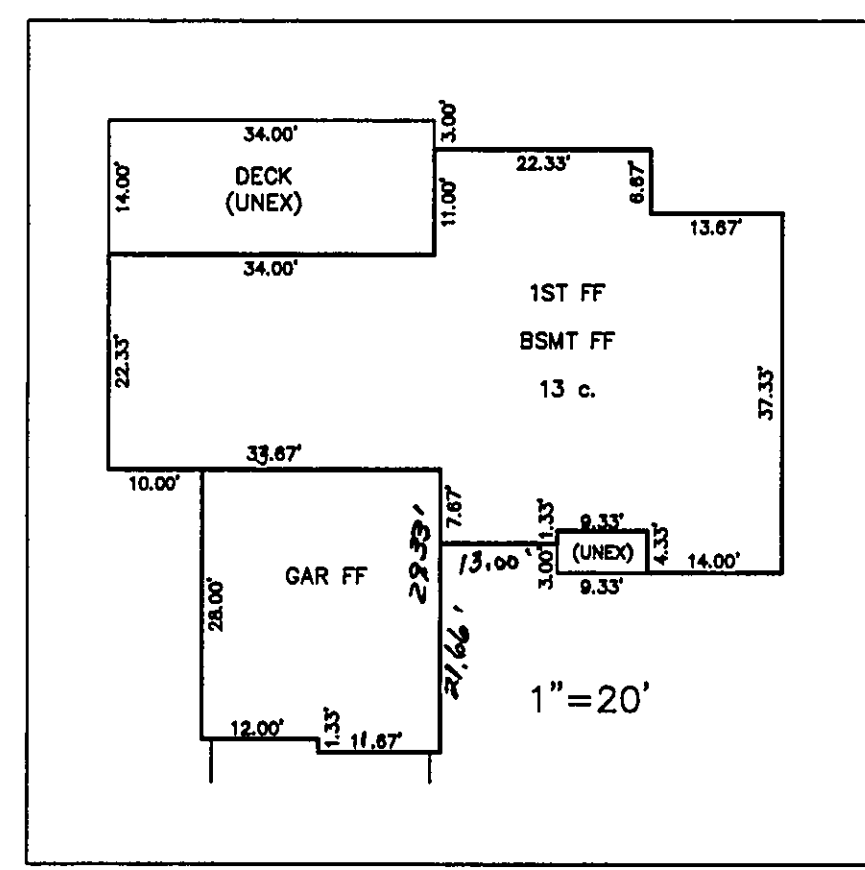


1"=30'

S 00°06'00" W 1410.00'

TBM - HUB SET
ELEV - 789.27

EXISTING UTILITIES NOTE:
THE SIZE AND LOCATION, BOTH HORIZONTAL AND VERTICAL
OF THE UNDERGROUND UTILITIES SHOWN HEREON, HAVE BEEN
OBTAINED BY A SEARCH OF AVAILABLE RECORDS.
WHERE PRACTICAL, HOWEVER, BARCOCK, JONES AND ASSOCIATES
INC. DOES NOT GUARANTEE THE COMPLETENESS NOR ACCURACY
THEREOF.

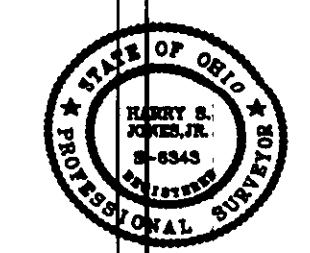

REV. NO.	DESCRIPTION	DATE	BY	CHK'D
1	ADDED HOUSE	3/12/03	B.P.	H.J.

bj BARCOCK, JONES AND ASSOCIATES, INC.
CIVIL ENGINEERS - SURVEYORS - LAND PLANNERS
PAINESVILLE OHIO 44077

DATE	2/7/02
DESIGN BY	H.J.
DRAWN BY	B.P.
APPROVED BY	H.J.
CREW CHIEF	W.B.

SITE PLAN
FOR
JIM LOXTERMAN
11836
PAINESVILLE-WARREN ROAD (S.R.86)
CONCORD TOWNSHIP LAKE COUNTY STATE OF OHIO

SCALE	LFT: 1"=200' RT: 1"=30'
JOB NO.	91-179
SHEET	1
OF	1