

85° 21' 11"
238.11




6.547 Acres





Certification
I certify that the grades were checked on _____ day of _____ 1973 and were found to exist as shown in red here on.
by _____

GRADE PLAN
for
KENNETH J. ROSBOROUGH
Lot 14 TR1 CONCORD TWP
LAKE CO. OHIO
1-30 Nov 1973

Millon A. Egan
Reg. Surveyor # 22

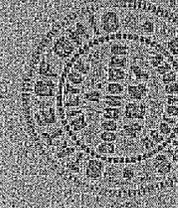

Dugwell

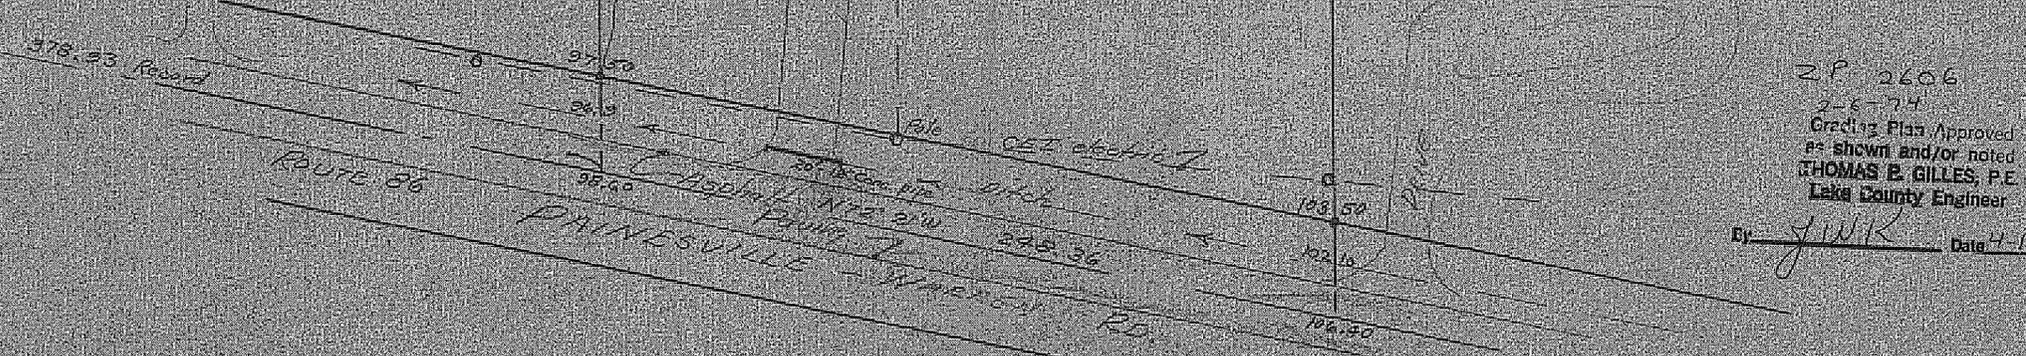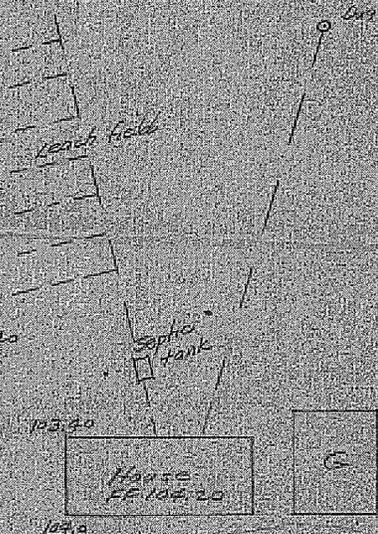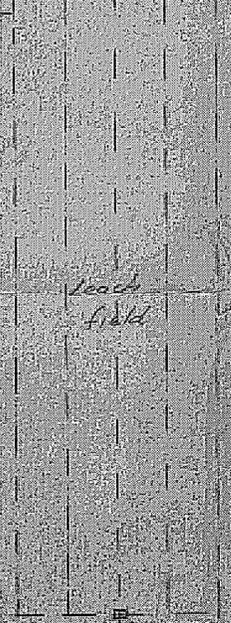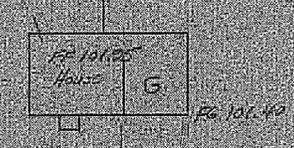

Z.P. 2606
2-6-74
Credit Plan Approved
as shown and/or noted
by **THOMAS B. GILLES, P.E.**
Lake County Engineer
By *JWK* Date *4/1*