

SITE PLAN

Exford Township, Lake County, Ohio

for: SHARON C. KUSTROCK

OWNER

ADDRESS		CITY		ZIP	
STREET		STREET		STREET	
SUBDIVISION	NAME	LOT	TRACT		
VOL. - PG.		VOLUME	PAGE		
SUBLOT NO.	STREET	PERM. PARCEL NO.	STREET		

LEGEND

SANITARY MANHOLE	WATER VALVE (GAS)
STORM MANHOLE	WATER METER (GAS)
INLET OR CATCH BASIN	AS BUILT ELEVATION
HYDRANT	INDICATES DIRECTION OF SURFACE DRAINAGE
EXISTING CONTOURS	
PROPOSED CONTOURS	
EXIST. ELEV.	PROP. ELEV.

REMARKS

ALL BOUNDARY DATA SHOWN WAS OBTAINED FROM IDEEDS, RECORDED SUBDIVISION PLAT OR OTHER PUBLIC RECORDS.
LOCATIONS AS SHOWN OF ADJACENT WELLS AND SEPTIC TANKS OBTAINED FROM LAKE COUNTY HEALTH DEPARTMENT

DESIGN CERTIFICATION

THIS PLAT WAS PREPARED BY ME, AND IS CORRECT TO THE BEST OF MY KNOWLEDGE AND BELIEF.

NAME	SURVEYOR	REGISTRATION NO.
CHECK LIST		

NO. OF BEDROOMS	WATER MAIN SIZE, LOCATION
BATHS	SAN. SEWER SIZE & GR. LOC.
DIMENSIONS	SAN. IN. CAST ELEV. INV. ELEV.
THE TO NEAREST STREET	SAN. CORR. SIZE, LOC. DEPTH
SUBLOT NO. PARCEL NO.	STORM SEWER SIZE & GR. LOC.
SURROUNDING OWNERS	STORM IN. CAST ELEV. INV. ELEV.
BLDG. DIMENSIONS FIN. GR.	PAV'T TYPE GRADE CURBS
PAV'T TYPE GRADES	SEPTIC TANK LOCATION & DIMENSION AREA
SEPTIC TANK LOCATION & DIMENSION AREA	WELL LOCATION
ISOLATION RADIUS FROM WELL	

NO. OF BEDROOMS	WATER MAIN SIZE, LOCATION
BATHS	SAN. SEWER SIZE & GR. LOC.
DIMENSIONS	SAN. IN. CAST ELEV. INV. ELEV.
THE TO NEAREST STREET	SAN. CORR. SIZE, LOC. DEPTH
SUBLOT NO. PARCEL NO.	STORM SEWER SIZE & GR. LOC.
SURROUNDING OWNERS	STORM IN. CAST ELEV. INV. ELEV.
BLDG. DIMENSIONS FIN. GR.	PAV'T TYPE GRADE CURBS
PAV'T TYPE GRADES	SEPTIC TANK LOCATION & DIMENSION AREA
SEPTIC TANK LOCATION & DIMENSION AREA	WELL LOCATION
ISOLATION RADIUS FROM WELL	

PLAN PREPARED BY:
BABCOCK & JONES & ASSOCIATES, INC.
PAINESVILLE, OHIO

NO.	DATE	BY	SCALE	PHONE NO.
1	10-2-90	HT	1" = 30'	357-1811
2				
3				
4				
5				

"AS BUILT" CERTIFICATION

HEREBY CERTIFY THAT THE CIRCLED GRADES ARE EXISTING AND ARE CORRECT TO THE BEST OF MY KNOWLEDGE AND BELIEF.

REGISTERED SURVEYOR	REG. NO.
---------------------	----------

THOMAS P. GILLES, P.E.
6700 - 77400

the undersigned hereby certify that this topography indicated by 6', 1' or 2' contours and elevations shown hereon represent an actual field survey made by me on the 10-2-90, and that the elevations were taken at appropriate intervals and that as of that date they existed as indicated hereon.

Reviewed and Accepted

LAKE COUNTY GENERAL HEALTH DISTRICT

Date: 10-3-90

JOEL LUCIA, R.S., M.P.H.
Health Commissioner

BY: Sharon C. Kustrock

- To be brought to finished grade
- Septic tank manhole covers
- Splitter box cover
- Distribution box cover
- No footer drains or downspouts to be discharged into septic tanks
- All waste water to be discharged into septic tanks

SEWAGE DISPOSAL PERMIT MUST BE OBTAINED BY A LAKE COUNTY LICENSED INSTALLER BEFORE INSTALLATION IS


STARTED

12-1-90



HYDRAULIC PROFILE

SCALE: HORIZ. 1"=30'

DOWN HILL REQUIRED
ON ALL
FIXTURES REQUIRED
TOILET
Stooper Head

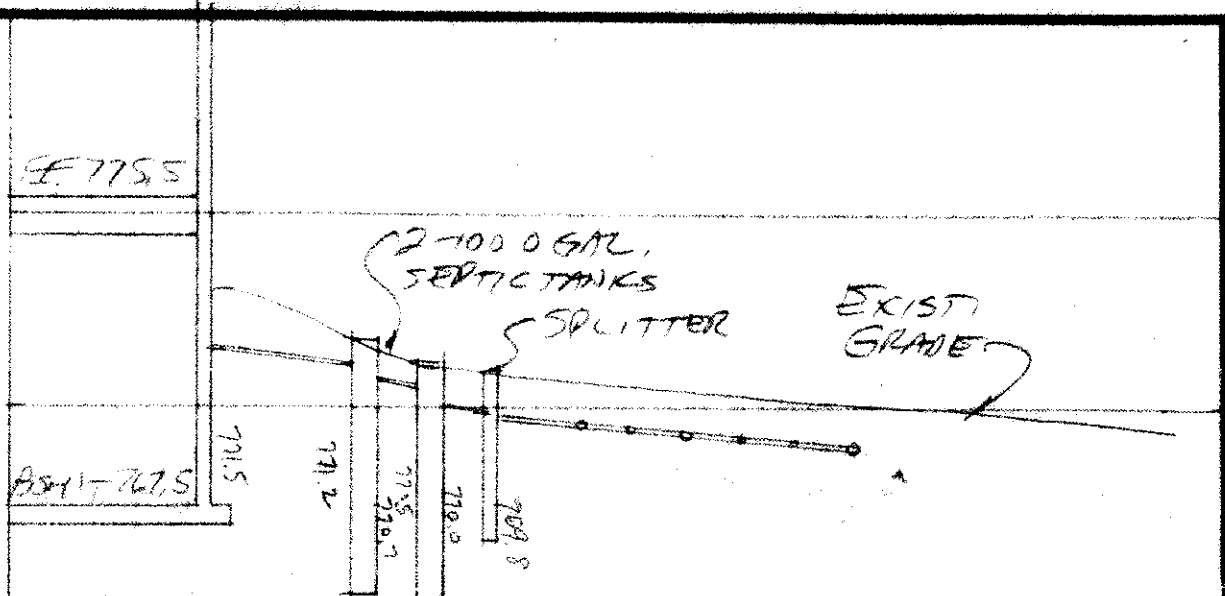

775
770

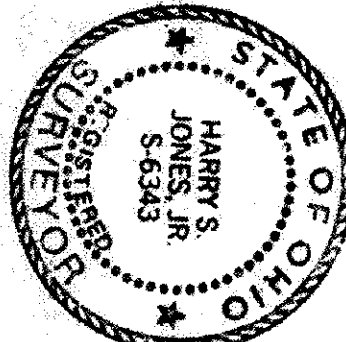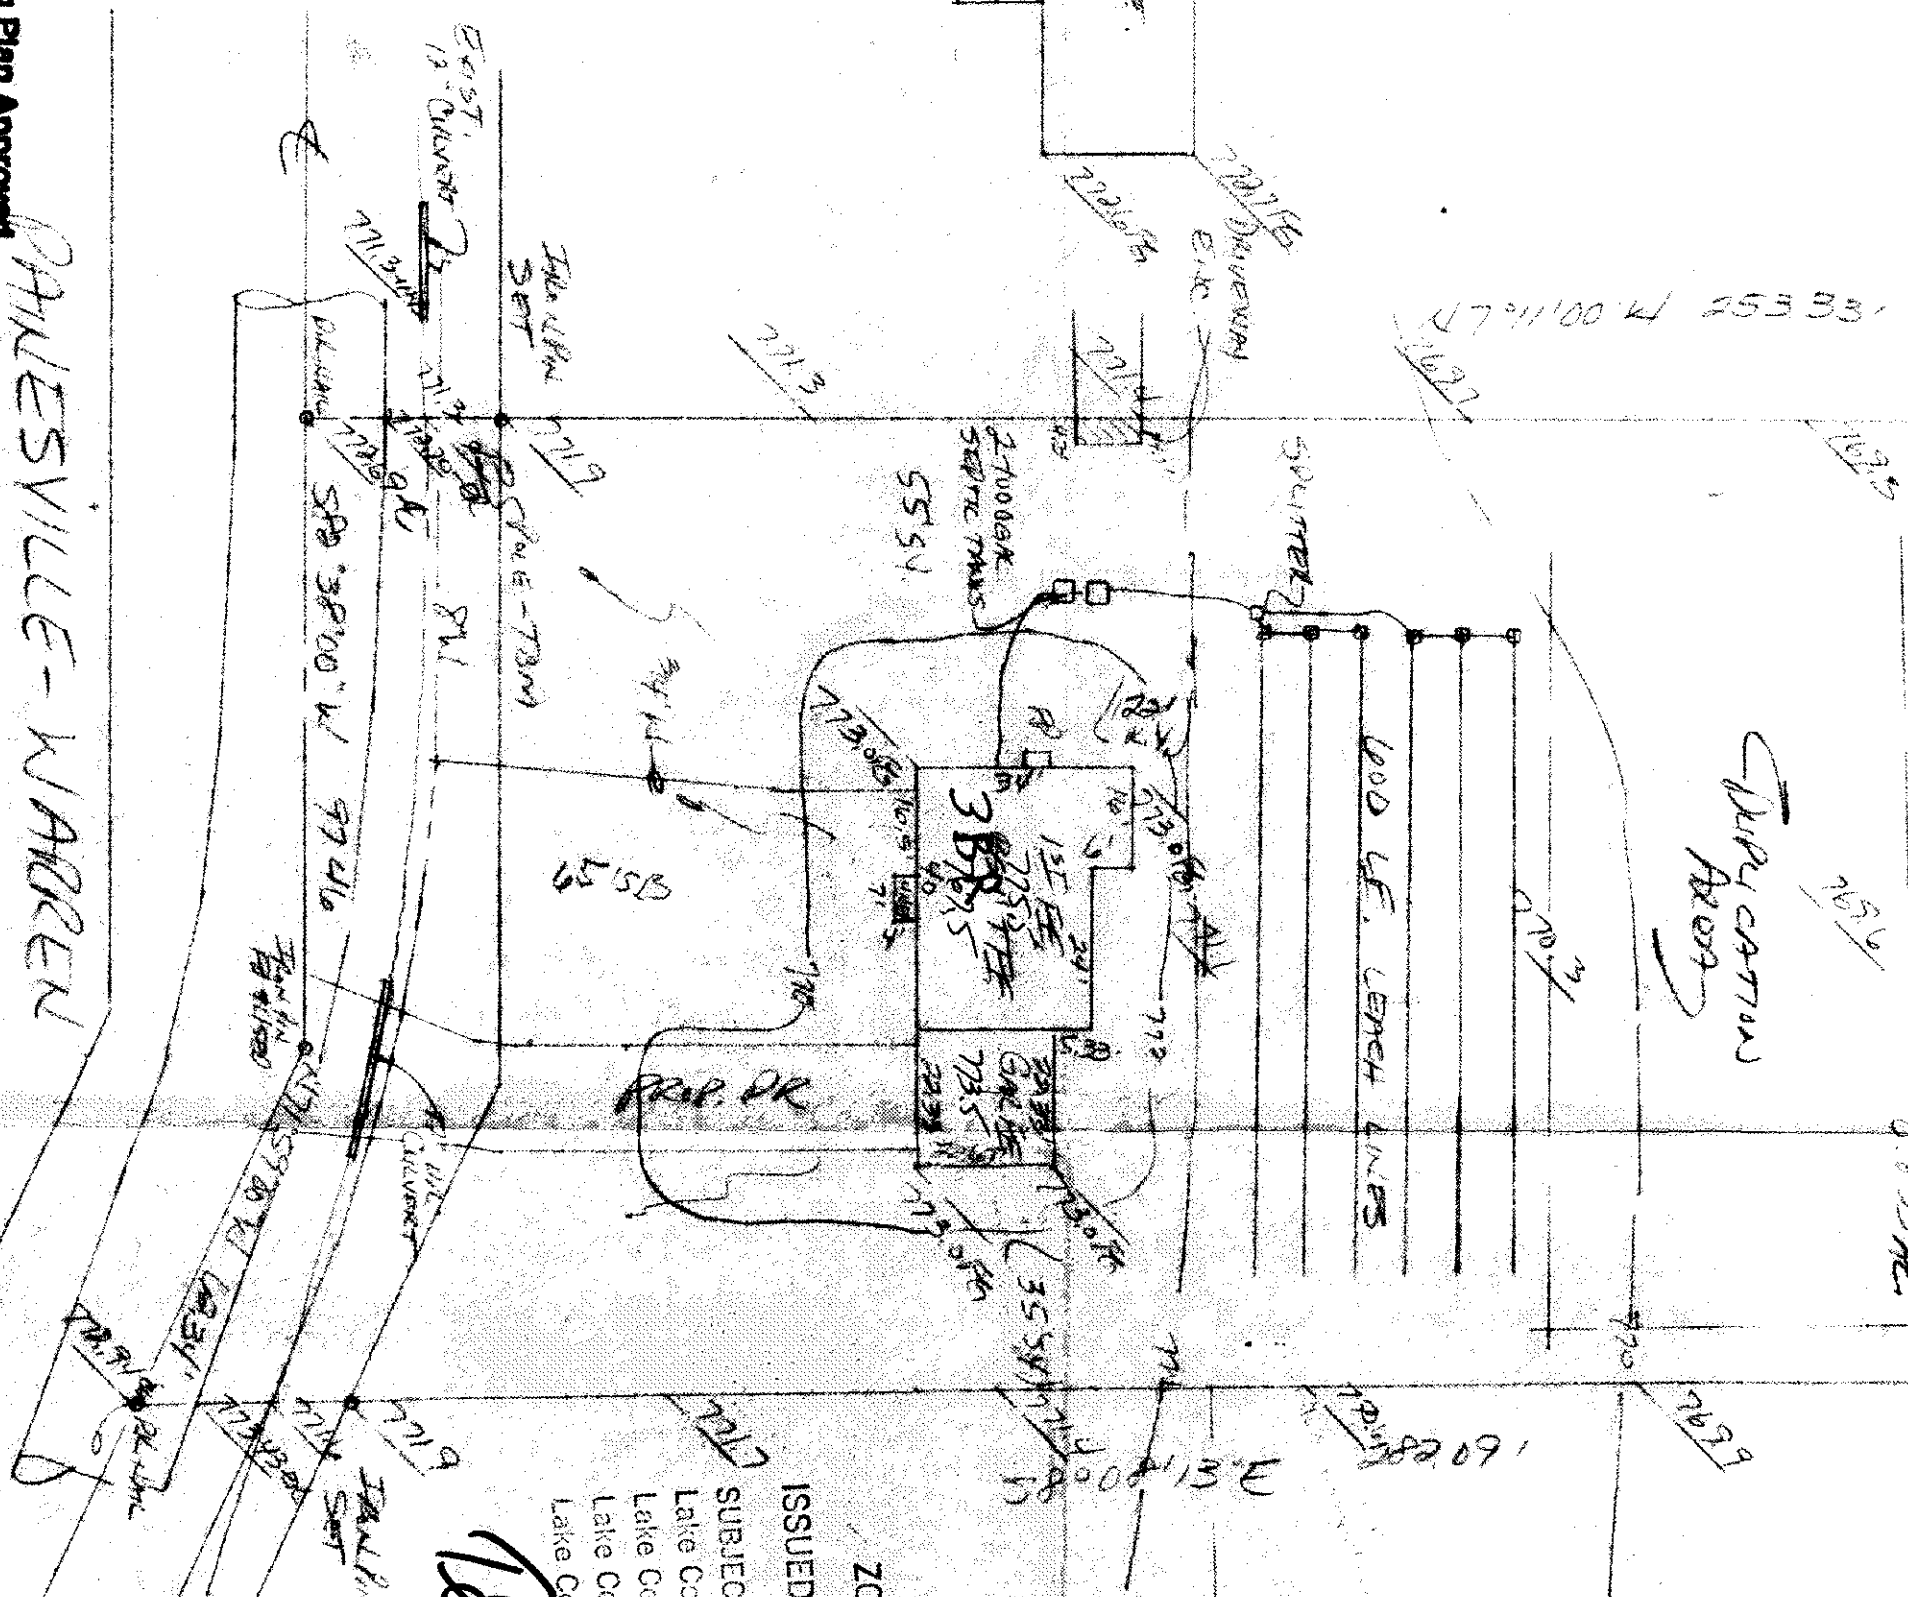

#6627

ZONING PERMIT

ISSUED 10-5-90

SUBJECT TO APPROVAL BY:

- ☐ Lake County Sanitary Eng.
- ☒ Lake County Eng. Dept.
- ☐ Lake County Planning Comm.
- ☒ Lake County Bldg. Dept.

THOMAS P. GILLES, P.E.

PAINESVILLE - WARREN

10000-60

Grading Plan Approved
as shown and/or noted
THOMAS P. GILLES, P.E.
Lake County Engineer

Date 10/10/90

1. A DOT PERMIT REQUIRED