


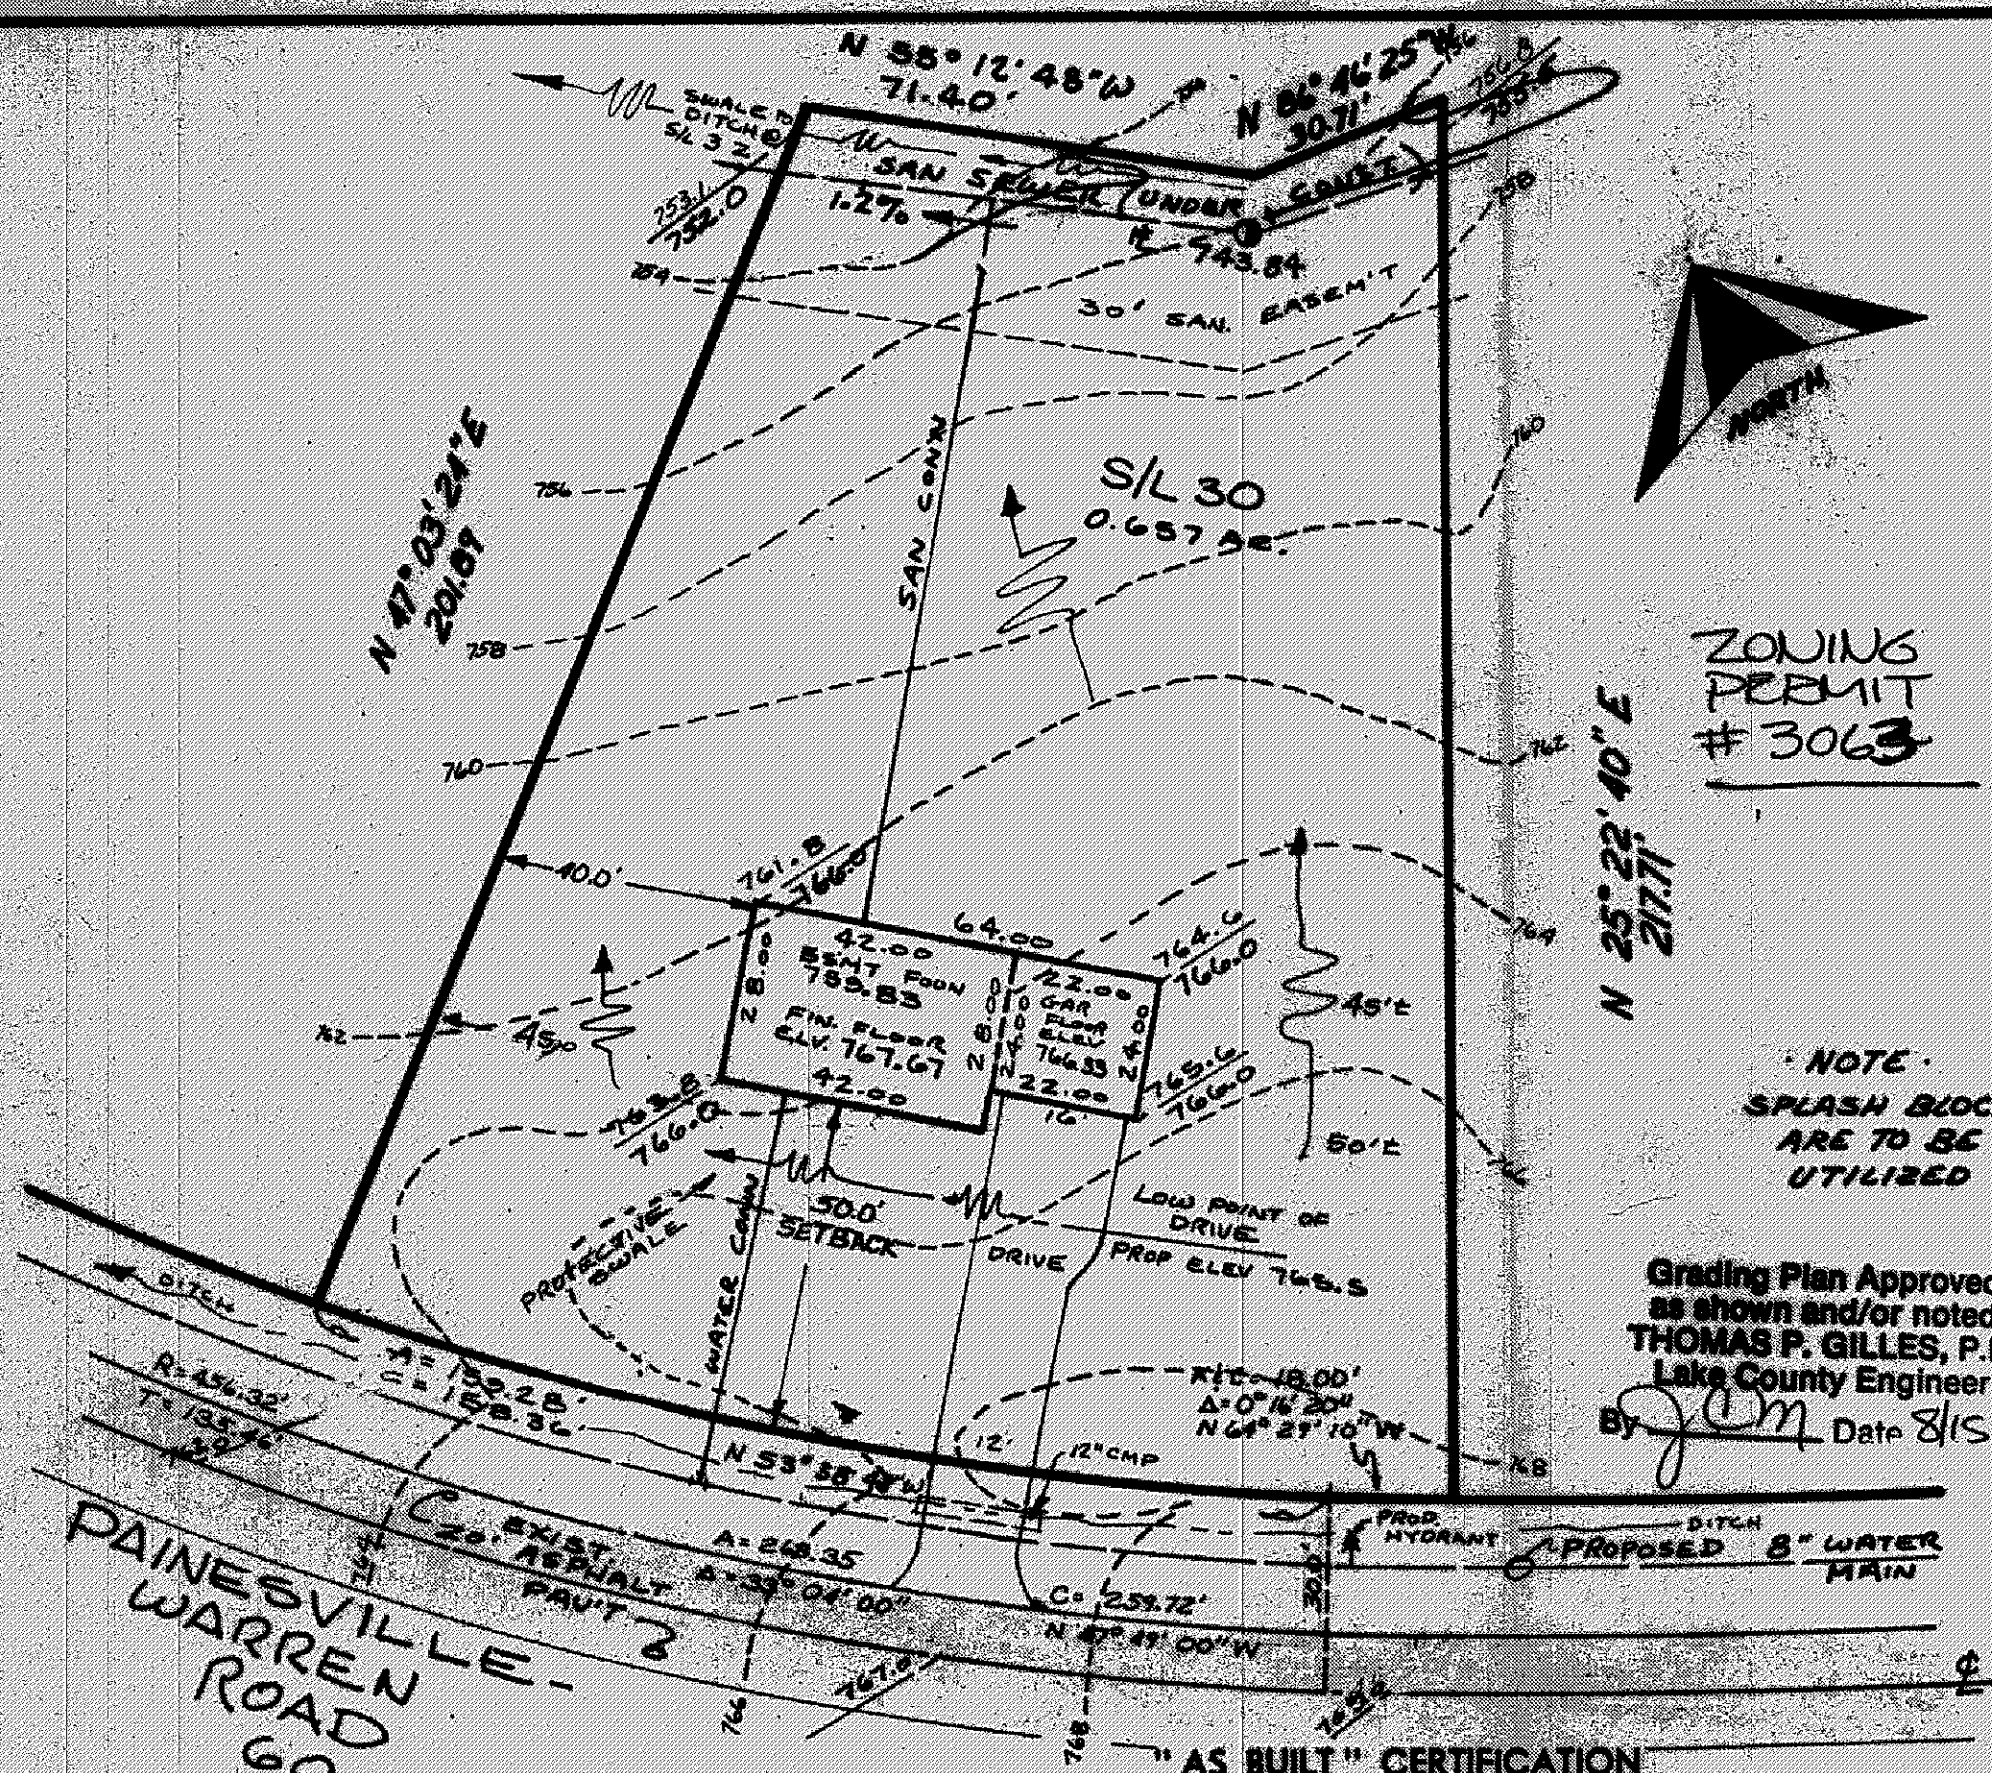

SITE PLAN

CONCORD TOWNSHIP **LAKE COUNTY, OHIO**

for: RYAN HOMES INC

CLIENT OWNER

ADDRESS		STREET		CITY		ZIP	
RIO GRANDE		V. 15		NAME			
30		VOL. - PG.		Rte 86			
SUBLOT NO.		STREET		PERM. PARCEL NO.		STREET	

LEGEND	
SANITARY MANHOLE	---
STORM MANHOLE	---
INLET OR CATCH BASIN	---
HYDRANT	---
EXISTING CONTOURS	---
PROPOSED CONTOURS	---
EXIST. ELEV.	100.0
PROF. ELEV.	100.0
WATER VALVE (GAS)	---
WATER METER (GAS)	---
AS BUILT ELEVATION	---
INDICATES DIRECTION OF SURFACE DRAINAGE	---

REMARKS

ALL BOUNDARY DATA SHOWN WAS OBTAINED FROM (DEEDS, RECORDED SUBDIVISION PLAT OR OTHER PUBLIC RECORDS)

LOCATIONS AS SHOWN OF ADJACENT WELLS AND SEPTIC TANKS OBTAINED FROM LAKE COUNTY HEALTH DEPARTMENT

DESIGN CERTIFICATION

THIS PLAN WAS PREPARED BY ME, AND IS CORRECT TO THE BEST OF MY KNOWLEDGE AND BELIEF.

NAME: Richard J. Debevec SURVEYOR REGISTRATION NO. PS # 5244

CHECK LIST	
NO. OF BEDROOMS	WATER MAIN SIZE, LOCATION
DIMENSIONS	SAN. SEWER SIZE & GR. LOC.
BEARINGS	SAN. MH. CAST. ELEV. INV. ELEV.
TIE TO NEAREST STREET	SAN. CONN. SIZE, LOC. DEPTH
SUBLOT NO. PARCEL NO.	STORM MH. CAST. ELEV. INV. ELEV.
SURROUNDING OWNERS	PAV'TY TYPE GRADE CURBS
BLDG. DIMENSIONS FIN. GR.	GAS LINE LOC. SIZE PRESSURE
BLOG. TIES FLTR. GRADES	SEPTIC TANK LOCATION & DUPLICATION AREA
APRON TYPE WIDTH THICKNESS	WELL LOCATION
SIDEWALK TYPE WIDTH THICKNESS	ISOLATION RADIUS FROM WELL
CULVERT TYPE DIA. LENGTH	
ROCK OUTCROPPINGS	

REVISIONS			PLAN PREPARED BY:	
NO.	DATE	BY	DEBEVEC - SALO & ASSOCIATES, INC.	
1	11-22-76	AK	130 EAST JACKSON ST. PAINESVILLE, OHIO	
2				
3			DRAWN BY <u>LRA</u>	SCALE <u>1"=30'</u>
4			CHK'D. <u>UJB</u>	DATE <u>7-8-76</u>
5			CREW CHIEF	PHONE NO.
			DRAWING NO. <u>4701-30</u>	

"AS BUILT" CERTIFICATION

I, HEREBY CERTIFY THAT THE CIRCLED GRADES ARE EXISTING FINISH GRADES CHECKED IN FIELD ON 19 BY SURVEYING AND ARE CORRECT TO THE BEST OF MY KNOWLEDGE AND BELIEF.

REGISTERED SURVEYOR REG. NO.