


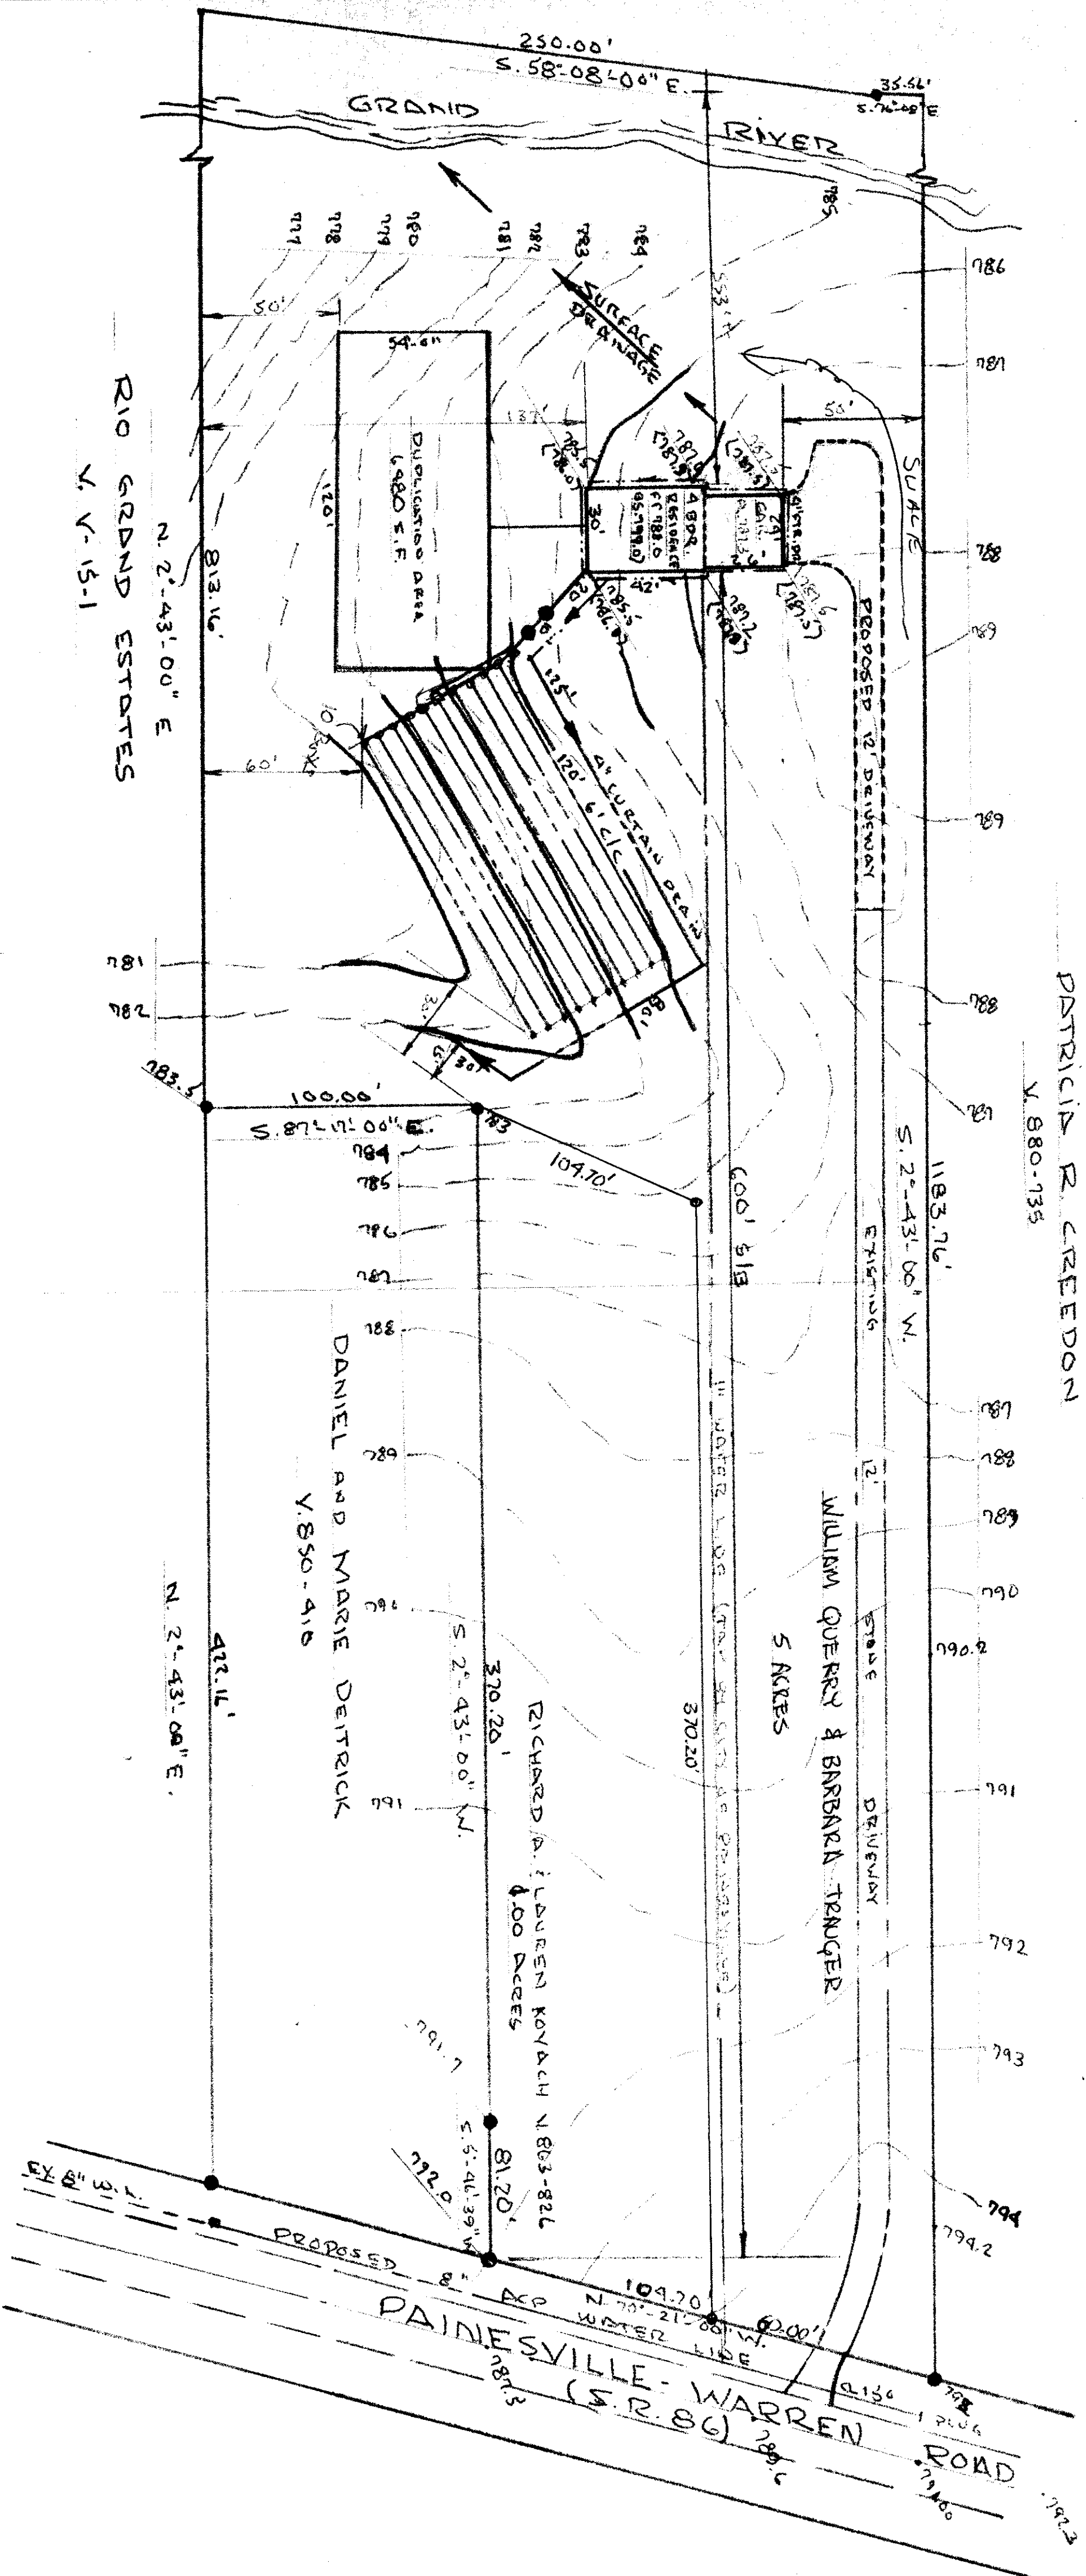

PATRICIA R. CREEDON
V. 880-135

WILLIAM QUERRY & BARBARA TRANGER
5 ACRES

DANIEL AND MARIE DETTRICK
V. 850-418


RICHARD A. & LAUREN KOVACH N 863-826
4.00 ACRES

EXISTING CONTOUR
PROPOSED CONTOUR
EXIST. GR. 785
PROG. GR. 7867
NOTE: CONDUCT FASTER DRAINS AND DOWNSLOUTS
TO CURTAIN DRAIN.

Reviewed and Accepted
LAKE COUNTY GENERAL HEALTH DISTRICT
Date 5-22-84
JOEL LUDA, R.S., M.P.H.
Health Commissioner

SEWAGE DISPOSAL PERMIT MUST BE
OBTAINED BY A LAKE COUNTY LICENSED
INSTALLER BEFORE INSTALLATION IS
STARTED.

Grading Plan Approved
as shown and/or noted
THOMAS P. GILLES, P.E.
Lake County Engineer

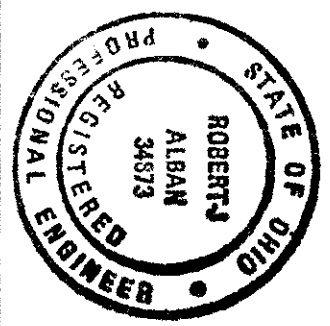

ZONING PERMIT #4842
ISSUED 5-22-84
SUBJECT TO APPROVAL BY:
Lake County Sanitary Eng. ☐
Lake County Eng. Dept. ☒
Lake County Planning Comm. ☐
Lake County Bldg. Dept. ☒
Timo J. Marano

QUERY SITE PLAN	
SCALE 1:40	APPROVED BY
DATE 5/17/84	DRAWN BY
CONCORD TWP., LAKE COUNTY, OHIO	
PERM. PARCEL 8A-11-23	
DRAWING NUMBER	