
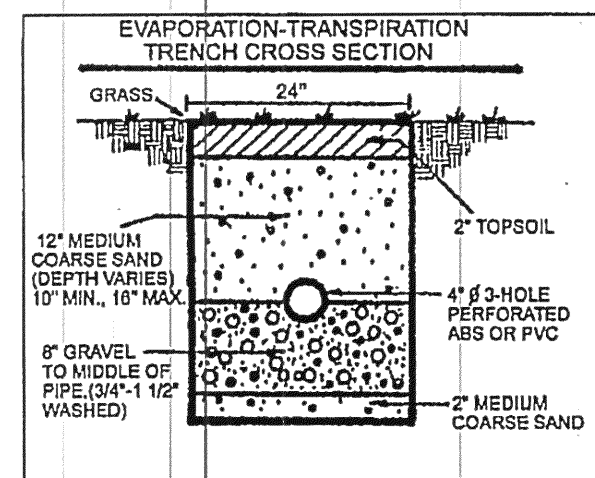


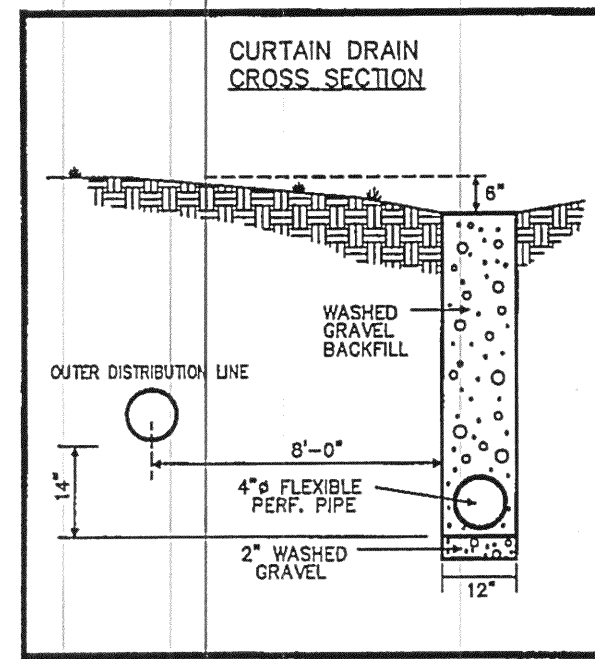

CONCORD TOWNSHIP ZONING OFFICE
ZONING PERMIT # 0502-10604
ISSUED 5/30/2002
SUBMITTED TO APPROVAL BY:
☐ Lake Co. Eng. Dept.
☒ Lake Co. Planning Comm.
☒ Lake Co. Building Dept.
☒ Lake Co. Soil & Water Cons. Dist.

PARCEL #6

PARCEL #2
7.059 AC.

PARCEL #3

PARCEL #5

PARCEL "B"

PARCEL "A"
0.1168 AC.

PARCEL #1

DATE: 100 YEAR FLOOD
ZONE = 623.5

Grading Plan Approved
as shown and/or noted
JAMES R. GILLS, P.E.
Lako County Engineer

By 6/1/02 Date 6/1/02
rest to road


"I, the undersigned hereby certify that
this topography indicated by 6", 1", or 2"
contours, and elevations shown hereon
represent an actual field survey made by
me on the 13th day of JULY, 2001
and that the elevations were taken at
appropriate intervals and that as of that
date they existed as indicated hereon."

Name Harry Jones Reg. No. #6343

REVIEWED AND ACCEPTED
LAKE COUNTY GENERAL
HEALTH DISTRICT

DATE 1-16-01 BY DJL

LAKE COUNTY DISTRICT MUST BE
OBTAINED BY LAKE COUNTY DISTRICT
HEALTH DEPT. BEFORE INSTALLATION OF
SEWAGE TREATMENT PLANT

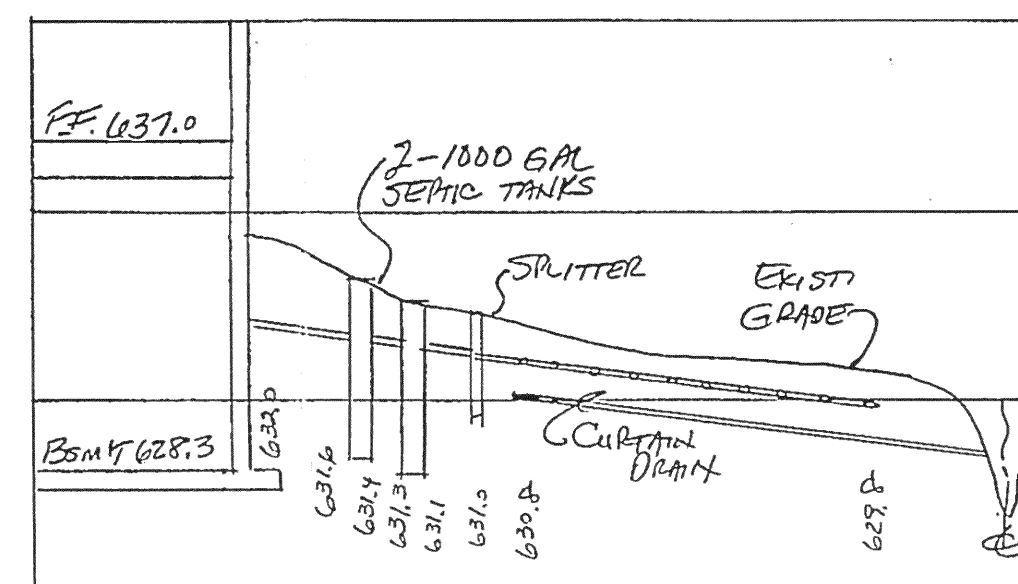


REV. NO.	DESCRIPTION	DATE	BY	CHK'D
1	REVISED HOUSE & SEPTIC	12/28/01	HT	HT



BABCOCK, JONES AND ASSOCIATES, INC
CIVIL ENGINEERS - SURVEYORS - LAND PLANNERS
PAINESVILLE OHIO 44077

DATE	7/16/01
DESIGN BY	H.J.
DRAWN BY	T.R.
APPROVED BY	H.J.

SITE PLAN
FOR
JOHN BOWSER
PARCEL #2 PAINESVILLE WARREN ROAD
CONCORD TOWNSHIP LAKE COUNTY

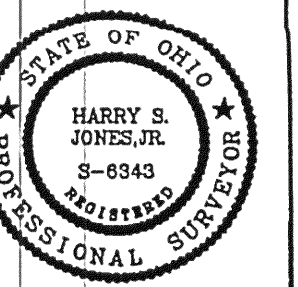

SCALE:	1"=30'
JOB NO.	98-334-02
SHEET	1 OF 1